



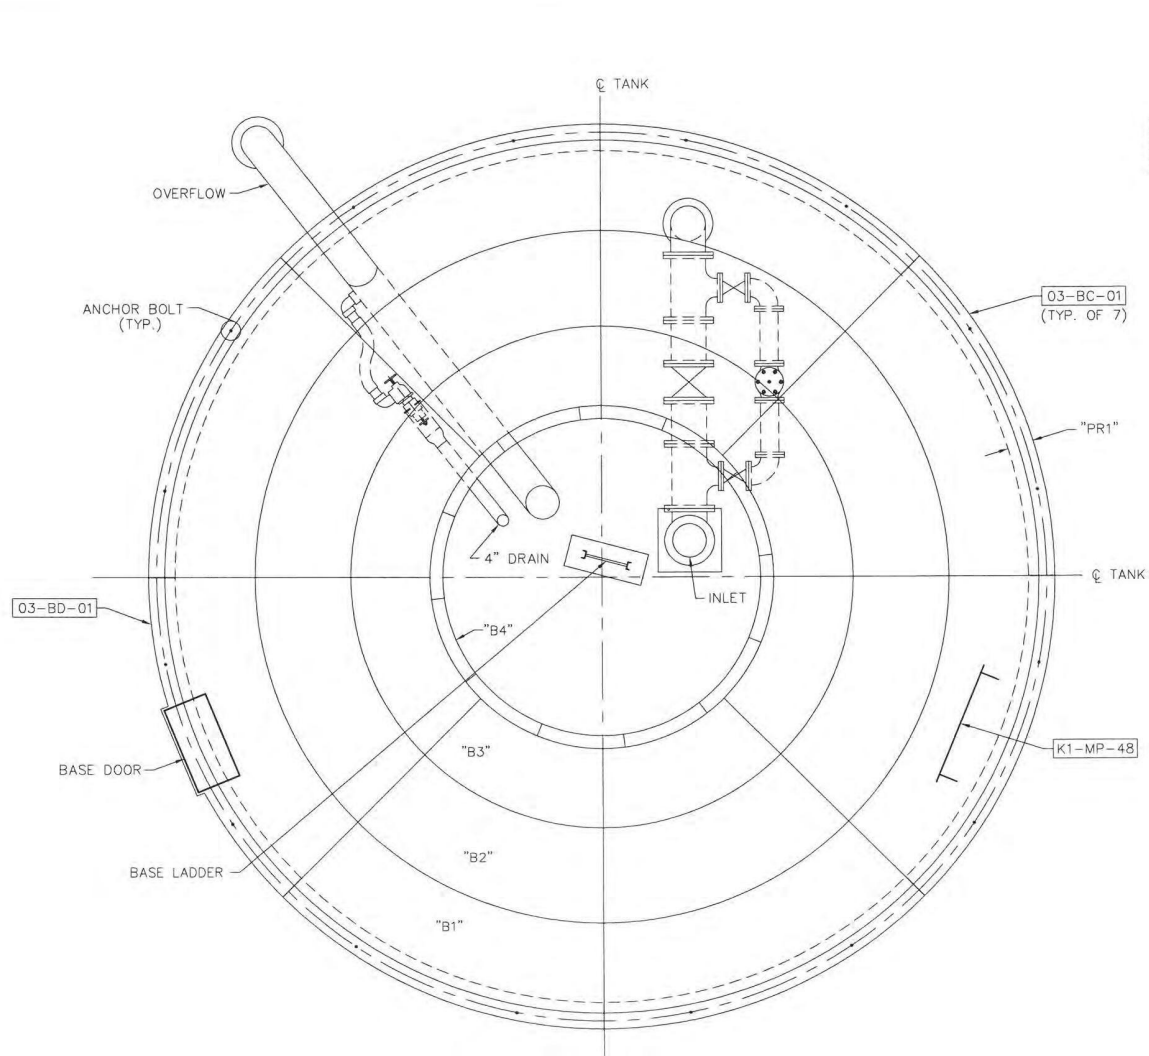

BASE CONE ORIENTATION
(SEE DWG. 18 FOR ELECTRICAL CLIP DETAILS)

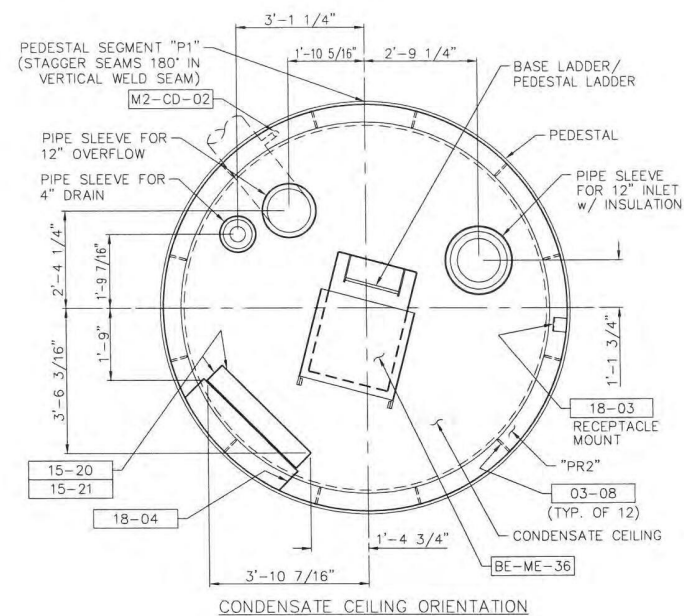

AS-BUILT

		REV.	BY:	DATE	REMARKS
CALDWELL Since 1897 Water - Energy - Industrial		FRANKLIN COUNTY, VIRGINIA 500,000 GALLON PEDESHERE			
BY: TSY DATE: 12/13/19		TITLE: ORIENTATION DETAILS DRAWING NO.: E-8884 02A			