


SYMBOL	"B1" DIMENSIONS 04-01	"B2" DIMENSIONS 04-02	"B3" DIMENSIONS 04-03	"B4" DIMENSIONS 04-04
"T"	9/16"	11/16"	13/16"	27/32"
"DIM-1"	10'-9 1/4"	8'-6 15/32"	6'-2 1/8"	N/A
"DIM-2"	10'-8 15/16"	8'-6 7/32"	6'-1 15/16"	2'-9 3/4"
"DIM-3"	4"	3 3/16"	2 9/32"	N/A
"DIM-4"	8'-6 9/32"	6'-2"	4'-2 15/32"	2'-7 1/8"
"DIM-5"	3 3/16"	2 9/32"	1 9/16"	N/A
"DIM-6"	8'-6 9/16"	6'-2 3/16"	4'-2 19/32"	N/A
"DIM-7"	34'-5 13/32"	24'-11 1/4"	17'-0 7/32"	N/A
"DIM-8"	8'-11 17/32"	9'-5 27/32"	7'-10 3/4"	2'-6 5/8"
"DIM-9"	43'-4 15/16"	34'-5 3/32"	24'-10 15/16"	N/A
"DIM-10"	10'-6 5/32"	8'-4 1/8"	6'-0 17/32"	N/A
"DIM-11"	19'-5 1/4"	15'-5 1/8"	11'-2 5/32"	N/A
"DIM-12"	25'-4 27/32"	20'-1 15/16"	14'-7 11/32"	N/A
"DIM-13"	27'-6"	21'-9 29/32"	15'-9 27/32"	N/A
"DIM-14"	10'-9 15/32"	8'-6 23/32"	6'-2 7/16"	N/A
"DIM-15"	8'-6 3/4"	6'-2 15/32"	4'-2 29/32"	N/A
"DIM-16"	8'-4 5/32"	6'-0 9/16"	4'-1 19/32"	N/A
"DIM-17"	15'-5 3/16"	11'-2 7/32"	7'-7 25/32"	N/A
"DIM-18"	20'-2"	14'-7 13/32"	10'-0"	N/A
"DIM-19"	21'-10"	15'-9 29/32"	10'-9 15/16"	N/A
"DIM-20"	13'-9"	10'-10 31/32"	7'-10 29/32"	5'-4 15/16"
"DIM-21"	14'-5 3/8"	11'-5 11/32"	8'-3 1/4"	N/A
"DIM-22"	10'-11"	7'-10 31/32"	5'-4 31/32"	5'-0"
"DIM-23"	11'-5 17/32"	8'-3 13/32"	5'-7 21/32"	N/A
"DIM-24"	8'-6"	9'-0"	7'-5 7/8"	2'-6 3/8"
SHOP INFORMATION				
NO. SEGM. REQ'D	8	8	8	12
SEGM. WT.	1,990	1,965	1,365	240
VERT EDGE	DETAIL "B"	DETAIL "B"	DETAIL "B"	DETAIL "A"
SM. END	DETAIL "B"	DETAIL "B"	NO BEVEL	NO BEVEL
LG. END	NO BEVEL	DETAIL "B"	DETAIL "B"	DETAIL "C"





NOTE:

SEE DRAWING 03 FOR SHIPPING INFORMATION.

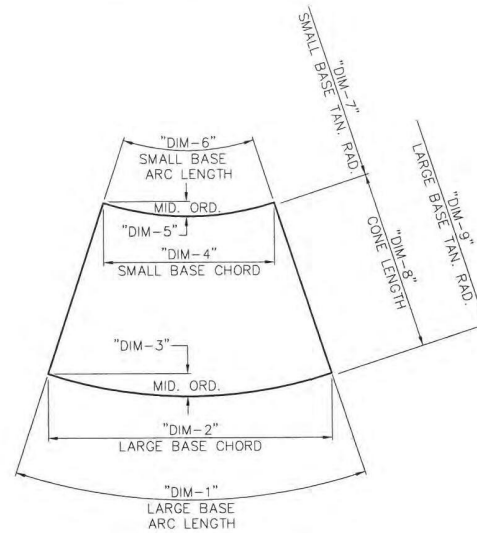

CONE DIMENSIONS BEFORE FORMING
ALL DIMENSIONS ON CENTERLINE OF PLATE

04-01
04-02
04-03
04-04

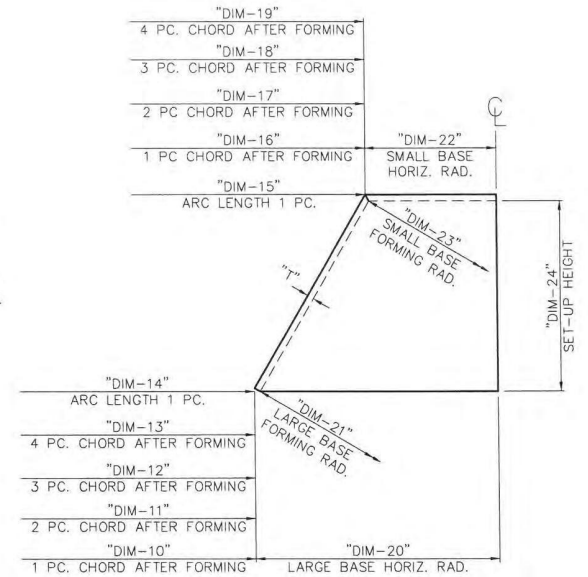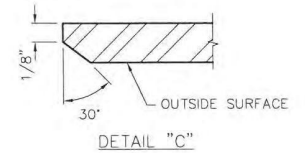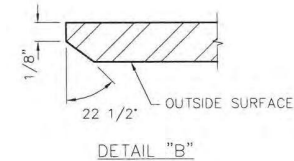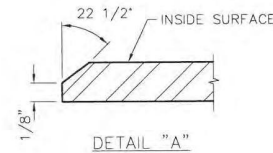

CONE DIMENSIONS AFTER FORMING
ALL DIMENSIONS ON OUTSIDE OF PLATE

AS-BUILT

	REV.	BY:	DATE	REMARKS
FRANKLIN COUNTY, VIRGINIA 500,000 GALLON PEDESHERE				
BY: TSY		TITLE: BASE CONE DETAILS		
DATE: 12/13/19		DRAWING NO.: E-8884 04		