

PEDESTAL PLATES						
PART #	QTY.	THK.	HEIGHT	LENGTH	DIAGONAL	WEIGHT
05-02	2	3/4"	9'-11"	31'-2 1/2"	32'-8 15/16"	9,480
05-01	1	1"	8'-9 1/2"	31'-1 3/4"	32'-4 3/8"	11,175






NOTES:

- LENGTHS SHOWN INCLUDE 1/8" WELD GAP FOR WELD SEAMS (SHOP OR FIELD).
- ALL PLATES ROLLED TO 5'-0" OUTSIDE RADIUS.

SHIPPING ITEM	QTY.	PC. MK.	QTY.	MATERIAL REQ'D	DESCRIPTION	UNIT WT.
05-PA-01	1			BOTTOM PEDESTAL ASSY - 11'-3 15/16"		14,420
		05-01	1	PL C/F (1) 1" x 120" x 378"	PED PL "P1"	
		13-09	1	CH C5 x 6.7 x 9'-7 1/16" LG.	BRACE	
		18-02	1	FB 1/4" x 2" x 6"	CONDUIT CLIP	
		04-04	12	PL C/F (1) 27/32" x 72" x 204"	BASE TRANS "B4"	
		03-02	4	PL C/F (1) 1/2" x 60" x 120"	PL RING "PR2"	
		03-08	12	PL 1/2" THK.	GUSSETS	
		11-LA-02	1	PEDESTAL LADDER (NOTE 4)		
		18-03	1	AN 4" x 4" x 1/4" x 4"	RECEPTACLE	
05-PA-02	1			INT. PEDESTAL ASSY - 9'-11"		9,545
		05-02	1	PL C/F (1) 3/4" x 120" x 378"	PED PL "P2"	
		13-09	1	CH C5 x 6.7 x 9'-7 1/16" LG.	BRACE	
		18-02	1	FB 1/4" x 2" x 6"	CONDUIT CLIP	
		11-LA-02	1	PEDESTAL LADDER (NOTE 4)		

NOTES:

1. SEE DWG. 15 FOR CHANNEL BRACE INSTALLATION.
2. SEE DWG. 02, 02A FOR CABLE BRACKET (18-05) ORIENTATIONS. INSTALL AT SAME ELEVATION AS 13-09.
3. SEE DWG. 02A, FOR RECEPTACLE BRACKET (18-03) ORIENTATION.
4. PEDESTAL LADDER MAY BE SHIPPED LOOSE.

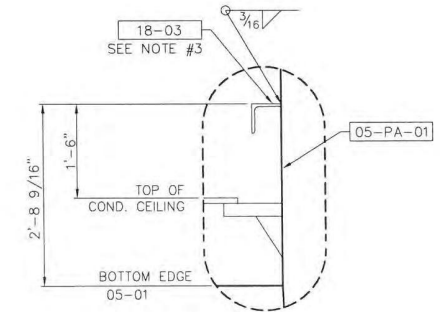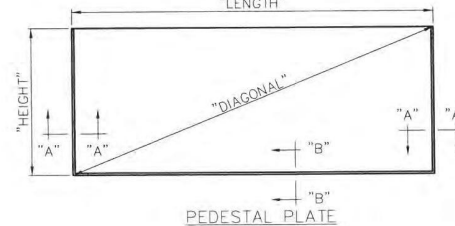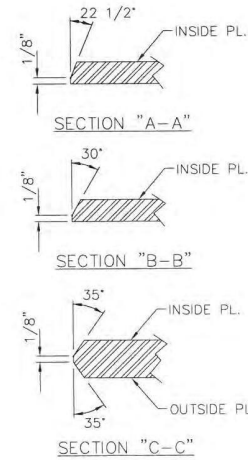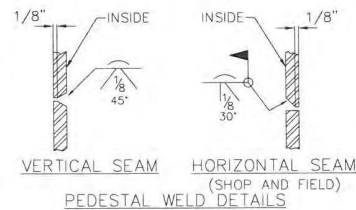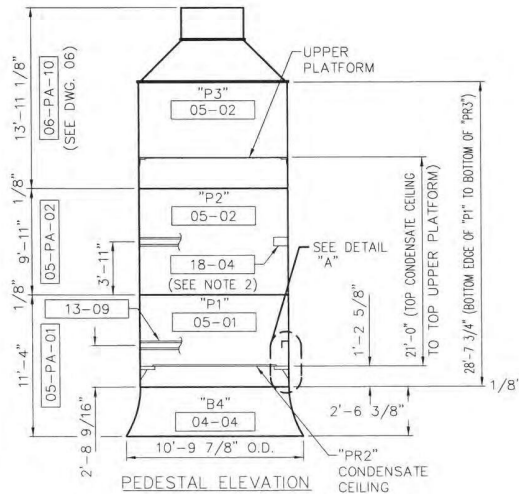

AS-BUILT

	REV.	BY:	DATE	REMARKS
CALDWELL Since 1897 Water - Energy - Industrial				
FRANKLIN COUNTY, VIRGINIA 500,000 GALLON PEDESHERE				
BY: TSY	TITLE: PEDESTAL ASSEMBLY			
DATE: 12/13/19	DRAWING NO.: E-8884			05