
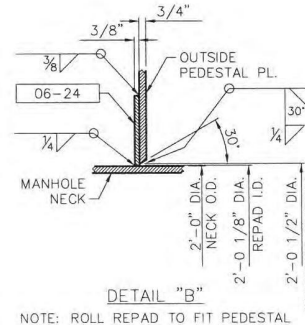
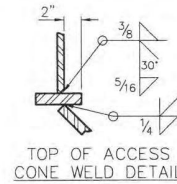


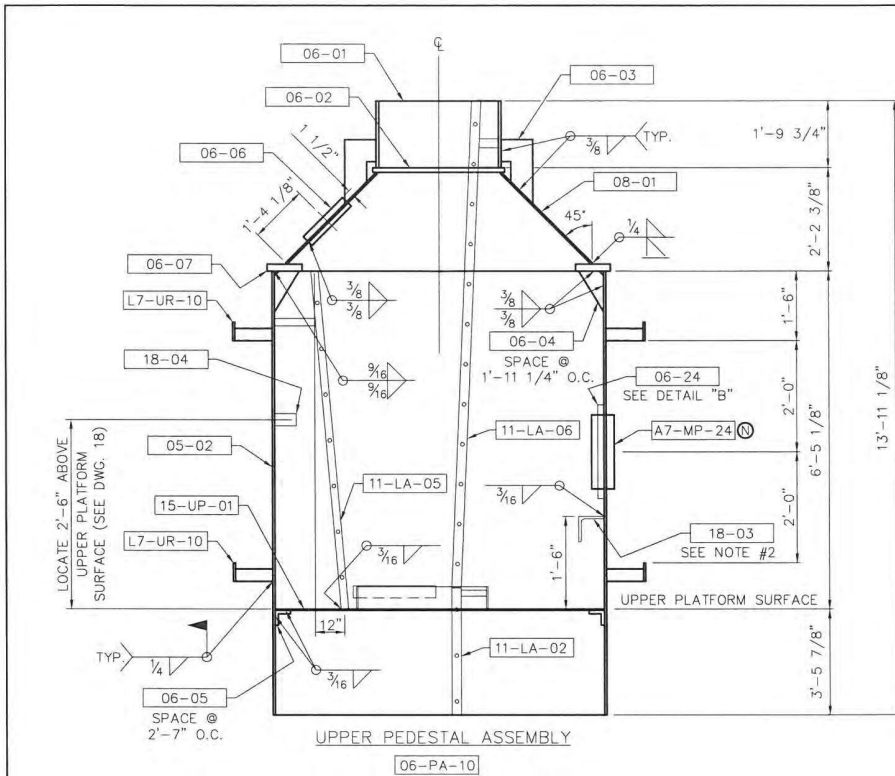


NOTE: ROLL REPAD TO FIT PEDESTAL

SHIPPING ITEM	QTY.	PC. MK.	QTY.	MATERIAL REQ'D	DESCRIPTION	UNIT WT.
06-PA-10	1			UPPER PEDESTAL ASSY - 13'-11 7/8"		14,885
		06-01	1	PL C/F (1) 7/16" x 120" x 191"	ACC. TUBE SECTION	
		06-02	1	PL 1" x 5'-4" O.D. x 4'-8" I.D.	PL RING "PR4"	
		08-01	4	PL C/F (0.67) 3/4" x 96" x 240"	ACC. CONE "C1"	
		06-07	4	PL (0.4) 7/8" x 72" x 240"	PL RING "PR3"	
		05-02	1	PL C/F (1) 3/4" x 120" x 378"	PED PL "P3"	
		06-03	4	PL 1/2" THK.	A.T. GUSSET	
		06-04	16	PL 3/4" THK.	PED. GUSSET	
		15-UP-01	1	UPPER PLATFORM ASSY.		
		06-05	12	AN 4" x 4" x 3/8" x 6" LG.	U.P. SUPPORT	
		06-06	1	BY 18" x 24" x 6" MANHOLE RING	ELLIP. MANHOLE	
		A7-MP-24	1	ST 24" DIA. PEDESTAL ACCESS MANHOLE		
		11-LA-02	1	PEDESTAL LADDER		
		11-LA-05	1	TANK ACCESS LADDER		
		11-LA-06	1	SLOPING TRANSITION LADDER		
		13-PA-01	1	TANK ENTRY SECTION (INLET)	INLET ENTRY	
		12-OF-02	1	PI 12" EX. H.VY. x 4'-0" LG.	O'FLOW ENTRY	
		06-24	1	PL 3/8" x 46" O.D. x 24 1/8" I.D.	REINFORCEMENT	
		18-03	1	AN 4" x 4" x 1/4" x 4"	RECEPTACLE	
		18-04	1	FB 1/4" x 2" x 4'-6 1/4" LG. (BENT)	CALBE BRACKET	
06-10	1			BY FOR 18" x 24" MANHOLE	COVER & CLAMP	90
06-11	1			BY FOR 18" x 24" MANHOLE	GASKET	

NOTES:

1. SHOP TO ALIGN TOP OF TANK ACCESS LADDER WITH BOTTOM OF ELLIPTICAL MANHOLE.
2. SEE DWG. 02, FOR RECEPTACLE BRACKET (18-03) ORIENTATION.




AS-BUILT

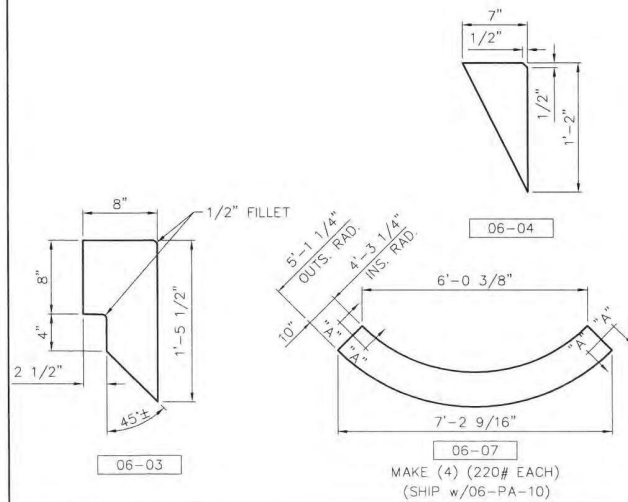

ACCESS TUBE PLATES						
PART #	QTY.	THK.	HEIGHT	LENGTH	DIAGONAL	WEIGHT
06-01	1	7/16"	1'-9 3/4"	15'-7"	15'-8 1/4"	525

NOTE:

1. LENGTHS SHOWN INCLUDE 1/8" WELD GAP FOR WELD SEAMS (SHOP OR FIELD).

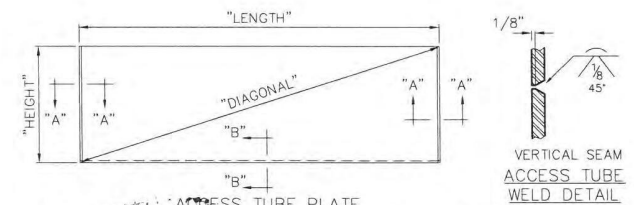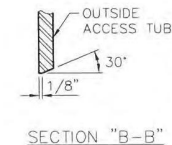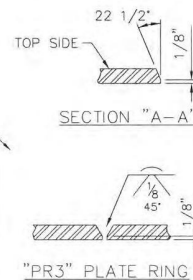

ACCESS TUBE PLATE			
REV.	BY:	DATE	REMARKS
FRANKLIN COUNTY, VIRGINIA 500,000 GALLON PEDESHERE			
BY: TSY	TITLE: TOP PEDESTAL ASSEMBLY		
DATE: 12/13/19	DRAWING NO.: E-8884 06		