


SYMBOL	"C1" DIMENSIONS 08-01	"C2" DIMENSIONS 08-02	"C3" DIMENSIONS 08-03	"C4" DIMENSIONS 08-04
"T"	3/4"	1 1/8"	15/16"	25/32"
"DIM-1"	7'-0 9/32"	N/A	7'-4 5/16"	10'-4 27/32"
"DIM-2"	6'-8 1/32"	4'-3 9/16"	7'-3 21/32"	10'-3 29/32"
"DIM-3"	11 3/8"	2 5/16"	4 21/32"	6 19/32"
"DIM-4"	3'-8 1/4"	2'-6 31/32"	4'-3 11/16"	7'-3 23/32"
"DIM-5"	6 9/32"	3/8"	2 3/4"	4 21/32"
"DIM-6"	3'-10 19/32"	N/A	4'-4 3/32"	7'-4 3/8"
"DIM-7"	3'-6 1/16"	26'-7 3/4"	10'-3 1/4"	17'-4 31/32"
"DIM-8"	2'-9 15/16"	7'-6 5/8"	7'-1 17/32"	7'-2 1/16"
"DIM-9"	6'-4"	12'-0 27/32"	17'-4 25/32"	24'-7 1/32"
"DIM-10"	6'-4 9/32"	4'-3 13/32"	7'-3 15/32"	10'-3 17/32"
"DIM-11"	9'-0"	8'-3 7/16"	14'-1 3/32"	19'-10 13/16"
"DIM-12"	N/A	N/A	19'-11 3/16"	28'-1 25/32"
"DIM-13"	N/A	N/A	24'-4 31/32"	34'-5 3/4"
"DIM-14"	7'-0 11/16"	4'-4"	7'-4 15/32"	10'-4 31/32"
"DIM-15"	3'-11"	2'-7 9/32"	4'-4 7/32"	7'-4 1/2"
"DIM-16"	3'-6 11/32"	2'-6 15/16"	4'-3 5/8"	7'-3 1/2"
"DIM-17"	5'-0"	4'-11 7/8"	8'-3 7/8"	14'-1 3/16"
"DIM-18"	N/A	N/A	11'-9 5/16"	19'-11 5/16"
"DIM-19"	N/A	N/A	14'-5 1/8"	24'-5 5/32"
"DIM-20"	4'-6"	8'-3 9/16"	14'-1 3/16"	19'-10 29/32"
"DIM-21"	6'-3 5/8"	N/A	23'-10 29/32"	33'-9 21/32"
"DIM-22"	2'-6"	5'-0"	8'-4"	14'-1 9/32"
"DIM-23"	3'-5 11/16"	N/A	14'-1 3/16"	23'-11 7/32"
"DIM-24"	2'-0"	6'-5 21/32"	4'-2 9/32"	4'-2 19/32"

SHOP INFORMATION

NO. SEGM. REQ'D	4	12	12	12
SEGM. WT.	475	1,110	1,600	2,035
VERT EDGE	DETAIL "A"	DETAIL "A"	DETAIL "A"	DETAIL "A"
SM. END	NO BEVEL	NO BEVEL	DETAIL "A"	DETAIL "A"
LG. END	NO BEVEL	DETAIL "A"	DETAIL "A"	NO BEVEL



SHIPPING INFORMATION

NO. ASS'Y	1	2	12	12
REF. DWG.	06	07	07	07

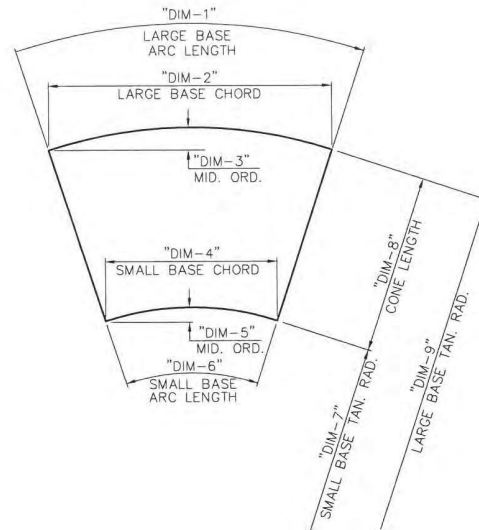

CONE DIMENSIONS BEFORE FORMING
ALL DIMENSIONS ON CENTERLINE OF PLATE

08-01
08-02
08-03
08-04

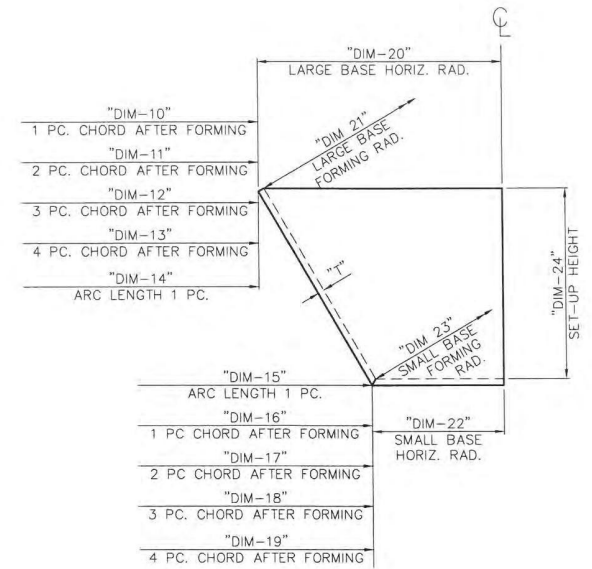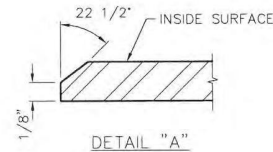

CONE DIMENSIONS AFTER FORMING
ALL DIMENSIONS ON OUTSIDE OF PLATE

AS-BUILT

	REV.	BY:	DATE	REMARKS
CALDWELL Since 1897 Water - Energy - Industrial FRANKLIN COUNTY, VIRGINIA 500,000 GALLON PEDESHERE				
BY: TSY		TITLE: TANK CONE DETAILS		
DATE: 12/13/19		DRAWING NO.: E-8884 08		