

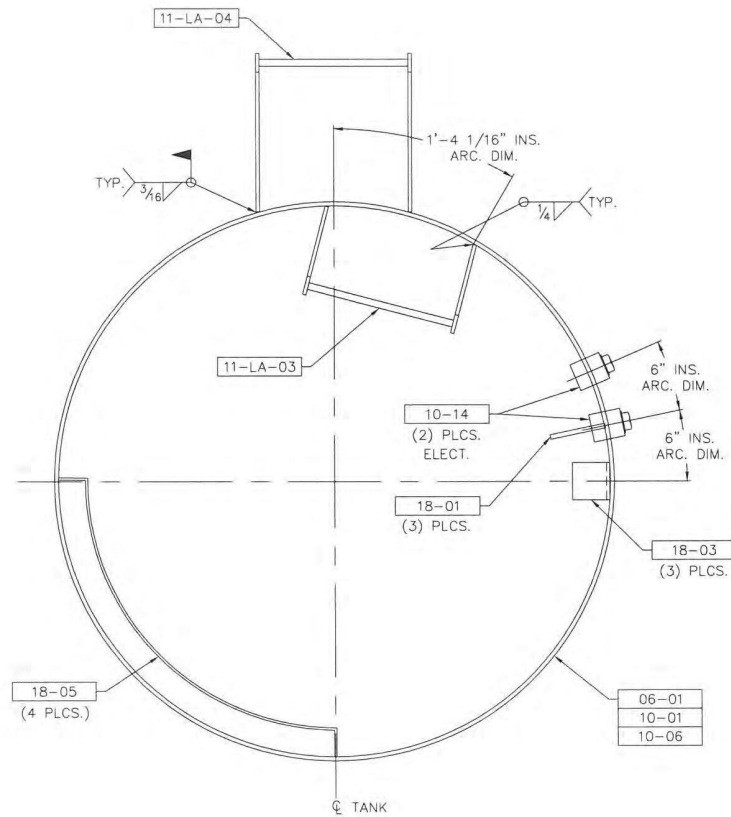


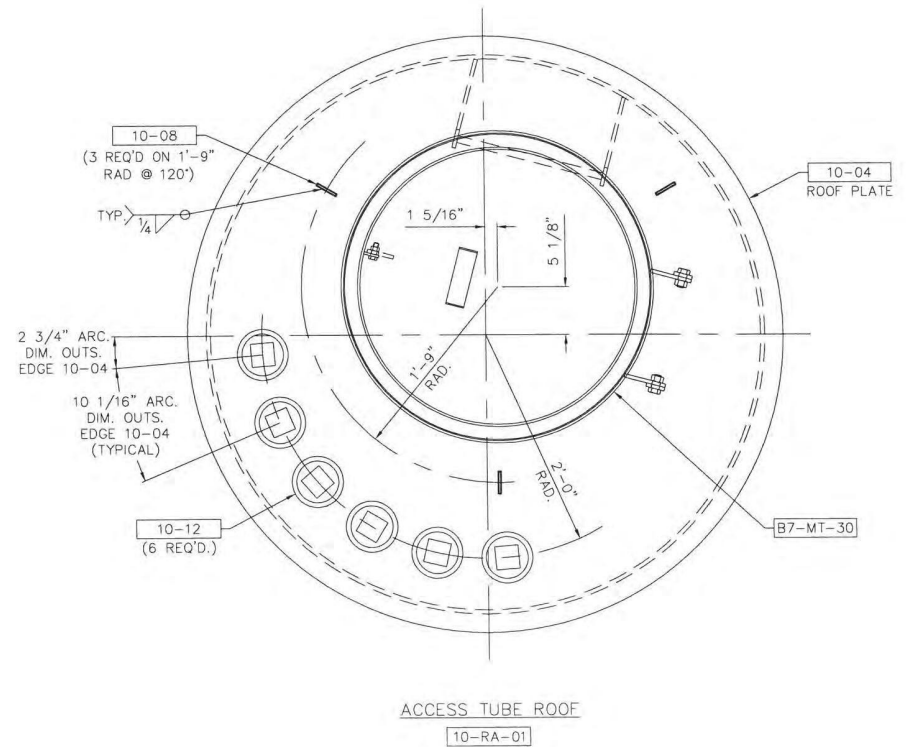

SECTION "A-A"
(FROM DWG. 10)

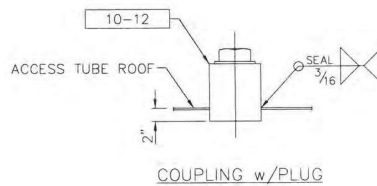

AS-BUILT

		REV.	BY:	DATE	REMARKS
		FRANKLIN COUNTY, VIRGINIA 500,000 GALLON PEDESHERE			
		BY: TSY	TITLE: ACCESS TUBE		
		DATE: 12/13/19	DRAWING NO.: E-8884 10A		