
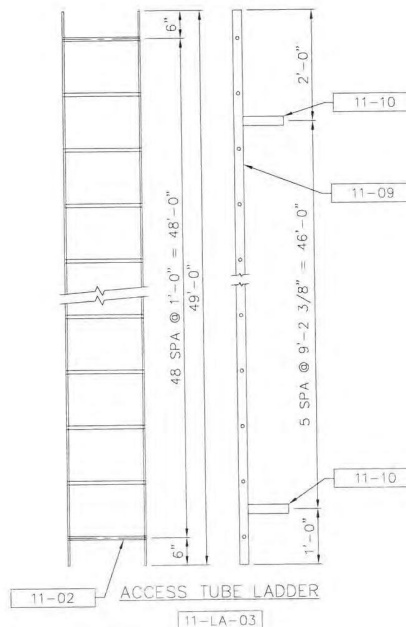
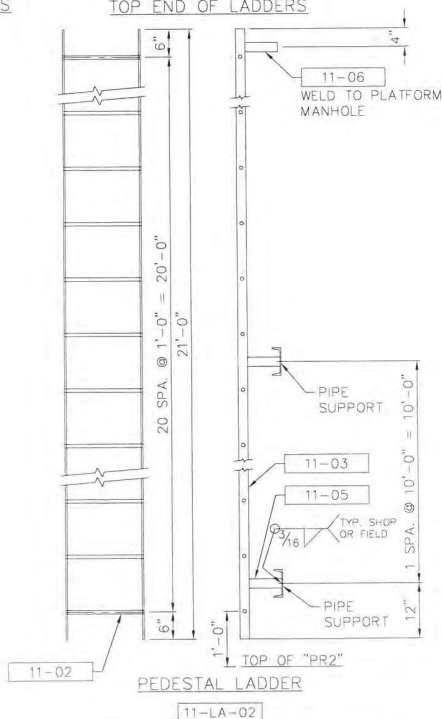


BASE LADDER DETAILS

TOP END OF LADDERS

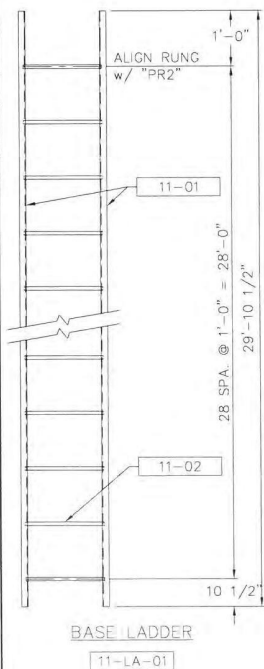

SHIPPING ITEM	QTY.	PC. MK.	QTY.	MATERIAL REQ'D	DESCRIPTION	UNIT WT.
11-LA-01	1			BASE LADDER		310
		11-01	2	CH C3 x 4.1 x 29'-10 1/2" LG.	STRINGER	
		11-02	29	RB 3/4" DIA. REBAR x 1'-4 7/8"	RUNG	
11-LA-02	1	(w/PEDESTAL)		PEDESTAL LADDER		165
		11-03	2	FB 3/8" x 2" x 21'-0"	STRINGER	
		11-02	21	RB 3/4" DIA. REBAR x 1'-4 7/8"	RUNG	
		11-05	4	FB 3/8" x 2" x 7 9/16"	BRACE	
		11-06	2	FB 3/8" x 2" x 6"	BRACE	
11-LA-03	1	(w/10-AT-01)		ACCESS TUBE LADDER		375
		11-09	2	FB 3/8" x 2" x 49'-0"	STRINGER	
		11-02	49	RB 3/4" DIA. REBAR x 1'-4 7/8"	RUNG	
		11-10	12	FB 3/8" x 2" x 7 3/4"	BRACE	
11-04	2			FB 3/8" x 2" x 5 1/2" LG.	BRACE	
11-25	18			FB 1/4" x 1 1/2" x 4"	SPLICE BAR	
11-26	2			BY 3/4" DIA. x 2" LG.	M. BOLT w/ NUT & WASHER	
11-27	4			BY 3/4" DIA. x 5 1/2" LG.	HILTI KWIK BOLT 3	
11-30	1			BY 108 LIN. FT. (GALV.) (CENTRAL ACCESS)	SAFETY CABLE	
11-31	1			BY 49 LIN. FT. (S.S.) (INSIDE TANK)	SAFETY CABLE	
11-32	2			BY 6116631 - GALVANIZED	BRACKET SET	
11-33	1			BY 6116632 - STAINLESS STEEL	BRACKET SET	
11-34	5			BY 6100400 - NON-METALLIC/GALV.	CABLE GUIDE	
** 11-35	2			BY	CABLE SLEEVE	
** 11-36	2			BY	HARNES	
** 11-37	2			BY	LANYARD	

NOTES:

- LADDERS (EXCEPT 11-LA-05) WILL BE FURNISHED w/CABLE-TYPE SAFE CLIMBING DEVICE.
- ** 11-35, 11-36 & 11-37 SHALL BE SHIPPED DIRECTLY TO THE OWNER.
- 11-LA-02 MAY BE SHIPPED LOOSE.

AS-BUILT

A	AMH	02/10/20	BRACKET SET QTY.	
REV.	BY:	DATE	REMARKS	
FRANKLIN COUNTY, VIRGINIA 500,000 GALLON PEDESHERE				
BY:	TSY JAM	TITLE: LADDER DETAILS		
DATE:	12/13/19	DRAWING NO.:	E-8884	11