



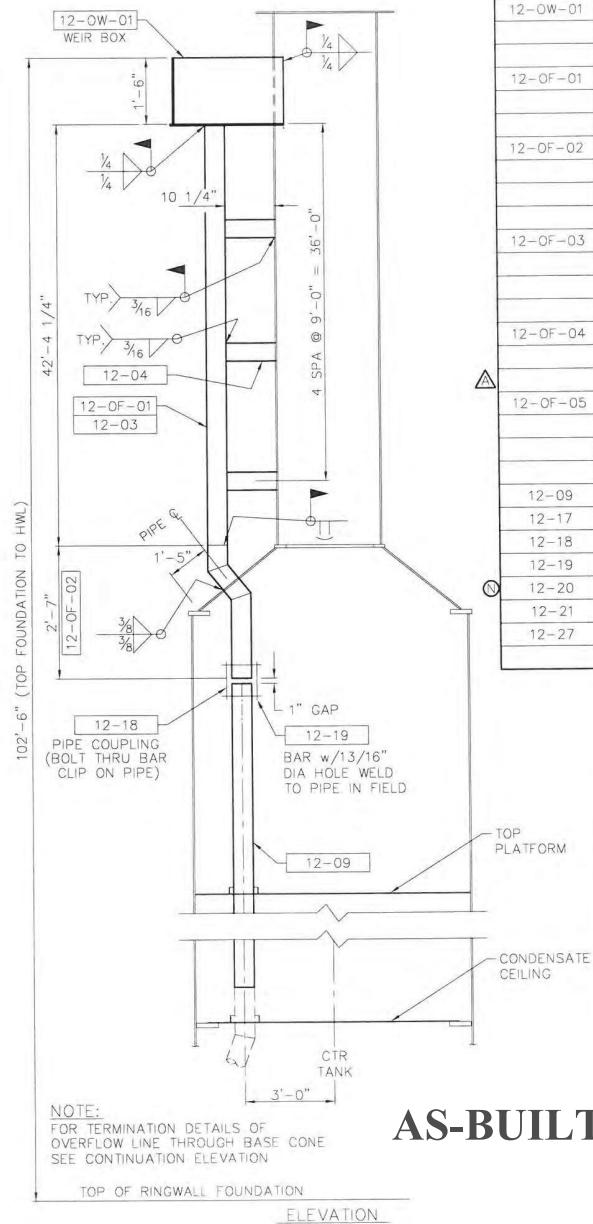

SHIPPING ITEM	QTY.	PC. MK.	QTY.	MATERIAL REQ'D	DESCRIPTION	UNIT WT.
12-OW-01	1			OVERFLOW WEIR BOX ASSY.		110
		12-01	1	PL 1/4" x 1'-8" x 6'-3 1/4"	SIDE PLATE	
		12-02	1	PL 1/4" x 1'-8" x 2'-6"	BOTTOM PLATE	
12-OF-01	1			OVERFLOW A.T. SECTION		2,12
		12-03	1	PI 12" STD. WT. x 42'-4 1/4" LG.	PIPE	
		12-04	4	PI 3/8" x 6" x 10 1/4" LG.	BRACE	
12-OF-02	1	(w/06-PA-10)		TANK ENTRY SECTION - OVERFLOW		170
		12-06	1	PI 12" STD. WT. x 8 3/8" LG.	PIPE	
		12-07	1	PI 12" EX. HVY. x 1'-3" LG.	PIPE	
		12-08	1	PI 12" STD. WT. x 1'-0" LG.	PIPE	
12-OF-03	1			PEDESTAL/BASE CONE TRANS.		985
		12-10	1	PI 12" x 1/4" WALL x 3'-0" LG.	PIPE	
		12-11	1	PI 12" x 1/4" WALL x 25'-7 3/8" LG.	PIPE	
		12-12	3	FB 3/8" x 6" x 1'-2 3/4" LG.	BRACE	
12-OF-04	1			BASE CONE EXIT ASSEMBLY		360
		12-13	1	PI 12" x 1/4" WALL x 1'-0" LG.	PIPE	
		12-14	1	PI 12" EX. HVY. x 6'-6" LG.	PIPE	
12-OF-05	1			OVERFLOW TERMINATION ASSEMBLY		85
		12-15	2	PI 12" x 1/4" WALL x 1'-0" LG.	PIPE	
		12-17	1	ST FOR 12" PIPE (w/HOLES)	PLATE FLANGE	
12-09	1			PI 12" x 1/4" WALL x 27'-0" LG.	OVERFLOW	905
12-17	1			ST FOR 12" PIPE (w/HOLES)	PLATE FLANGE	20
12-18	1			BY 12" DIA. w/GASKET & BOLTS	COMP. CPLG.	
12-19	1			FB 1/4" x 3" x 3"	CLIP	
12-20	1			BY #16 MESH S.S. x 19" DIA.	SCREEN	
12-21	8			BY 1/2" DIA. x 1 1/2" (ZINC PL.)	M. BOLT w/NUITS	
12-27	2			BY 7/8" DIA. FOR 12" PIPE	STD. U-BOLT	

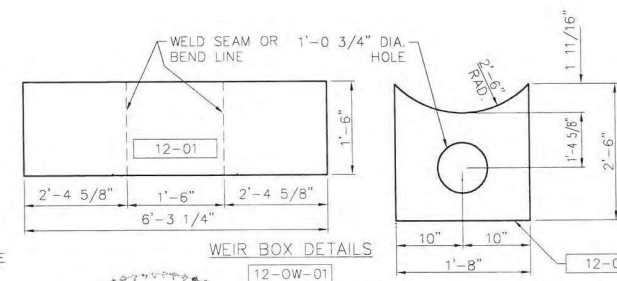

AS-BUILT

COMMONWEALTH OF VIRGINIA
 GERALD A. BURKE
 Lic. No. 034963
 Gerald A. Burke
 PROFESSIONAL ENGINEER
 12-19-2020

A	TSY	02/18/20	ADDED 1'-6" TO PIPE
REV.	BY:	DATE	REMARKS
 FRANKLIN COUNTY, VIRGINIA 500,000 GALLON PEDESHERE			
BY:	TSY	TITLE: OVERFLOW PIPING DETAILS	
DATE:	12/13/19	DRAWING NO.:	E-8884 12