

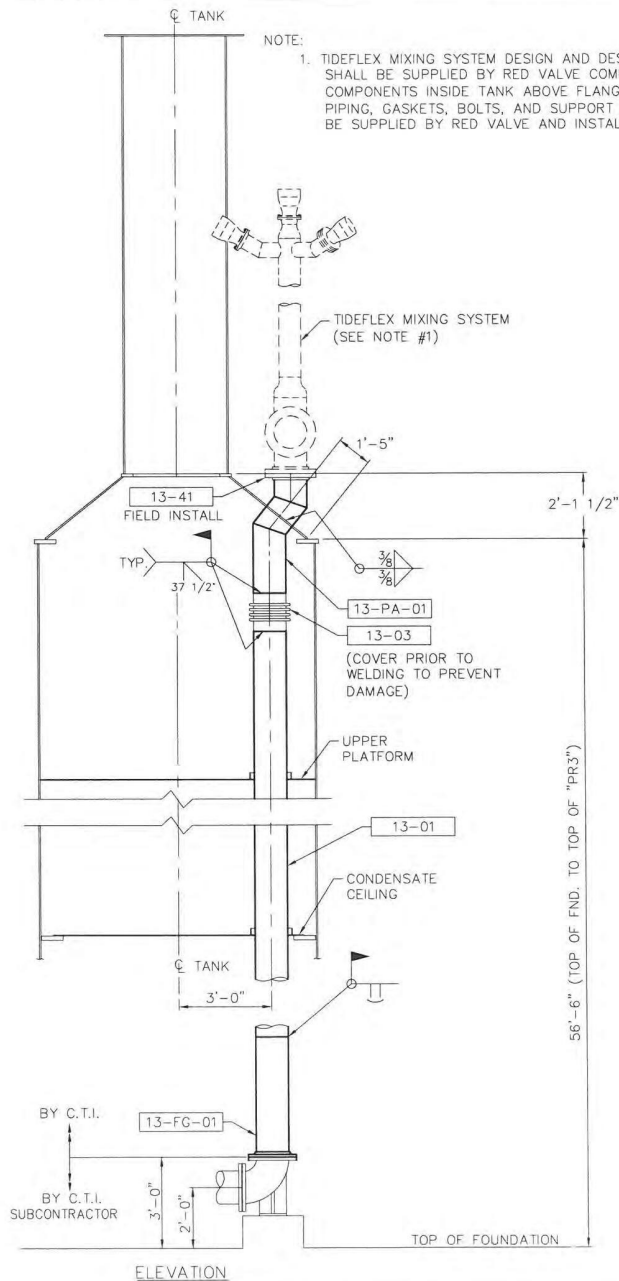


13-PA-01
INSTALL 13-21 IN 06-PA-10 PRIOR TO COMPLETING ASSEMBLY.

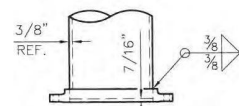

S.O. FLANGE WELD DETAIL
12" STD. WT. PIPE

SHIPPING ITEM	QTY.	PC. MK.	QTY.	MATERIAL REQ'D	DESCRIPTION	UNIT WT.
13-FC-01	1			INLET LINE ASSEMBLY		150
		13-11	1	PI 12" STD. WT. x 3'-0" LG.	PIPE	
		12-41	1	BY 150# RF FOR 12" PIPE	SLIP-ON FLANGE	59
13-PA-01	1	(w/06-PA-10)		INLET ENTRY ASSEMBLY		225
		13-20	1	PI 12" STD. WT. x 2'-0" LG.	PIPE	
		13-21	1	PI 12" EX. HVY. x 1'-3" LG.	PIPE	
		13-22	1	PI 12" STD. WT. x 8 3/8" LG.	PIPE	
13-01	1			PI 12" STD. WT. x 51'-0" LG.	INLET	2,530
13-03	1			BY 12" DIA. w/S.S. BELLOWS	EXP. JOINT	35
13-09	2	(w/PEDESTAL)		CH C5 x 6.7 x 9'-7 1/16" LG.	BRACE	65
13-36	2			BY 7/8" DIA. FOR 12" PIPE	STD. U-BOLT	
13-41	1			BY 150# RF FOR 12" PIPE	SLIP-ON FLANGE	59
13-51	1			BY 1/4" THK. RED RUBBER FOR 12" PIPE	GASKET	
13-55	12			BY 7/8" DIA. x 4 1/4" LG. (ZINC PL.)	M. BOLT w/ NUT	

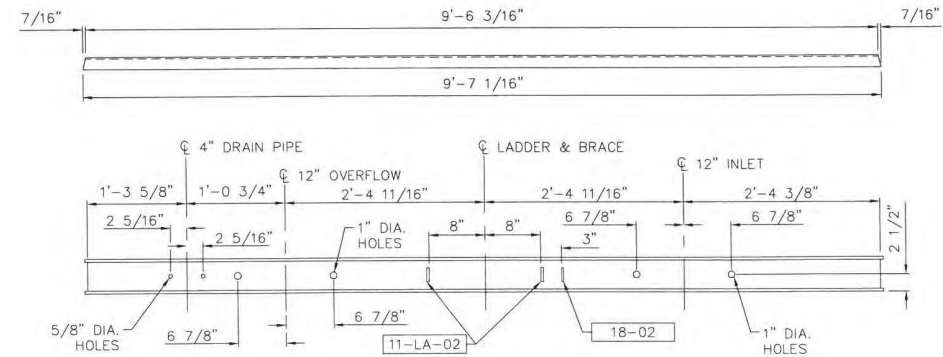


C5 x 6.7 CHANNEL - PIPE & LADDER BRACE

13-09

(2) REQ'D - SHOP INSTALL IN PEDESTAL. (SEE DWG. 05)

AS-BUILT

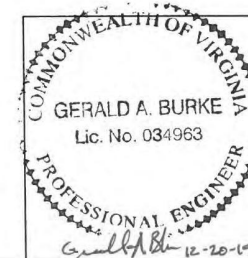

REV.	BY:	DATE	REMARKS
CALDWELL Since 1897 Water - Energy - Industrial FRANKLIN COUNTY, VIRGINIA 500,000 GALLON PEDESHERE			
BY: TSY		TITLE: INLET PIPING DETAILS	
DATE: 12/13/19		DRAWING NO.: E-8884	