

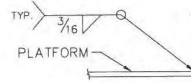


SHIPPING ITEM	QTY.	PC. MK.	QTY.	MATERIAL REQ'D	DESCRIPTION	UNIT WT.
15-CC-01	1			CONDENSATE CEILING ASSY.		630
		15-01	1	PL (1) 1/4" x 109" x 109"	CEILING	
		15-02	1	PI 20 DIA. x 1/4" WALL x 2" LG.	PIPE SLEEVE	
		15-04	1	PI 16 DIA. x 1/4" WALL x 2" LG.	PIPE SLEEVE	
		15-05	1	PI 10 3/4" DIA. x 1/4" x 2" LG.	PIPE SLEEVE	
		BE-ME-36	1	ST PLATFORM MANHOLE w/END HINGE		
		15-20	2	FB 1/4" x 2" x 6" LG.	CABLE SLEEVE	
		15-21	2	FB 1/4" x 2" x 3'-0" LG.	CABLE SLEEVE	

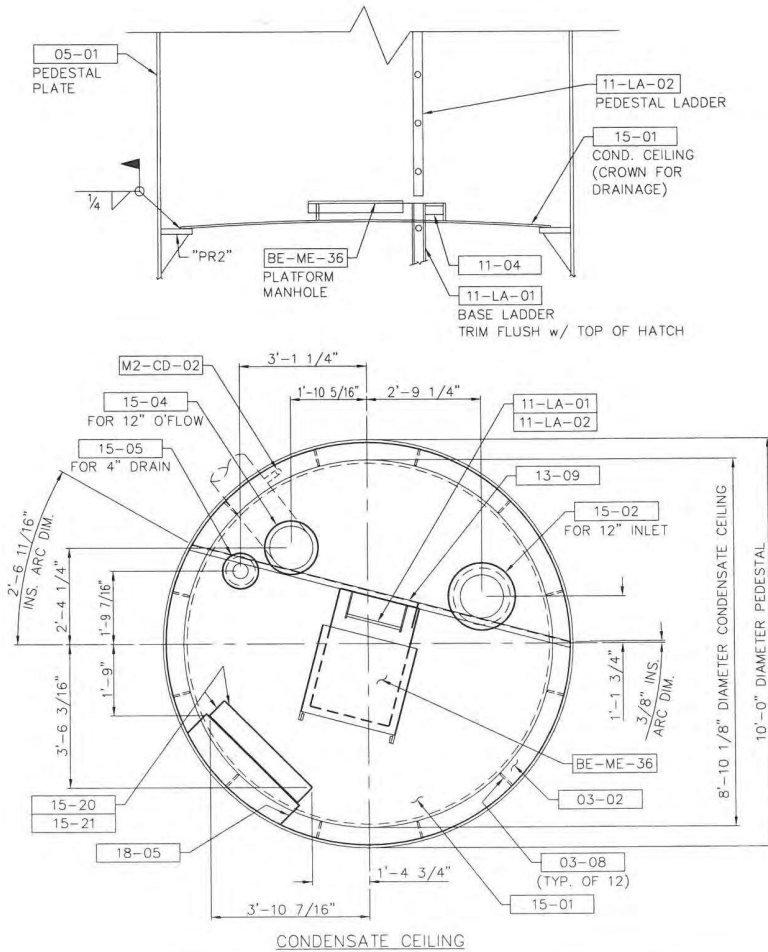


PLATFORM SLEEVE WELDING
(TYP. FOR HATCHES, PIPE
SLEEVES AND CABLE SLEEVES)

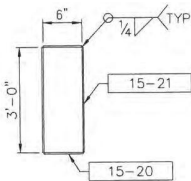

ANTENNA BOX

SHIPPING ITEM	QTY.	PC. MK.	QTY.	MATERIAL REQ'D	DESCRIPTION	UNIT WT.
15-UP-01	1	(w/06-PA-10)		UPPER PLATFORM ASSY.		760
		15-06	1	PL (1) 1/4" x 119" x 119"	PLATFORM	
		15-02	1	PI 20 DIA. x 1/4" WALL x 2" LG.	PIPE SLEEVE	
		15-04	1	PI 16 DIA. x 1/4" WALL x 2" LG.	PIPE SLEEVE	
		15-05	1	PI 10 3/4" DIA. x 1/4" x 2" LG.	PIPE SLEEVE	
		BE-ME-36	1	ST 24" x 36" PLATFORM MANHOLE w/ END HINGE		
		15-20	2	FB 1/4" x 2" x 6" LG.	CABLE SLEEVE	
		15-21	2	FB 1/4" x 2" x 3'-0" LG.	CABLE SLEEVE	

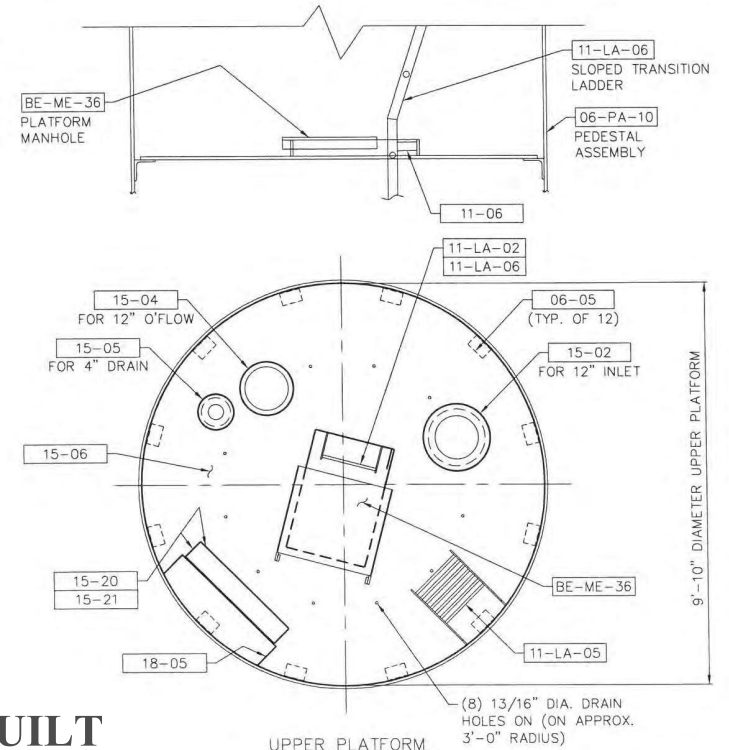


AS-BUILT

UPPER PLATFORM

NOTES:

1. SEE CONDENSATE CEILING PLAN FOR THE ORIENTATION OF THE PIPE SLEEVES IN THE TOP PLATFORM.

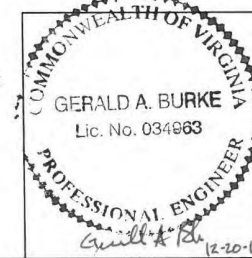

REV.	BY:	DATE	REMARKS	
				
FRANKLIN COUNTY, VIRGINIA 500,000 GALLON PEDESHERE				
BY: TSY		TITLE: CONDENSATE CEILING & UPPER PLATFORM DETAILS		
DATE: 12/13/19		DRAWING NO.: E-8884 15		