


SHIPPING ITEM	QTY.	PC. MK.	QTY.	MATERIAL REQ'D	DESCRIPTION	UNIT WT.
16-NA-01	1	(w/03-80-01)		NAMEPLATE ASSEMBLY		
		16-01	1	BY CAST ALUMINUM	NAME PLATE	
		16-02	2	AN 1" x 1" x 1/8" x 5" LG.	MOUNTING ANGLE	
		16-03	4	BY #8 x 5/8" LG.	DRIVE SCREW	

CALDWELL TANKS INC
LOUISVILLE , KENTUCKY

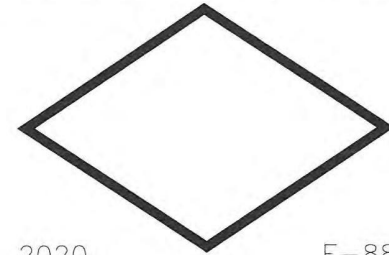

DATE: 2020 E-8884
CAPACITY 500,000 GALS.
BOTTOM HEIGHT 65 FT. 0 IN.
OVERFLOW HEIGHT 102 FT. 6 IN.


16-01

NAMEPLATE ASSEMBLY

16-NA-01

SHOP INSTALL ON BOTTOM BASE CONE
SECTION USING MOUNTING ANGLES 16-02

AS-BUILT

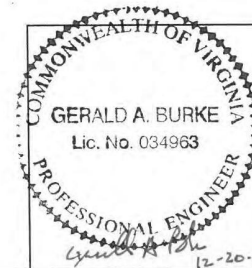

REV.	BY:	DATE	REMARKS
FRANKLIN COUNTY, VIRGINIA 500,000 GALLON PEDESHERE			
BY: TSY	TITLE: NAMEPLATE		
DATE: 12/13/19	DRAWING NO.:	E-8884	16