



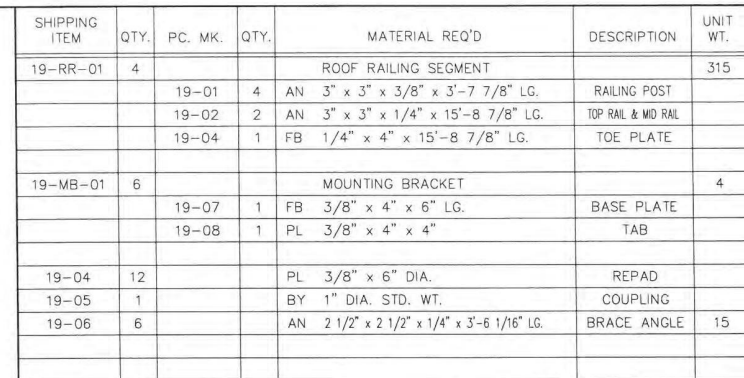


1. SEE DWG. 02 FOR ORIENTATION OF OBSTRUCTION LIGHT COUPLING & BRACE ANGLES.

AS-BUILT

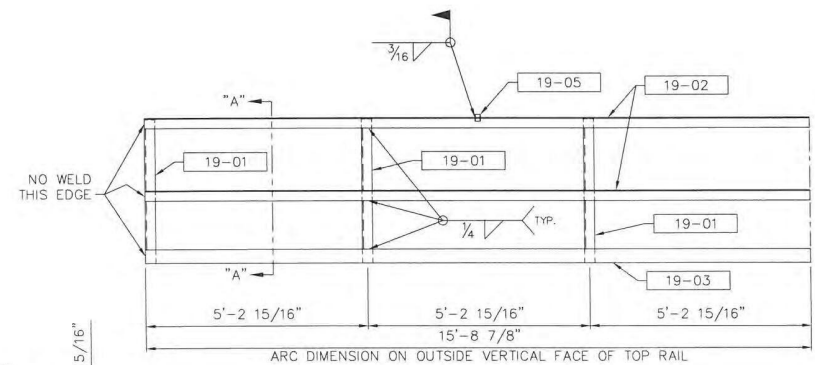

ROOF RAILING SEGMENT

19-RR-01

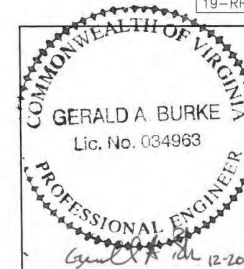

REV.	BY:	DATE	REMARKS		
 Since 1887 <i>Water - Energy - Industrial</i>					
FRANKLIN COUNTY, VIRGINIA					
500,000 GALLON PEDESHERE					
BY:	TSY		TITLE: ROOF RAILING FOR ANTENNA INSTALLATION		
DATE:	12/13/19		DRAWING NO.:	E-8884	19