

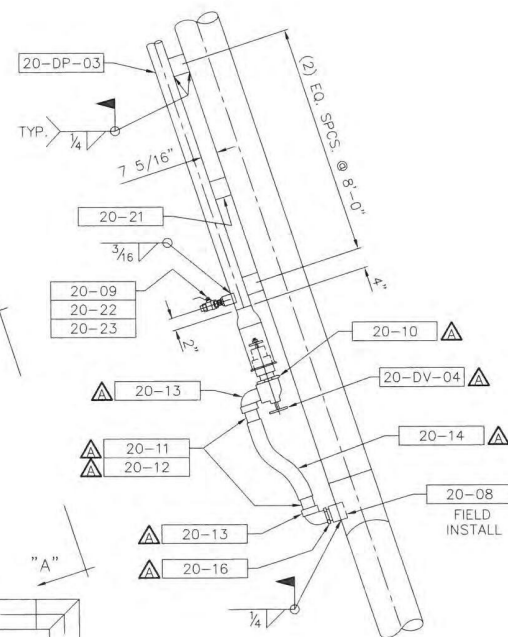
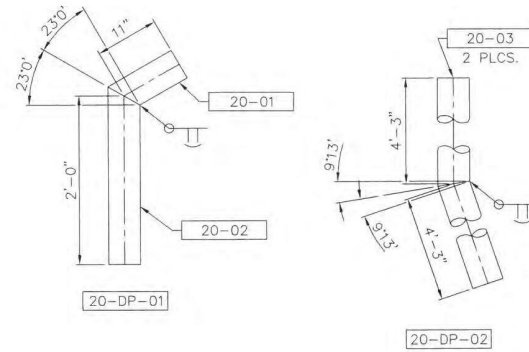


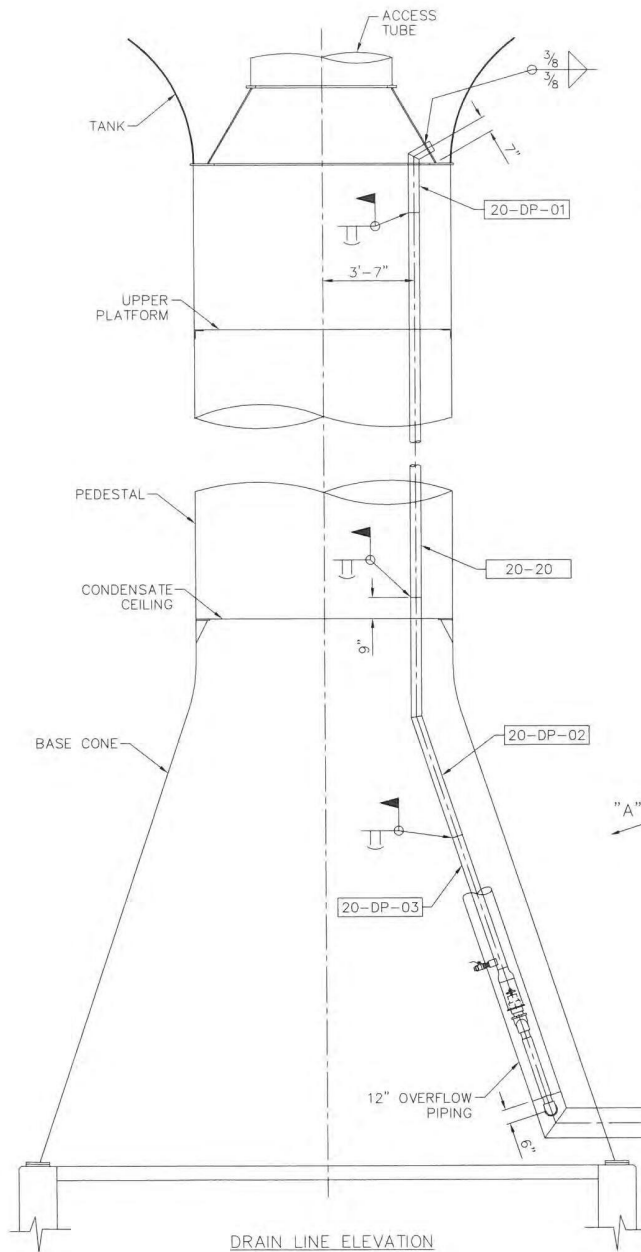

SHIPPING ITEM	QTY.	PC. MK.	QTY.	MATERIAL REQ'D	DESCRIPTION	UNIT WT.
20-DP-01	1	(w/06-PA-10)		TANK ENTRY SECTION (DRAIN)		120
		20-01	1	PI 4" EX. HEAVY x 11" LG.	PIPE	
		20-02	1	PI 4" EX. HEAVY x 2'-0"	PIPE	
20-DP-02	1			PEDESTAL / BASE CONE TRANSITION		95
		20-03	2	PI 4" STD WT. x 4'-3" LG.	PIPE	
20-DP-03	1			VALVE MOUNTING ASSEMBLY		200
		20-04	1	PI 4" STD WT. x 14'-9" LG.	PIPE	
		20-05	1	PI 6" STD. WT.. x 1'-0" LG.	PIPE	
		20-06	1	BY 6" x 4" STD. WT.	CONC. REDUCER	
		20-07	1	PL 3/8" x 7 1/4" DIA. w/4 5/16" HOLE	PLATE	
		20-08	1	BY 3" COUPLING, 3,000#	COUPLING	
		20-09	1	BY 1" COUPLING, 3,000#	COUPLING	
20-DV-04	1			3" DIA. NON-FREEZE DRAIN FOR PEDESHERE		
		20-10	1	BY 3" NON-FREEZING WATER DRAIN VALVE	S&J - 96181	
		20-11	2	BY 2 1/2" x 4" LG. (GALVANIZED)	PIPE NIPPLE	
		20-12	4	BY HOSE CLAMPS FOR 2 7/8" I.D. HOISING	STAINLESS STEEL	
		20-13	2	BY 2 1/2"-90° STREET ELL (GALV.)	ELBOW	
		20-14	1	BY 2 7/8" I.D. x 4'-0" LG.	RUBBER HOSE	
		20-15	1	BY ROLL TAPE FOR THREADS	TEFLON TAPE	
		20-16	1	BY 3" x 2 1/2" RED. BUSHING (GALV.)	RED. BUSHING	
20-08	1			BY 3" COUPLING, 3,000#	COUPLING	
20-20	1			PI 4" STD WT. x 25'-0" LG.	DRAIN PIPE	270
20-21	3			PL 1/4" x 4" x 7 5/16"	BRACE	
20-22	1			BY 1" x 3" LG.	PIPE NIPPLE	
20-23	1			BY 1" FEMALE ENDS (w/LOCKING HANDLE)	BALL VALVE	
20-30	2			BY 1/2" DIA. FOR 4" PIPE (EX. LONG THRD.)	STD. U-BOLT	

NOTES:
1. SEAL ALL THREADED JOINTS W/ TEFLON TAPE

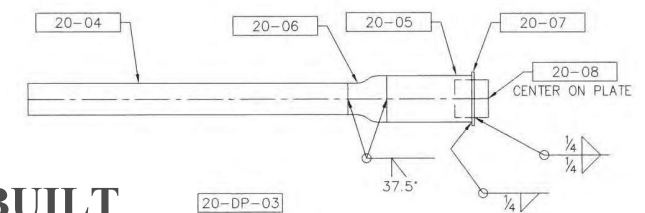

AS-BUILT

COMMONWEALTH OF VIRGINIA

GERALD A. BURKE

Lic. No. 034963

PROFESSIONAL ENGINEER

Gerald A. Burke 10-30-2020

A	AMK	10/15/20	REVISE NON-FREEZE VALVE
REV.	BY:	DATE	REMARKS
CALDWELL Since 1987 Water - Energy - Industrial FRANKLIN COUNTY, VIRGINIA 500,000 GALLON PEDESHERE			
BY: TSY		TITLE: DRAIN PIPING DETAILS	
DATE: 12/13/19		DRAWING NO.: E-8884 20	