



21-07

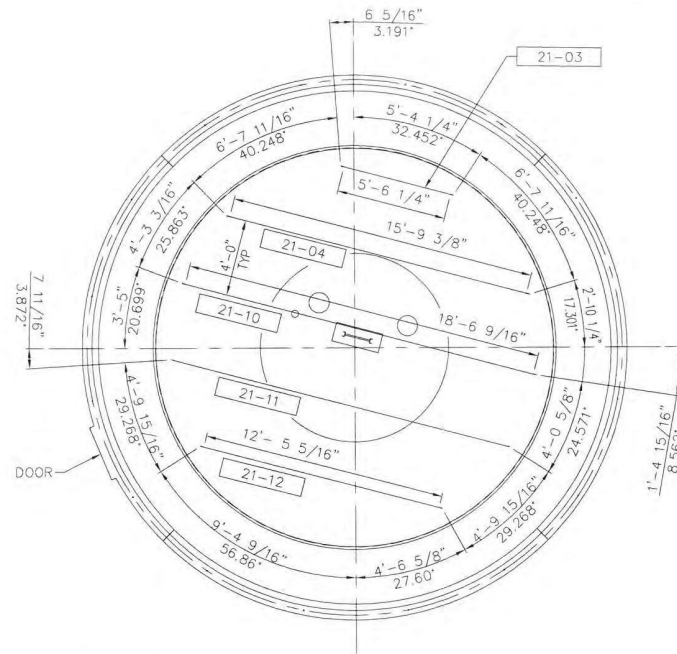

ARC LENGTHS ARE MEASURED AT THIS LOCATION

SEE PLAN NEW DIMENSION ADJACENT TO PART NUMBER FROM CENTER OF LUG TO CENTER OF LUG

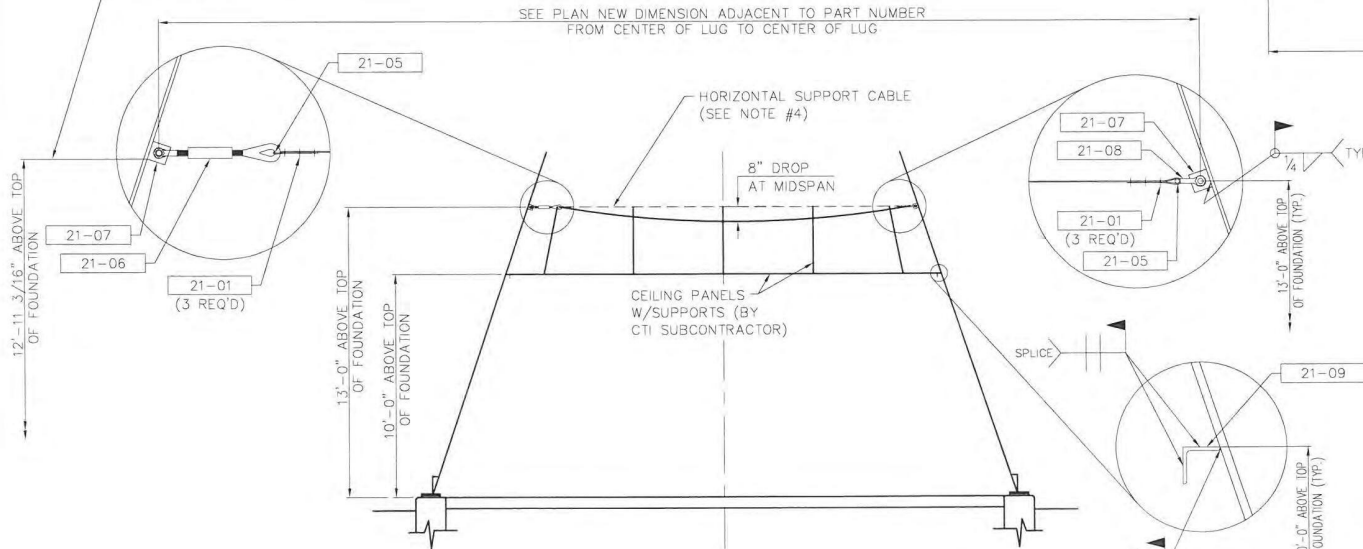


SHIPPING ITEM	QTY.	PC. MK.	QTY.	MATERIAL REQ'D	DESCRIPTION	UNIT WT.
21-01	30			BY FOR 3/8" CABLE - CROSBY CLIPS	CABLE CLAMP	
21-03	1			BY 3/8"-7 x 19 (GALV.) AIRCRAFT CABLE x 9'-3"	SUPPORT CABLE	
21-04	1			BY 3/8"-7 x 19 (GALV.) AIRCRAFT CABLE x 19'-3"	SUPPORT CABLE	
21-05	10			BY FOR 3/8" DIA. AIRCRAFT CABLE	THIMBLE	
21-06	5			BY 3/4" DIA x 12" LG. (GALV.) (CROSBY HG-227 1032091)	TURNBUCKLE JAW & EYE	
21-07	10			PL 1/4" PLATE		
21-08	5			BY 5/8" DIA. BOLT TYPE (CROSBY G-2130 1019490)	ANCHOR SHACKLE	
21-09	4			AN 2" x 2" x 1/4" x 16'-1 7/8" LG. SUPPORT ANGLE		
21-10	1			BY 3/8"-7 x 19 (GALV.) AIRCRAFT CABLE x 22'-5"	SUPPORT CABLE	
21-11	1			BY 3/8"-7 x 19 (GALV.) AIRCRAFT CABLE x 21'-4"	SUPPORT CABLE	
21-12	1			BY 3/8"-7 x 19 (GALV.) AIRCRAFT CABLE x 16'-2"	SUPPORT CABLE	

#### NOTES:

- CTI SUBCONTRACTOR SHALL SUBMIT SUSPENDED CEILING SYSTEM FOR APPROVAL.
- INSULATE TOP OF SUSPENDED CEILING WITH BATT INSULATION. INSULATION TO PROVIDE AN R VALUE OF 21.
- PROVIDE REMOVABLE SECTION OF CEILING PANEL AT LADDER TO ALLOW PERSON TO CLIMB THROUGH CEILING
- CABLE SUPPLIED WITH ADDITIONAL LENGTH FOR FIELD FIT UP.
- ARC LENGTHS MEASURED FROM BOTTOM OF 21-07


**AS-BUILT**

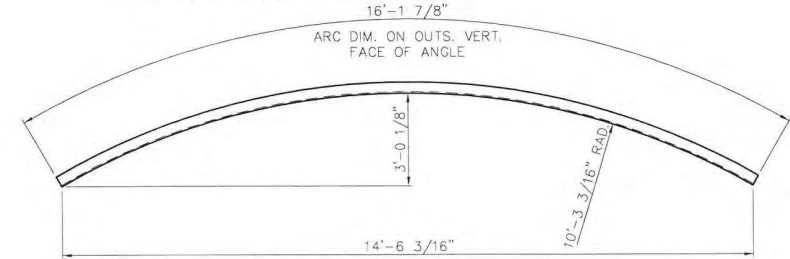


#### SUPPORT ANGLE DETAILS

21-09

NOTE: MAKE 4 PCS. AS SHOWN. LENGTH BEFORE ROLL = 20'-0" TRIM ENDS AFTER ROLLING TO OUTSIDE ARC DIMENSION. SHIPPING WT. FINISHED PIECE = 55#

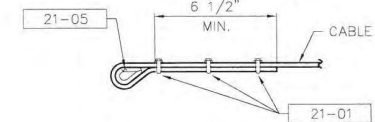

#### CABLE CONNECTION DETAIL

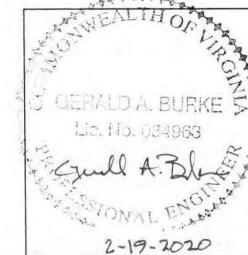

REV.	BY:	DATE	REMARKS
	ADB	2/6/20	TITLE: SUSPENDED CEILING HANGER DETAILS
			DRAWING NO.: E-8884

**CALDWELL**  
Since 1887  
Water - Energy - Industrial

FRANKLIN CO., VIRGINIA  
500,000 GALLON PEDESHERE