



WELD LEGEND
 ——— SHOP
 ——— FIELD
 - - - - NO X-RAY REQ'D

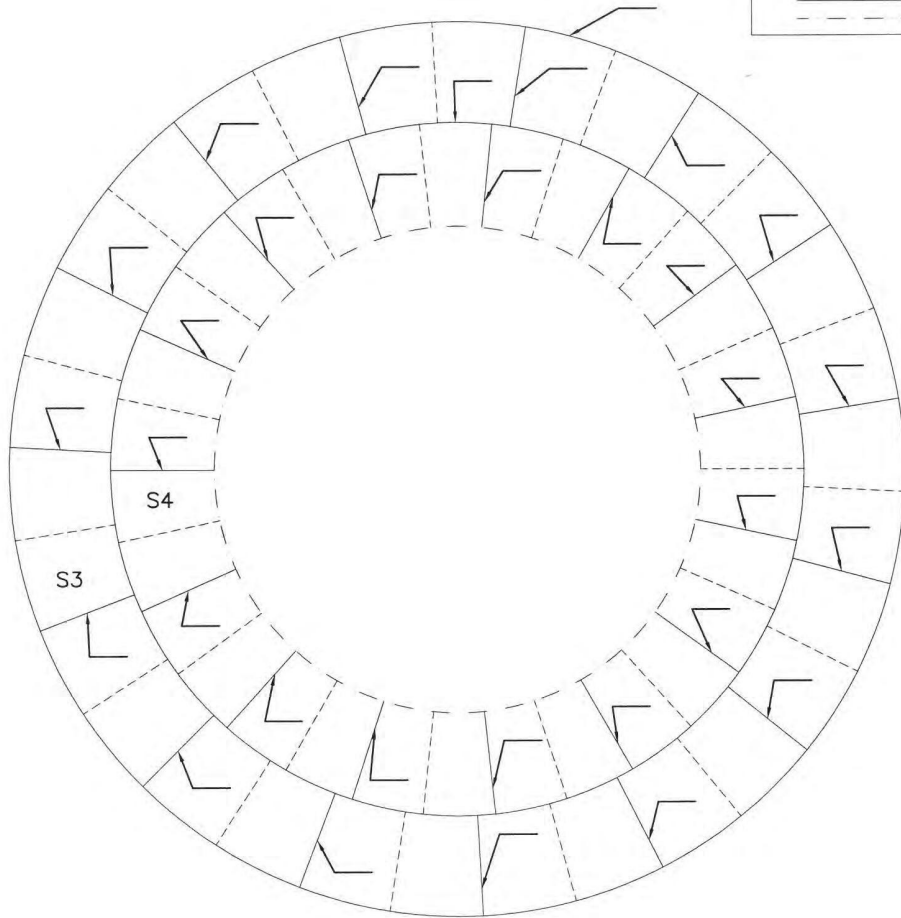

TOP LAY-OUT

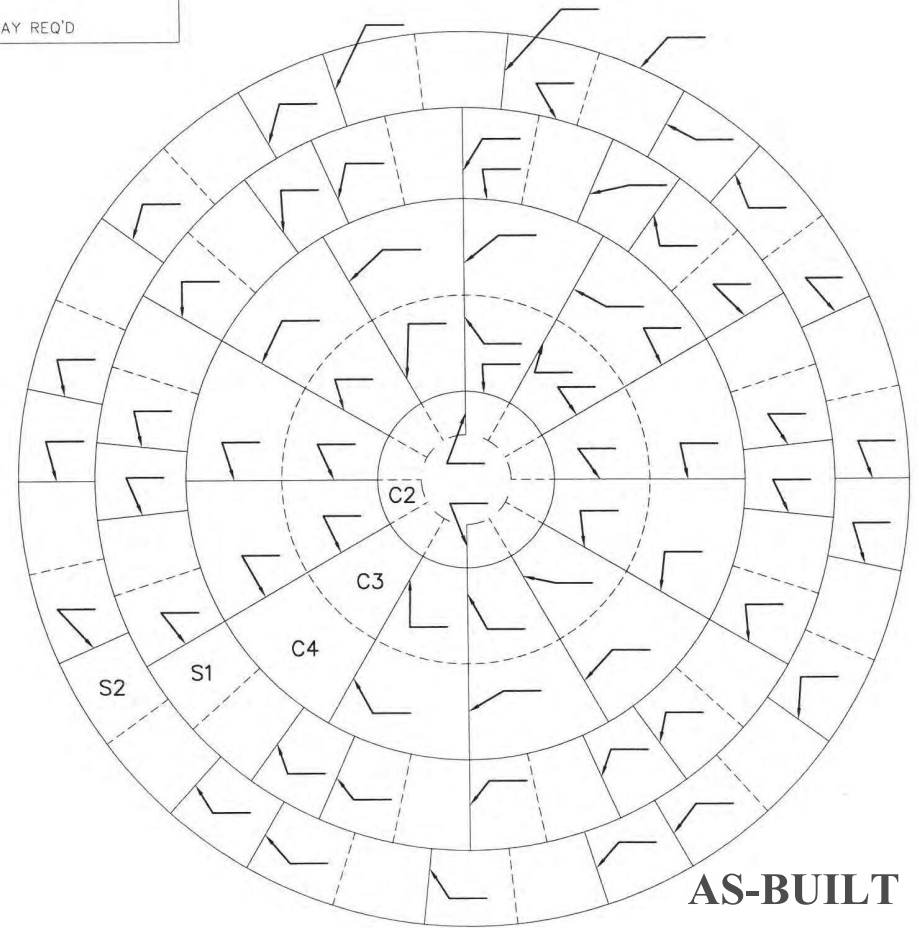

AS-BUILT

BOTTOM LAY-OUT

NOTE:
 1. THIS DRAWING TO BE USED IN CONJUNCTION WITH DRAWING XR2.

NOTE:

THE SYMBOL ABOVE SHOULD BE USED TO DESIGNATE THE WELDER OF EACH SEAM. PUT THE OUTSIDE WELDER'S INITIAL ON TOP OF THE LINE AND THE INSIDE WELDER'S INITIAL ON THE BOTTOM OF THE LINE. IF DIFFERENT WELDERS WELDED SEAMS OF THE SAME SECTION, YOU MUST SPECIFY EACH WELDER AT EACH SEAM.

| | | | |
|--|----------|--------------|--------------------|
| | | | |
| REV. | BY: | DATE | REMARKS |
| | | | |
| FRANKLIN COUNTY, VIRGINIA 500,000 GALLON PEDESHERE TANK | | | |
| BY: | JLH/AB | TITLE: | FIELD X-RAY LAYOUT |
| DATE: | 12/11/19 | DRAWING NO.: | E-8884 XR1 |