

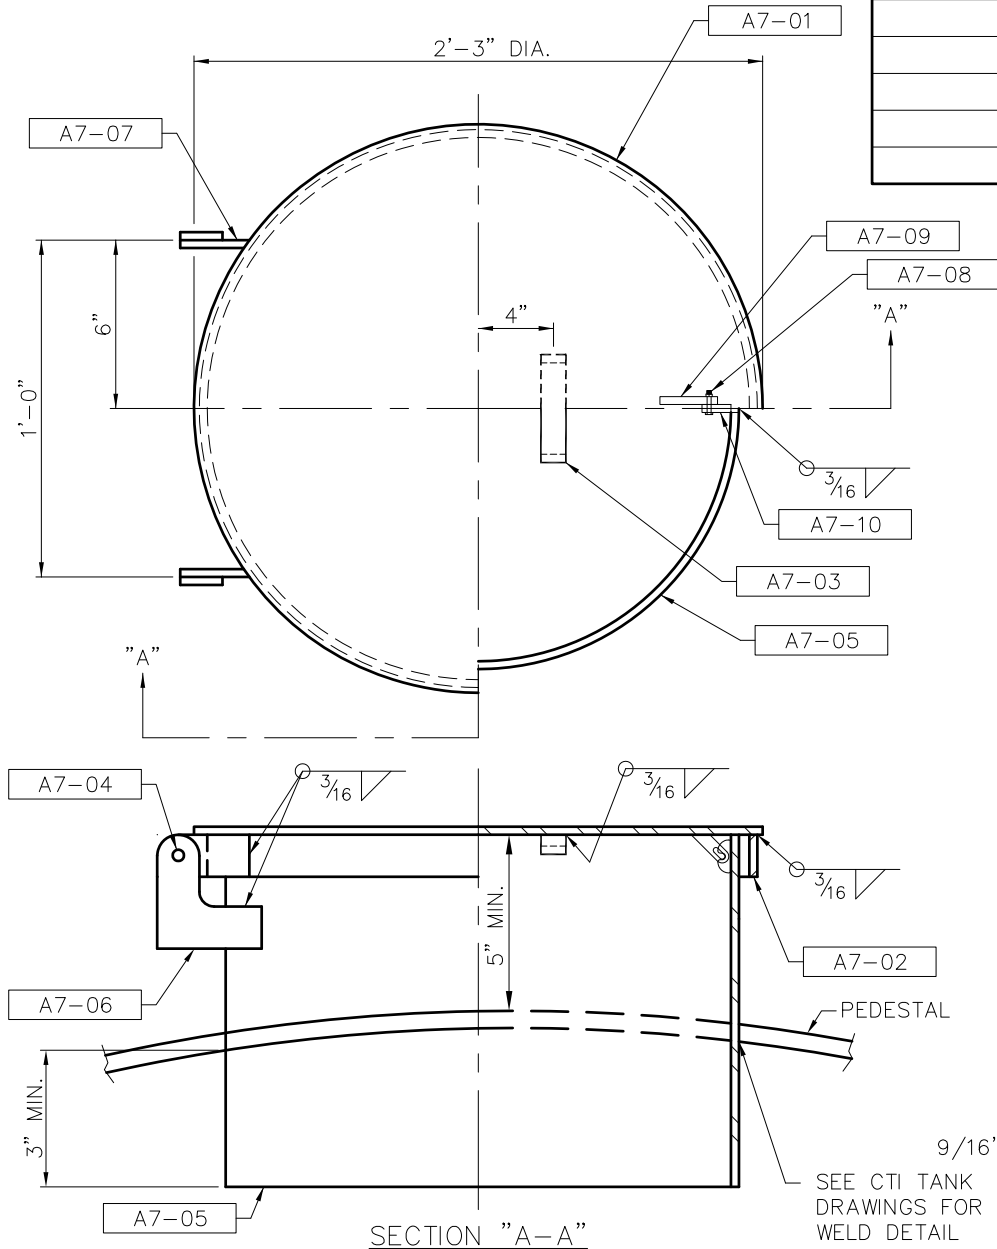
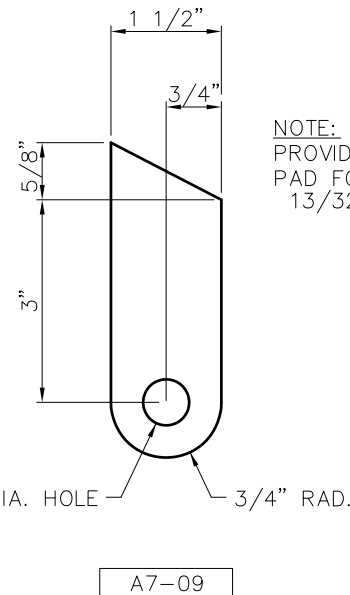



AS-BUILT

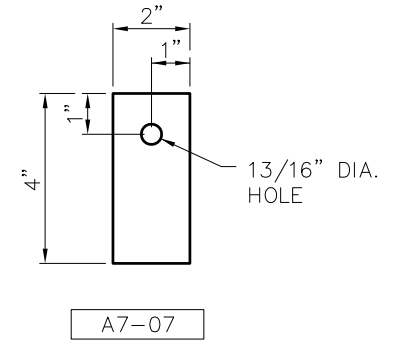

SHIPPING ITEM	QTY.	PC. MK.	QTY.	MATERIAL REQ'D	DESCRIPTION	UNIT WT.
A7-MP-24	1			24" DIA. PEDESTAL ACCESS MANHOLE		215
		A7-01	1	PL 1/8" x 2'-3" DIA.	COVER	
		A7-02	1	FB 1/8" x 2" x 6'-10 7/8" LG. (ROLL TO 26 1/2" OD)	BAR	
		A7-03	1	FB 1/8" x 2" x 12" (BENT)	HANDLE	
		A7-04	2	BY 3/4" DIA. x 1 1/2" LG.	M. BOLT w/NUT	
		A7-05	1	PI 24" OD x 3/4" x 11" LG.	STEEL TUBE	
		A7-06	2	PL 3/8"	HINGE	
		A7-07	2	FB 3/8" x 2" x 4" LG. w/13/16" HOLE	HINGE BAR	
		A7-08	1	BY 1/2" DIA. x 1 1/2" LG.	M. BOLT w/NUT	
		A7-09	1	PL 1/4" PLATE	LATCH	
		A7-10	1	PL 1/4" PLATE	LATCH	

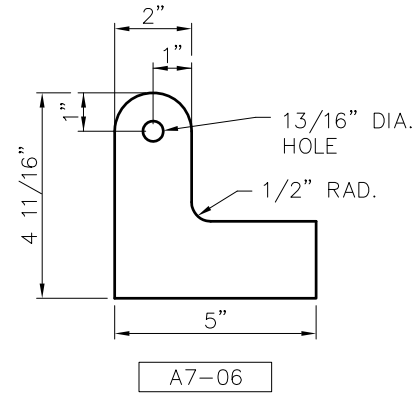

NOTE:
PROVIDE REINFORCEMENT
PAD FOR PEDESTAL THK.
13/32" & GREATER.

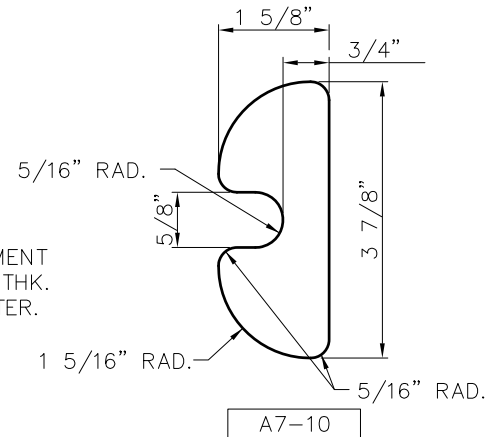

TITLE:
24" DIA. PEDESTAL ACCESS MANHOLE

DRAWING NO.:
A7