
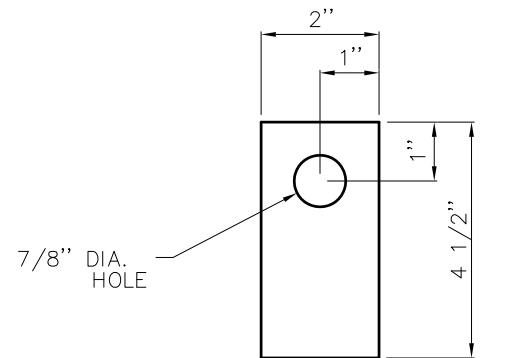


NOTE:

FIELD ADJUST CHAIN SUCH THAT MANHOLE COVER OPENS PAST VERTICAL BUT DOES NOT LAND ON ROOF OR ROOF ACCESSORY.

SHIPPING ITEM	QTY.	PC. MK.	QTY.	MATERIAL REQ'D	DESCRIPTION	UNIT WT.
B5-MR-30	1			30" DIA. ROOF MANHOLE		45
		B5-01	1	PL 11 GA. x 33" DIA.	COVER	
		B5-02	1	FB 1/8" x 2" x 8'-5 9/16" (ROLL TO 32 1/2" O.D.)	OVERLAPPING RING	
		B5-03	6	FB 3/8" x 2" x 4 1/2"	HINGE/ LATCH BAR	
		B5-04	3	BY 3/4" DIA. x 1 1/2" (ZINC PL.)	M. BOLT w/ NUT	
		B5-05	3	BY 3/4" DIA. BOLT ISOLATORS		
		B5-06	2	FB 1/8" x 2" x 12" (BENT)	HANDLE	
		B5-12	1	BY 1/8" X 31" OD X 29" ID	GASKET	
B5-CA-01	1			CHAIN ASSEMBLY		
		B5-08	1	BY 1/4" ELECTROGALVANIZED CHAIN 3'-0" LG	CHAIN	
		B5-09	1	BY 1/4" QUICK LINK		
		B5-10	1	BY SWIVEL HOOK		
		B5-11	1	BY 1/4" HALF CHAIN LINK		
B5-07	1			PI 30" O.D. x 1/4" x 6" LG.	NECK	40

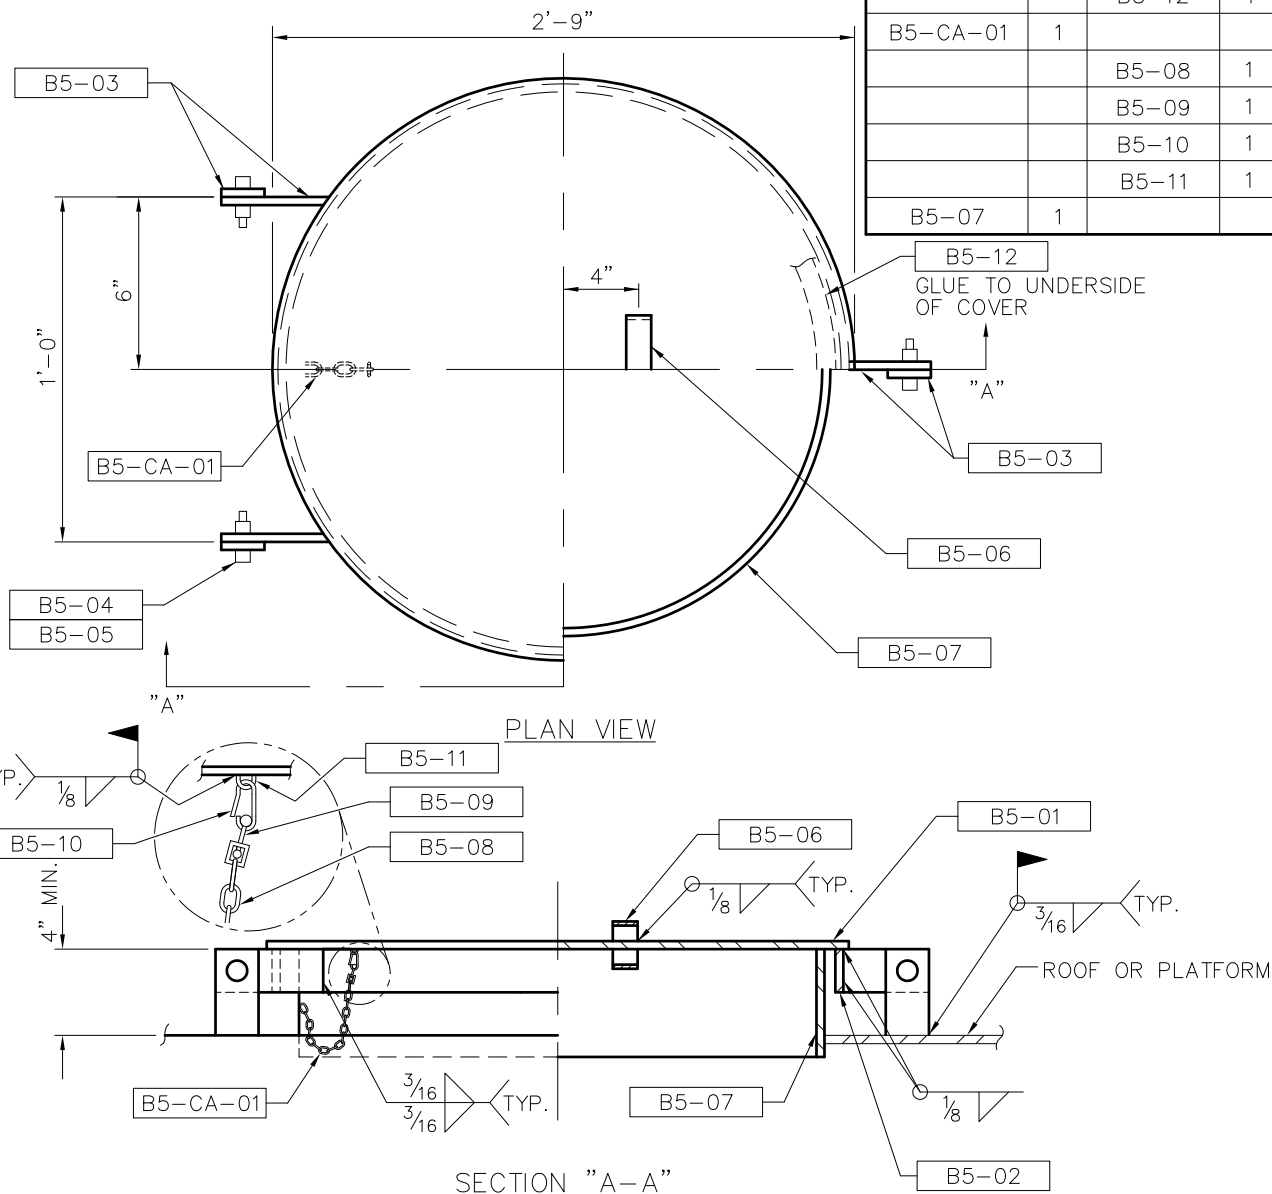

AS-BUILT



TITLE: 30" DIA. ROOF MANHOLE

DRAWING NO.: B5