


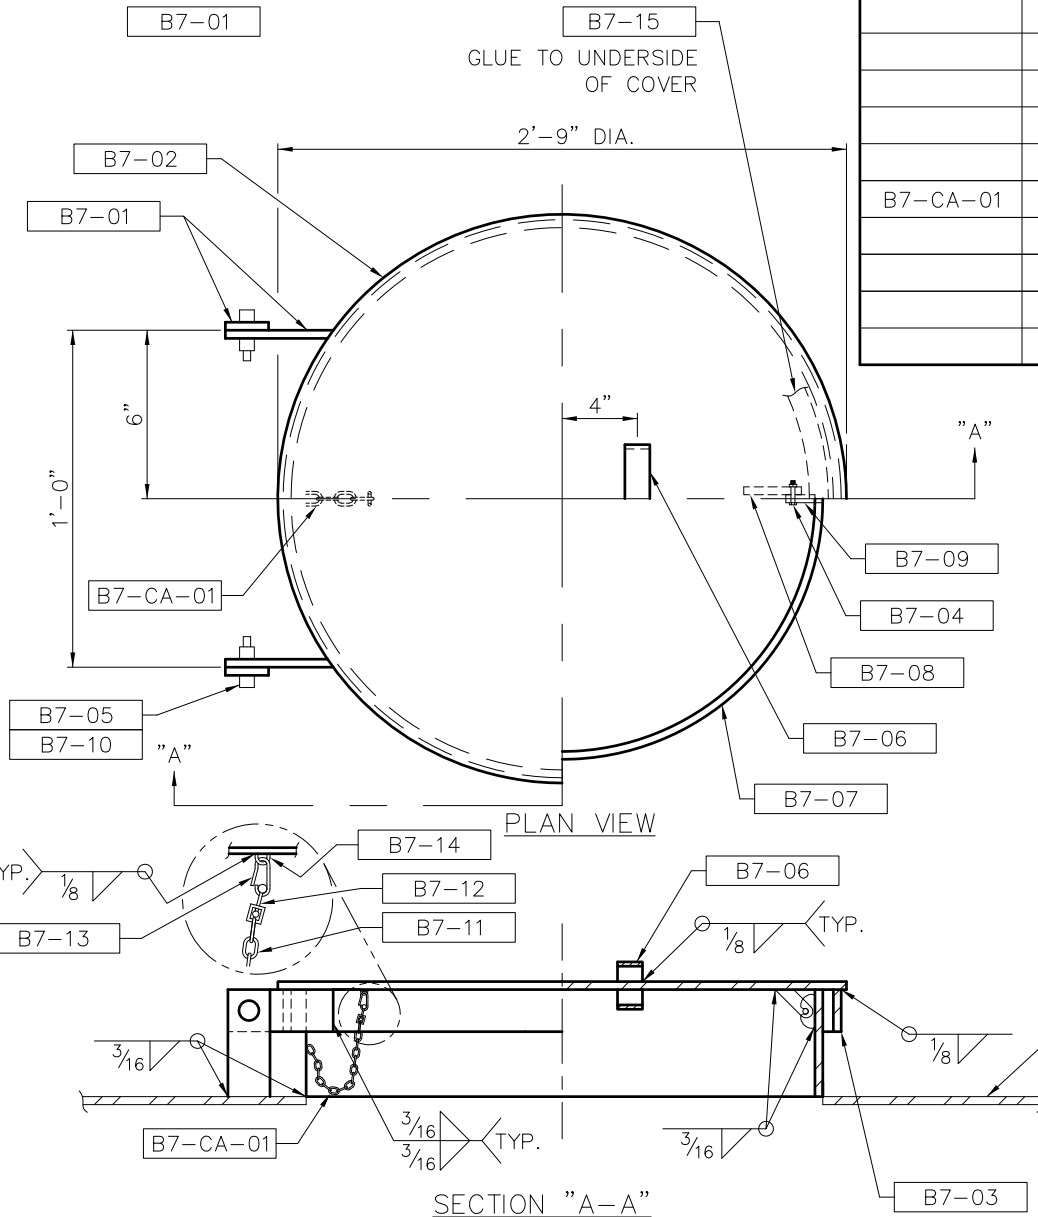


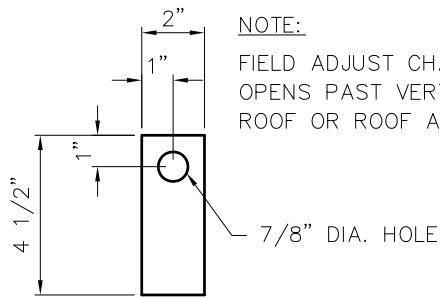

SHIPPING ITEM	QTY.	PC. MK.	QTY.	MATERIAL REQ'D	DESCRIPTION	UNIT WT.
B7-MT-30	1			30" DIA. ACCESS TUBE ROOF MANHOLE		80
		B7-01	4	FB 3/8" x 2" x 4 1/2"	HINGE BAR	
		B7-02	1	PL 11 GA. x 33" DIA.	COVER	
		B7-03	1	FB 1/8" x 2" x 8'-5 9/16" LG. (ROLL 32 1/2" O.D.)	OVERLAPPING RING	
		B7-04	1	BY 1/2" DIA. x 1 1/2" (ZINC PL.)	M. BOLT w/NUT	
		B7-05	2	BY 3/4" DIA. x 1 1/2" (ZINC PL.)	M. BOLT w/NUT	
		B7-06	2	FB 1/8" x 2" x 12" (BENT)	HANDLE	
		B7-07	1	PI 30" OD x 1/4" x 6" LG.	NECK	
		B7-08	1	PL 1/4"	LATCH	
		B7-09	1	PL 1/4"	LATCH	
		B7-10	2	BY 3/4" DIA. BOLT ISOLATORS		
		B7-15	1	BY 1/8" x 31" OD x 29" ID	GASKET	
B7-CA-01	1			CHAIN ASSEMBLY		
		B7-11	1	BY 1/4" ELECTROGALVANIZED CHAIN 3'-0" LG.	CHAIN	
		B7-12	1	BY 1/4" QUICK LINK		
		B7-13	1	BY SWIVEL HOOK		
		B7-14	1	BY 1/4" HALF CHAIN LINK		

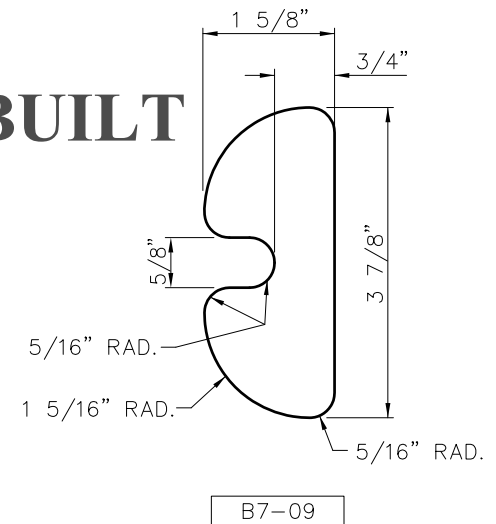

AS-BUILT

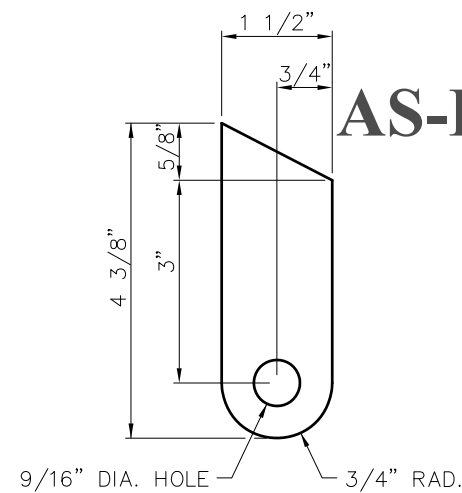

TITLE:
30" DIA. ACCESS TUBE ROOF MANHOLE

DRAWING NO.:
B7