


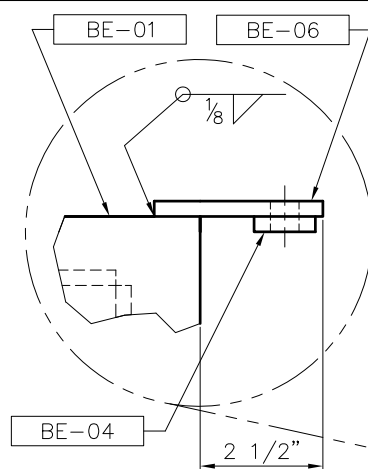
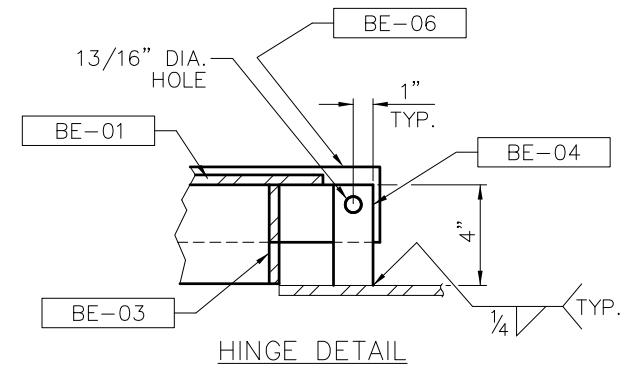


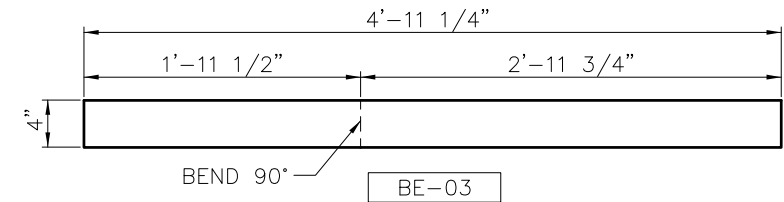


SHIPPING ITEM	QTY.	PC. MK.	QTY.	MATERIAL REQ'D	DESCRIPTION	UNIT WT.
BE-ME-36	1			24" x 36" PLATFORM MANHOLE w/	END HINGE	65
		BE-01	1	PL 11 GA. x 2'-2 1/4" x 2'-9" LG.	COVER PLATE	
		BE-02	1	FB 1/8" x 2" x 12" (BENT)	HANDLE	
		BE-03	2	FB 1/4" x 4" x 4'-11 1/4"	NECK	
		BE-04	2	FB 3/8" x 2" x 4" LG	HINGE BAR	
		BE-05	2	BY 3/4" DIA. x 1 1/2" (ZINC PL.)	M. BOLT w/ NUT	
		BE-06	2	FB 3/8" x 3" x 12" LG.	REINF. BAR	

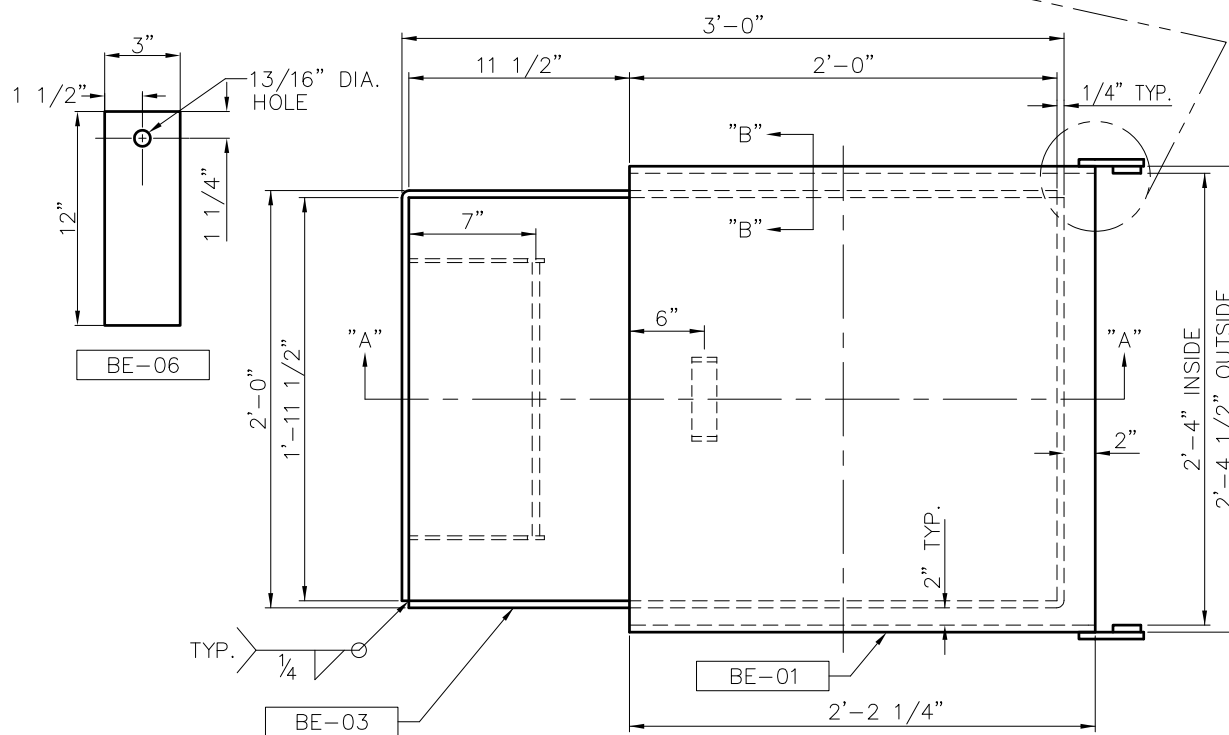

AS-BUILT

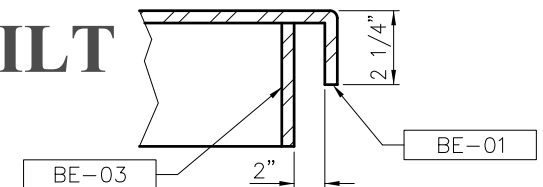

SECTION "B-B"

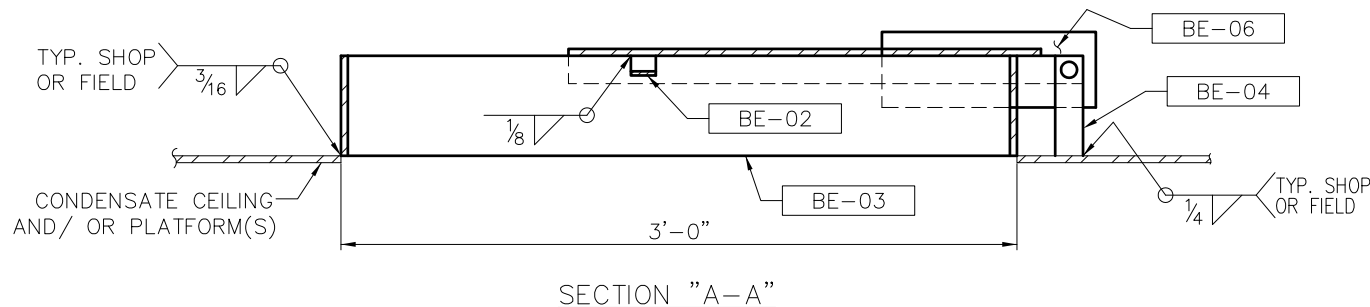

TITLE: 24" x 36" PLATFORM
MANHOLE w/ END HINGE

DRAWING NO.: BE