



(36) 1/4" DIA. HOLES ON  
33 1/2" DIA. BOLT CIRCLE FOR

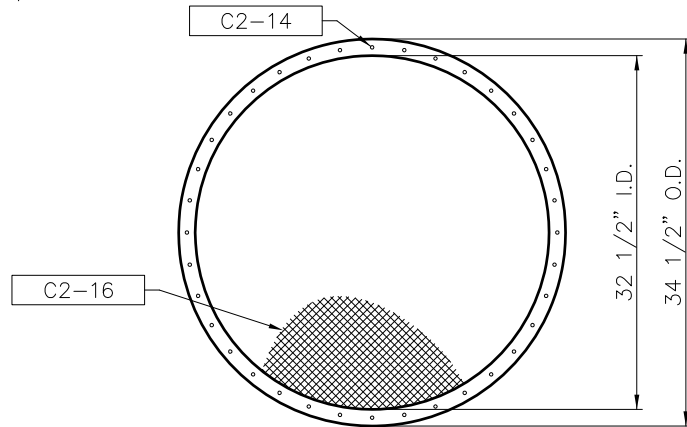

UPPER PALLET RING/SCREEN

C2-08

(36) 1/4" DIA. HOLES  
ON A 31 1/4" BOLT CIRCLE FOR

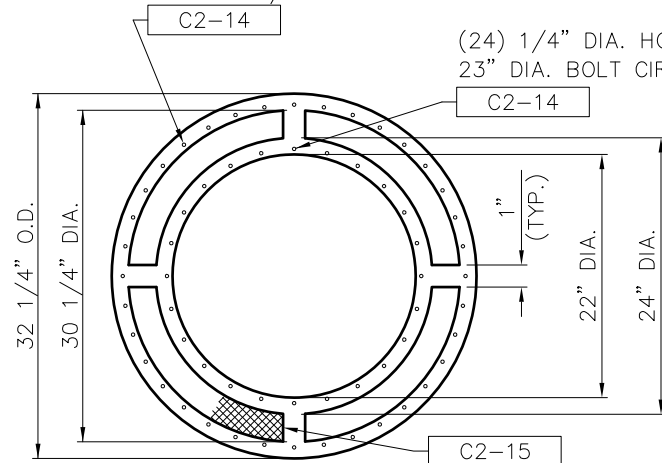


LOWER PALLET RING/SCREEN

C2-04

#### NOTES:

1. SCREEN PALLETS TO BE MADE FROM 3/8" THK. HDPE MATERIAL (WHITE).
2. SCREENS TO BE FASTENED DOWN BY NYLON PUSH IN RIVETS (1/4" x 0.437" LG. BLACK FLAT HEAD RIVET) PART C2-14.
3. SEE DWG. C2 FOR ADDITIONAL DETAILS.
4. PALLET SCREENS TO BE EXTRUDED POLYESTER SUPER SCREEN (UV RESISTANT 17/14 MESH).

| SHIPPING ITEM | QTY. | PC. MK. | QTY. | MATERIAL REQ'D                                   | DESCRIPTION          | UNIT WT. |
|---------------|------|---------|------|--------------------------------------------------|----------------------|----------|
| C2-PV-24      | 1    |         |      | 24" DIA. VENT                                    |                      | 480      |
|               |      | C2-01   | 1    | PI 1/4" x 24" O.D. x 1'-6" LG.                   | VENT NECK            |          |
|               |      | C2-02   | 1    | PI 1/4" x 36" O.D. x 10" LG.                     | VENT BODY            |          |
|               |      | C2-03   | 1    | PL 1/4" x 37" O.D. x 30" I.D.                    | PLATE RING           |          |
|               |      | C2-04   | 1    | BY 3/8" x 32 1/4" O.D. x 22" I.D.                | LOWER PALLET RING    |          |
|               |      | C2-07   | 1    | PL 1/4" x 35 1/4" O.D. x 33 1/2" I.D.            | PLATE RING           |          |
|               |      | C2-08   | 1    | BY 3/8" x 34 1/2" O.D. x 32 1/2" I.D.            | UPPER PALLET RING    |          |
|               |      | C2-09   | 1    | PL 3/16" x 42" DIA.                              | COVER PLATE          |          |
|               |      | C2-10   | 1    | FB 3/16" x 1" x 99 3/4" LG. (ROLLED TO 32" O.D.) | PALLET SUPPORT       |          |
|               |      | C2-11   | 1    | FB 3/16" x 1" x 106" LG. (ROLLED TO 34" O.D.)    | PALLET SUPPORT       |          |
|               |      | C2-12   | 4    | FB 1/4" x 1" x 6" LG.                            | BAR RING SUPPORT     |          |
|               |      | C2-13   | 8    | FB 1/4" x 4" x 5" LG.                            | VENT GUSSET          |          |
|               |      | C2-14   | 96   | BY 1/4" x 0.437" BLACK FLAT HEAD                 | PUSH IN RIVET        |          |
|               |      | C2-15   | 1    | BY 32 1/4" O.D. x 22" I.D. (SEE NOTE 4)          | LOWER SCREEN         |          |
|               |      | C2-16   | 1    | BY 34 1/2" O.D. (SEE NOTE 4)                     | UPPER SCREEN         |          |
|               |      | C2-17   | 1    | BY 9" x 9'-6" FLATTENED EXP. METAL               | VENT BODY SCREEN     |          |
|               |      | C2-18   | 1    | AN 1/4" x 2" x 2" x 9'-5 1/16"                   | (ROLLED TO 36" O.D.) |          |
|               |      | C2-19   | 1    | FB 3/16" x 12" x 10'-8 1/4" LG.                  | SCREEN SHIELD        |          |
|               |      | C2-20   | 3    | BY 1/2" DIA. x 1 1/2" (ZINC PL.)                 | LATCH BOLT w/NUT     |          |
|               |      | C2-21   | 8    | FB 1/4" x 2" x 8" LG.                            | BAR                  |          |

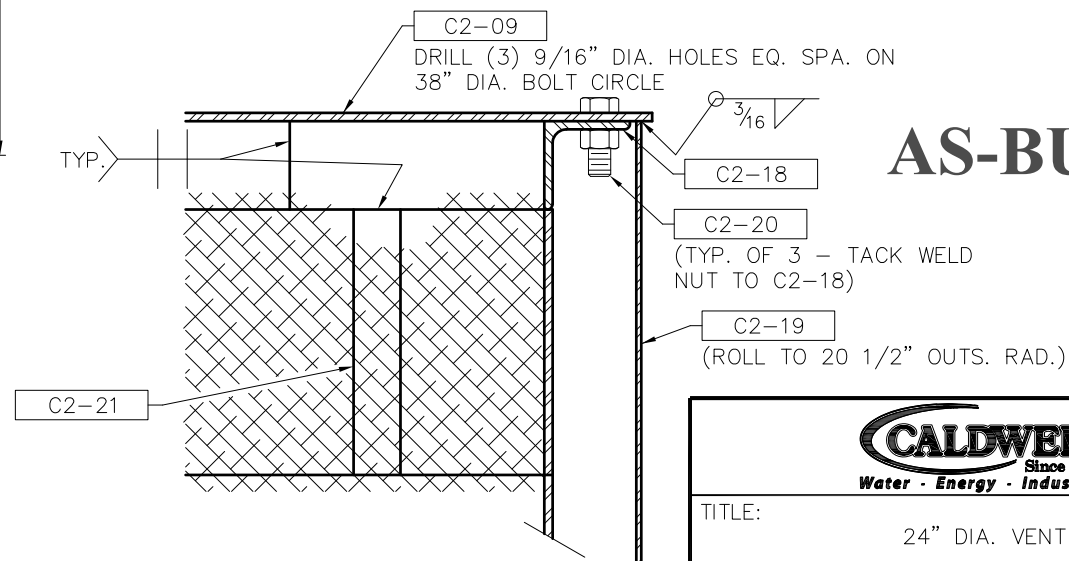

VENT COVER ATTACHMENT DETAIL  
(INSIDE VIEW)

AS-BUILT



TITLE:

24" DIA. VENT

DRAWING NO.:

C2-A