




SHIPPING ITEM	QTY.	PC. MK.	QTY.	MATERIAL REQ'D	DESCRIPTION	UNIT WT.
BG-MF-24	1			24" DIA. EXHAUST FAN MANHOLE		115
		BG-01	1	PL 11 GA. x 33" DIA. (w/ HOLES)	COVER	
		BG-02	1	PL 1/4" x 33" O.D. x 24" I.D. (w/ HOLES)	FLANGE	
		BG-03	1	PI 24" O.D. x 1/4" x 6" LG.	NECK	
		BG-04	4	BY 3/4" DIA. x 1 1/2" (ZINC. PL.)	M. BOLT w/ NUT	
		BG-05	2	FB 1/8" x 2" x 12" (BENT)	HANDLE	
		BG-06	1	BY 1/4" ELECTROGALVANIZED CHAN x 1'-0" LG.	CHAIN	
		BG-07	1	BY 1/8" x 2'-9" O.D. x 2'-0" I.D.	GASKET	

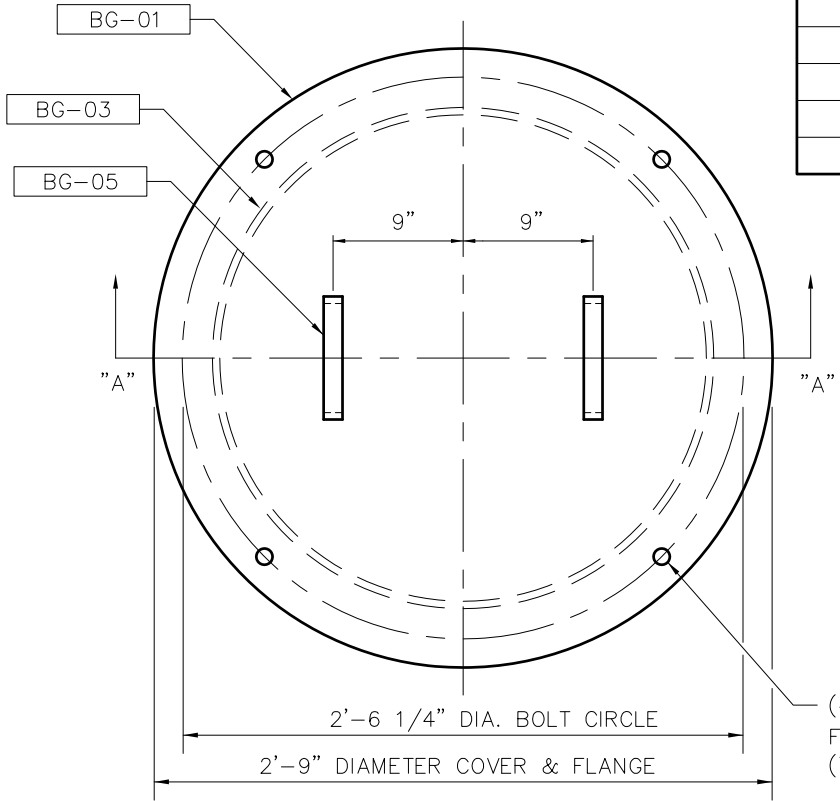

PLAN VIEW

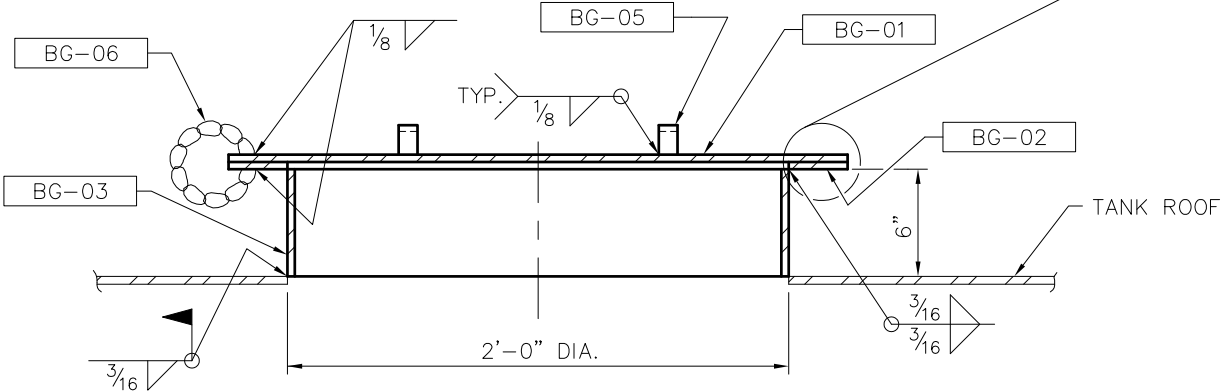

SECTION "A-A"

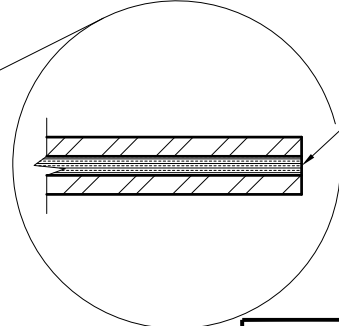

BG-07

AS-BUILT



TITLE:	24" DIA. EXHAUST FAN MANHOLE
DRAWING NO.:	BG