


SHIPPING ITEM	QTY.	PC. MK.	QTY.	MATERIAL REQ'D.	DESCRIPTION	UNIT WT.
M2-CD-02	1			CONDENSATE CEILING DRAIN w/CHECK VALVE (PEDESPHERE)		
		M2-01	2	PI 2" DIA. SCH 40 x 6" (THRD. ONE END)	PIPE	
		M2-02	1	PI 2" DIA. SCH 40 x 6" (PE x PE)	PIPE	
		M2-03	1	BY 2" CHECK VALVE (THRD. ENDS)	CHECK VALVE	
		M2-04	1	BY 2 3/8" I.D. x 3'-0" LG.	RUBBER HOSE	
		M2-05	4	BY FOR 2 3/8" I.D. HOISING (ALL PARTS S.S.)	HOSE CLAMPS	



AS-BUILT

NOTE:
USE TEFLON TAPE FOR
ALL THREADED CONNECTIONS.

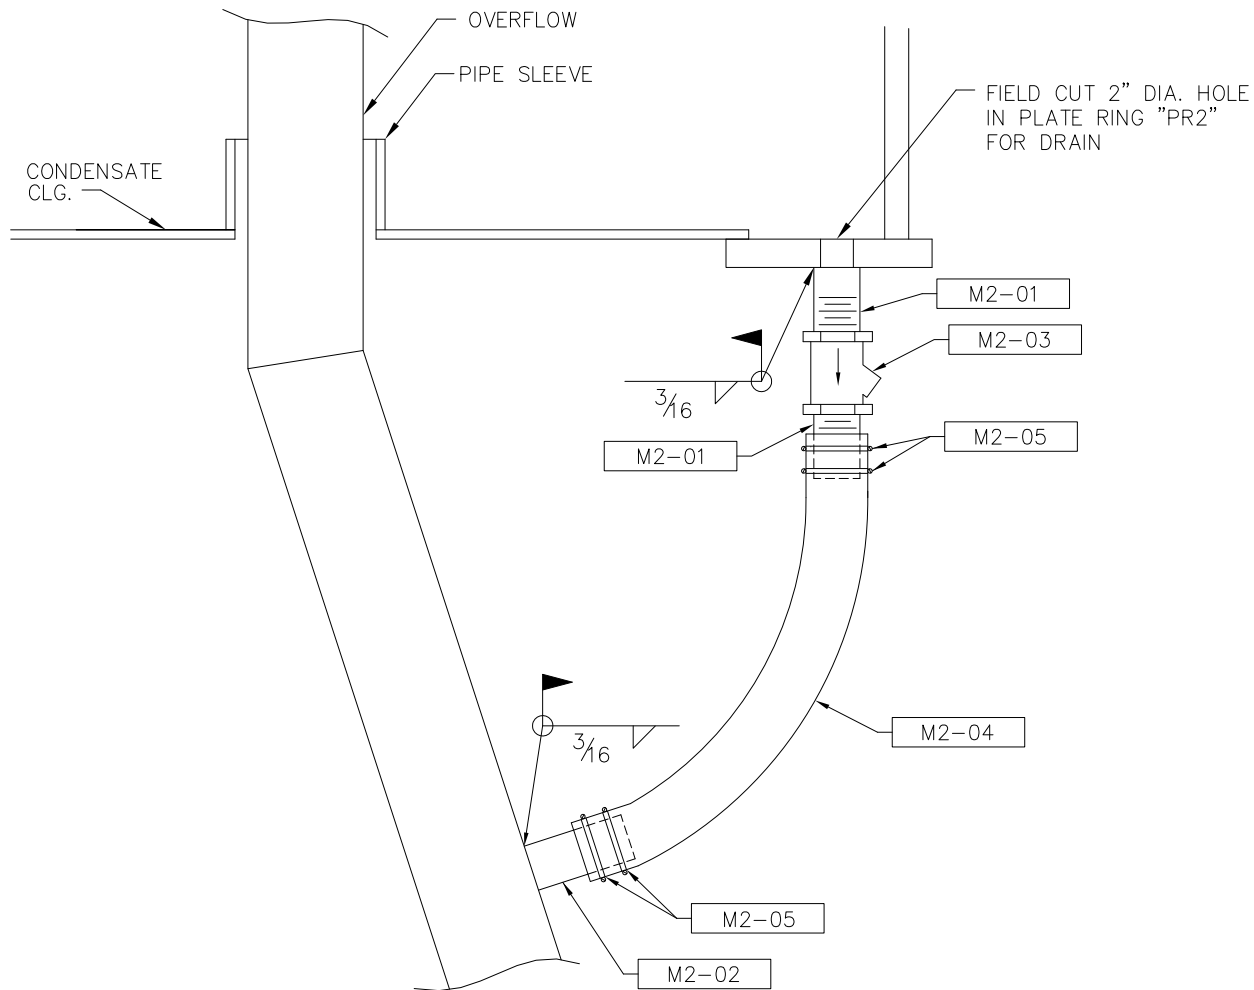

TITLE:
CONDENSATE CEILING DRAIN w/CHECK VALVE
(PEDESPHERE)

DRAWING NO.:
M2