
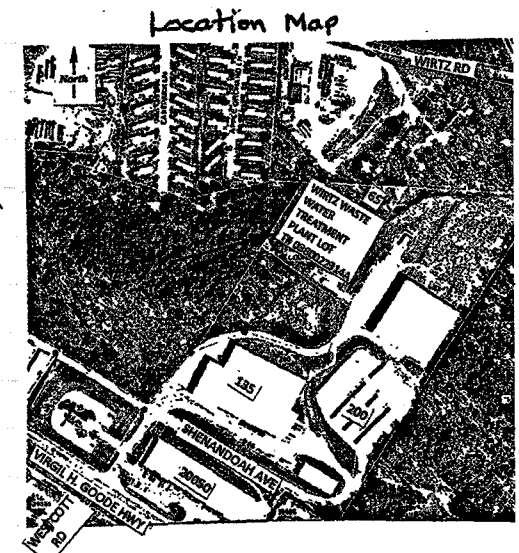


WIRTZ TREATMENT PLANT

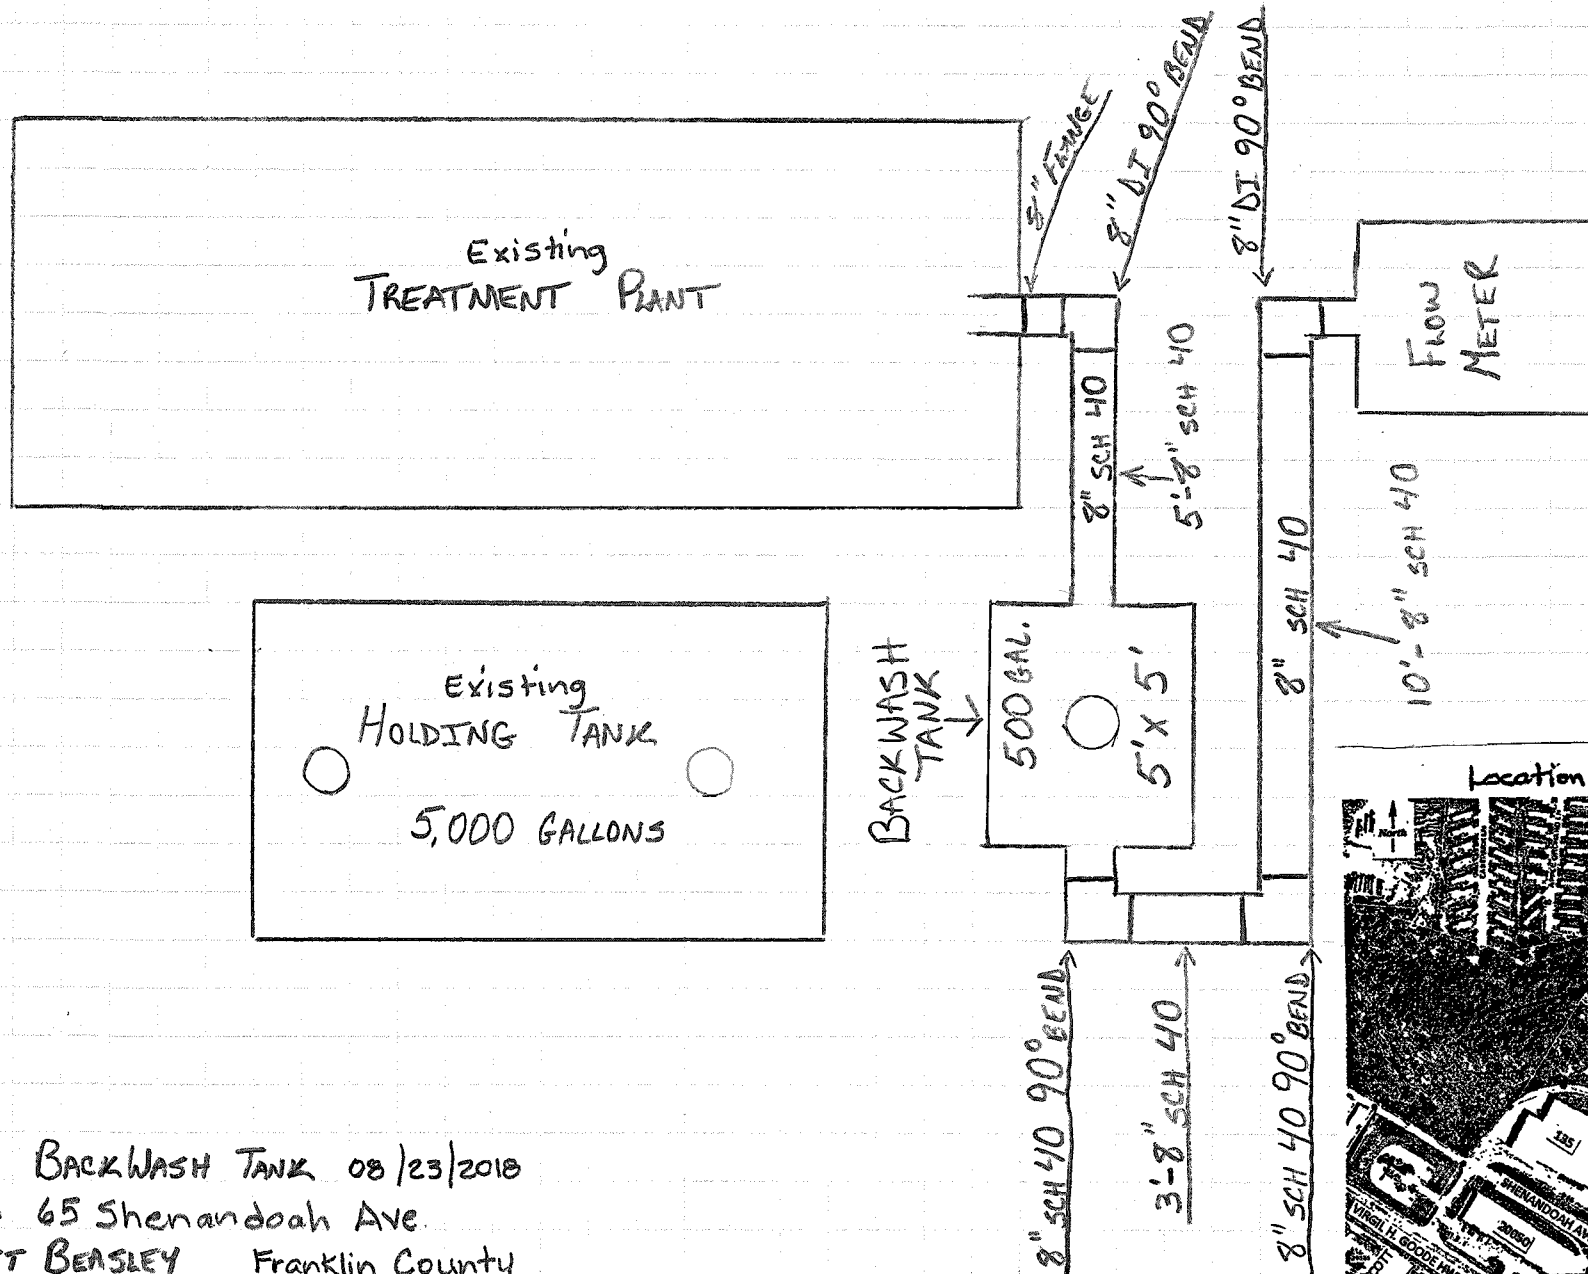

ASBUILT FOR BACKWASH TANK 08/23/2018
 T# 0360022314A 65 Shenandoah Ave.
 CIP 2 - TAFT BEASLEY Franklin County