



PLAN	BY	DATE
SURVEYED		
PLOTTED		
CHECKED		
NO.		

PROFILE	BY	DATE
SURVEYED		
PLOTTED		
CHECKED		
NO.		

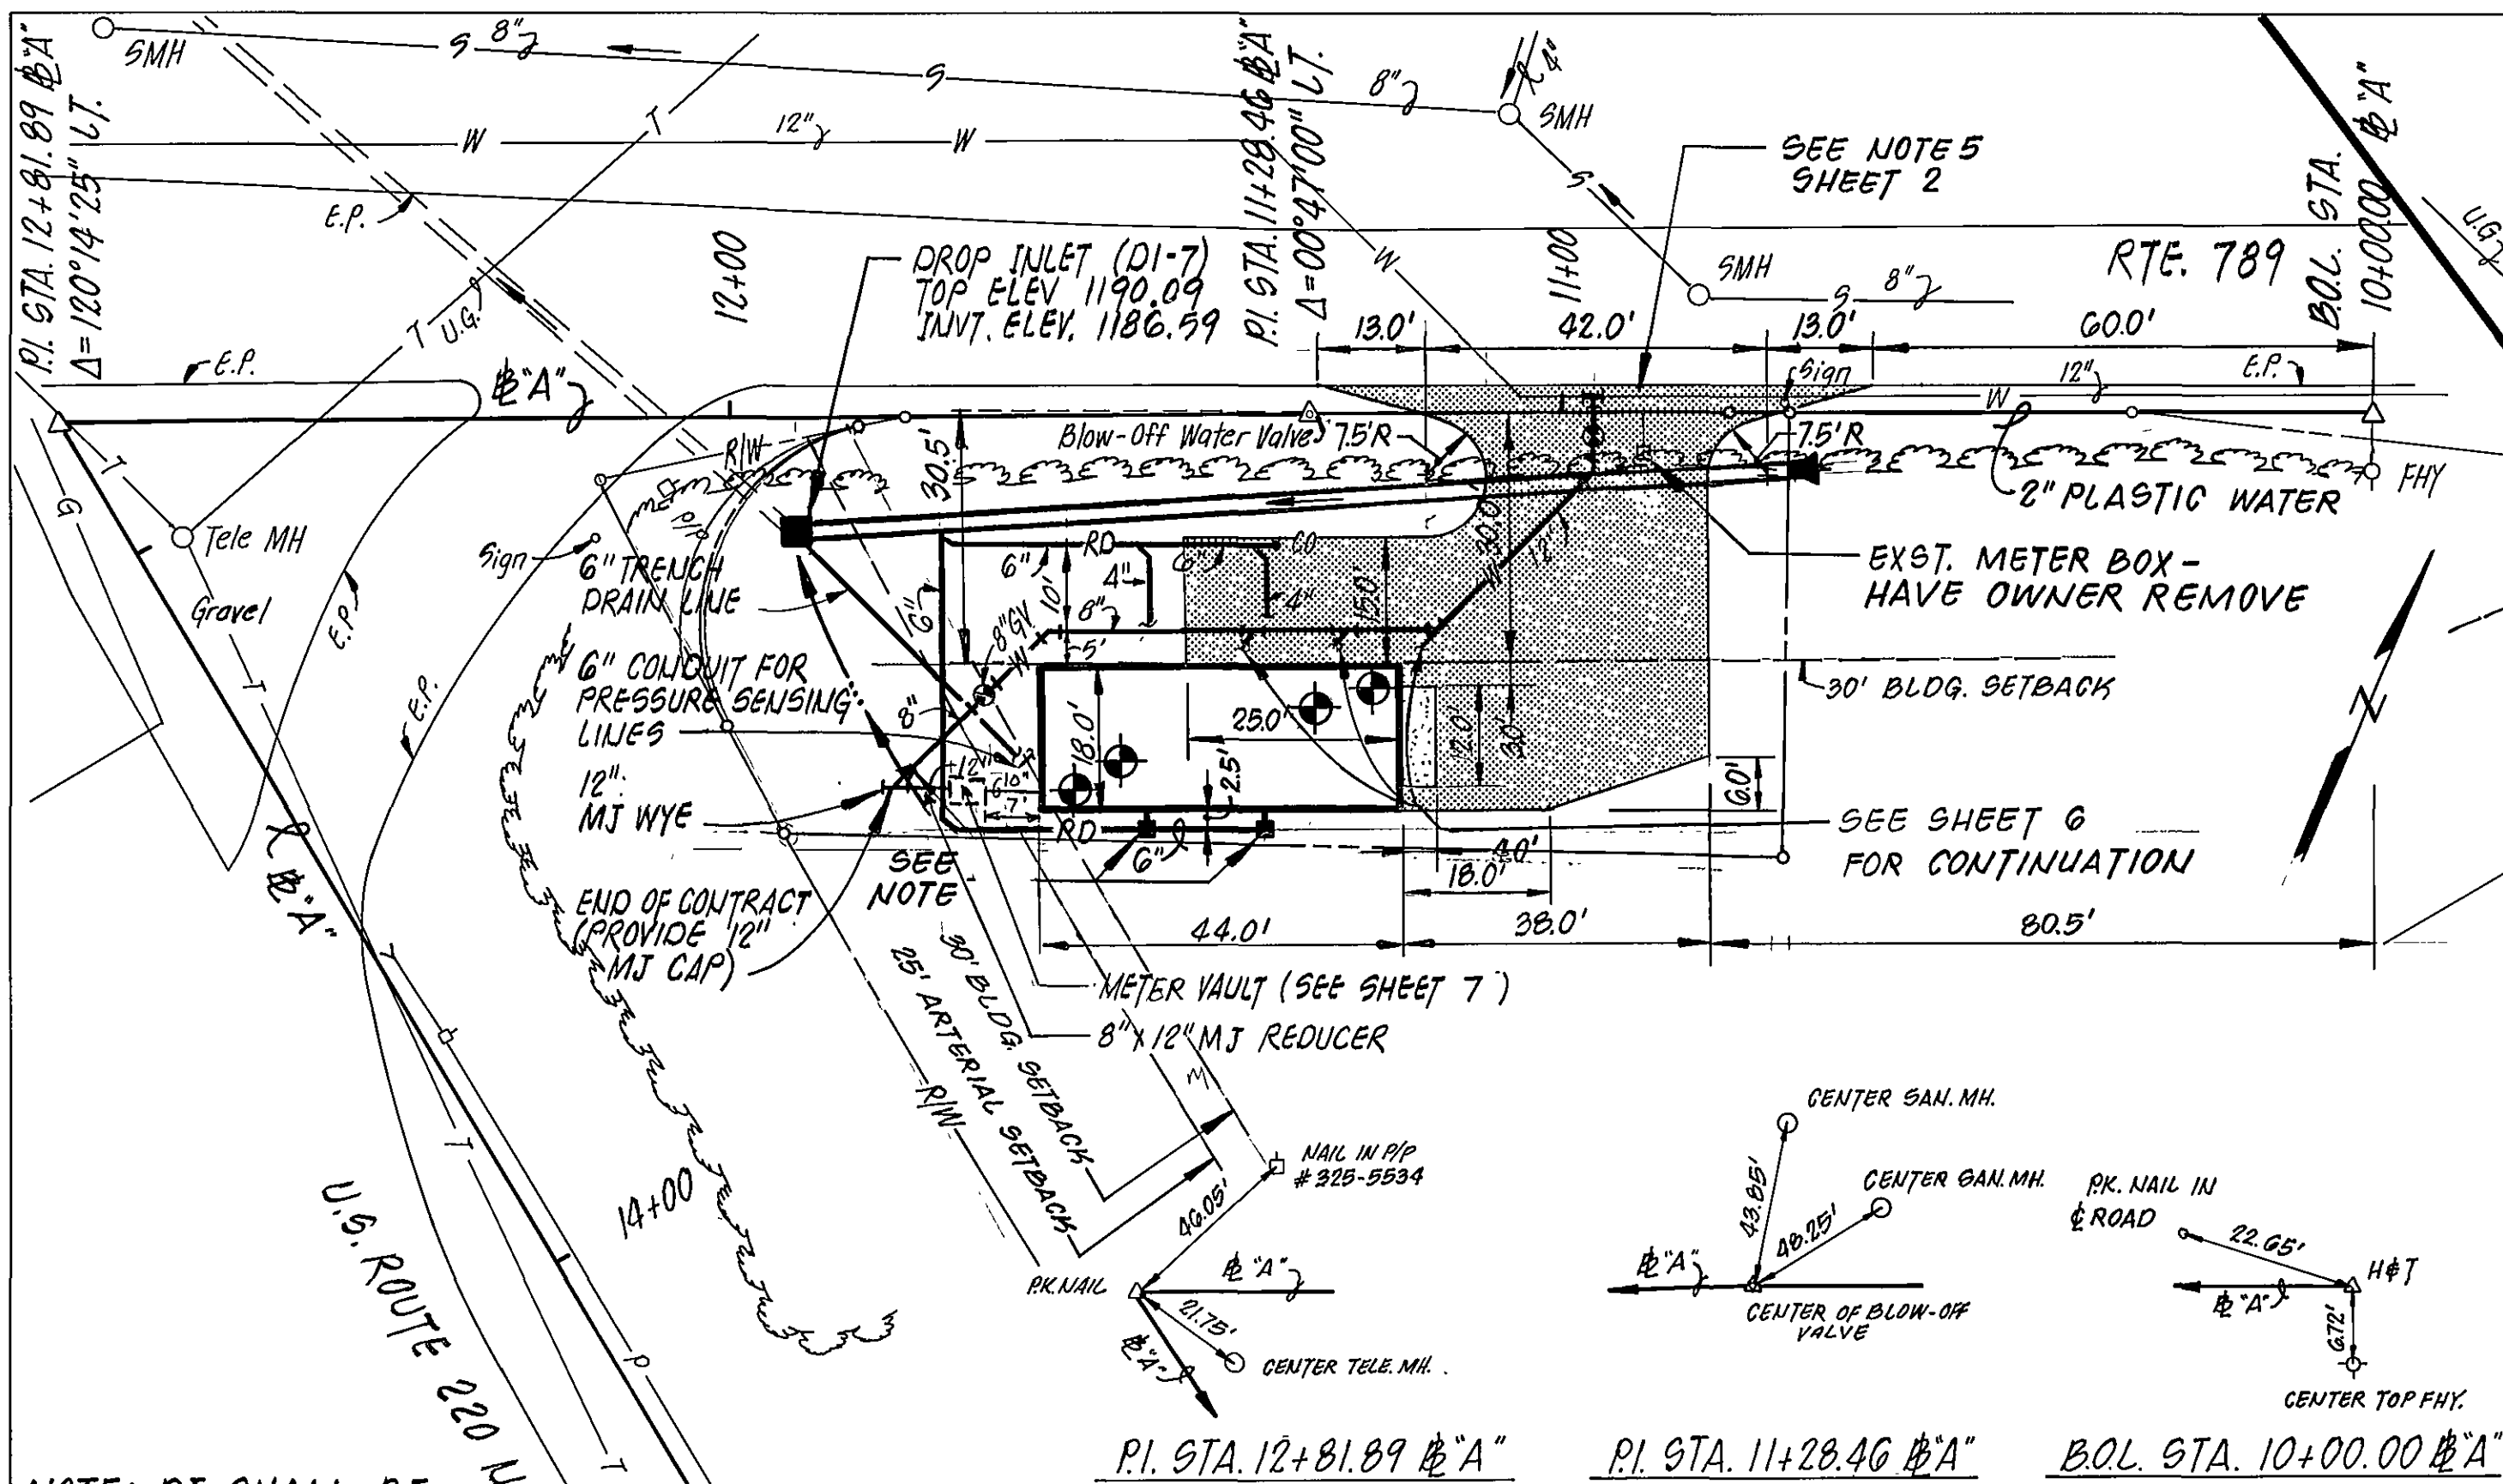


NOTE: DI SHALL BE ACO DRAIN NO. 900 G CATCH BASIN OR EQUAL WITH GALVANIZED GRATE TOP WITH KNOCKOUTS FOR 6" PIPE.

DIMENSIONAL LAYOUT AND UTILITIES
SCALE: 1" = 20'

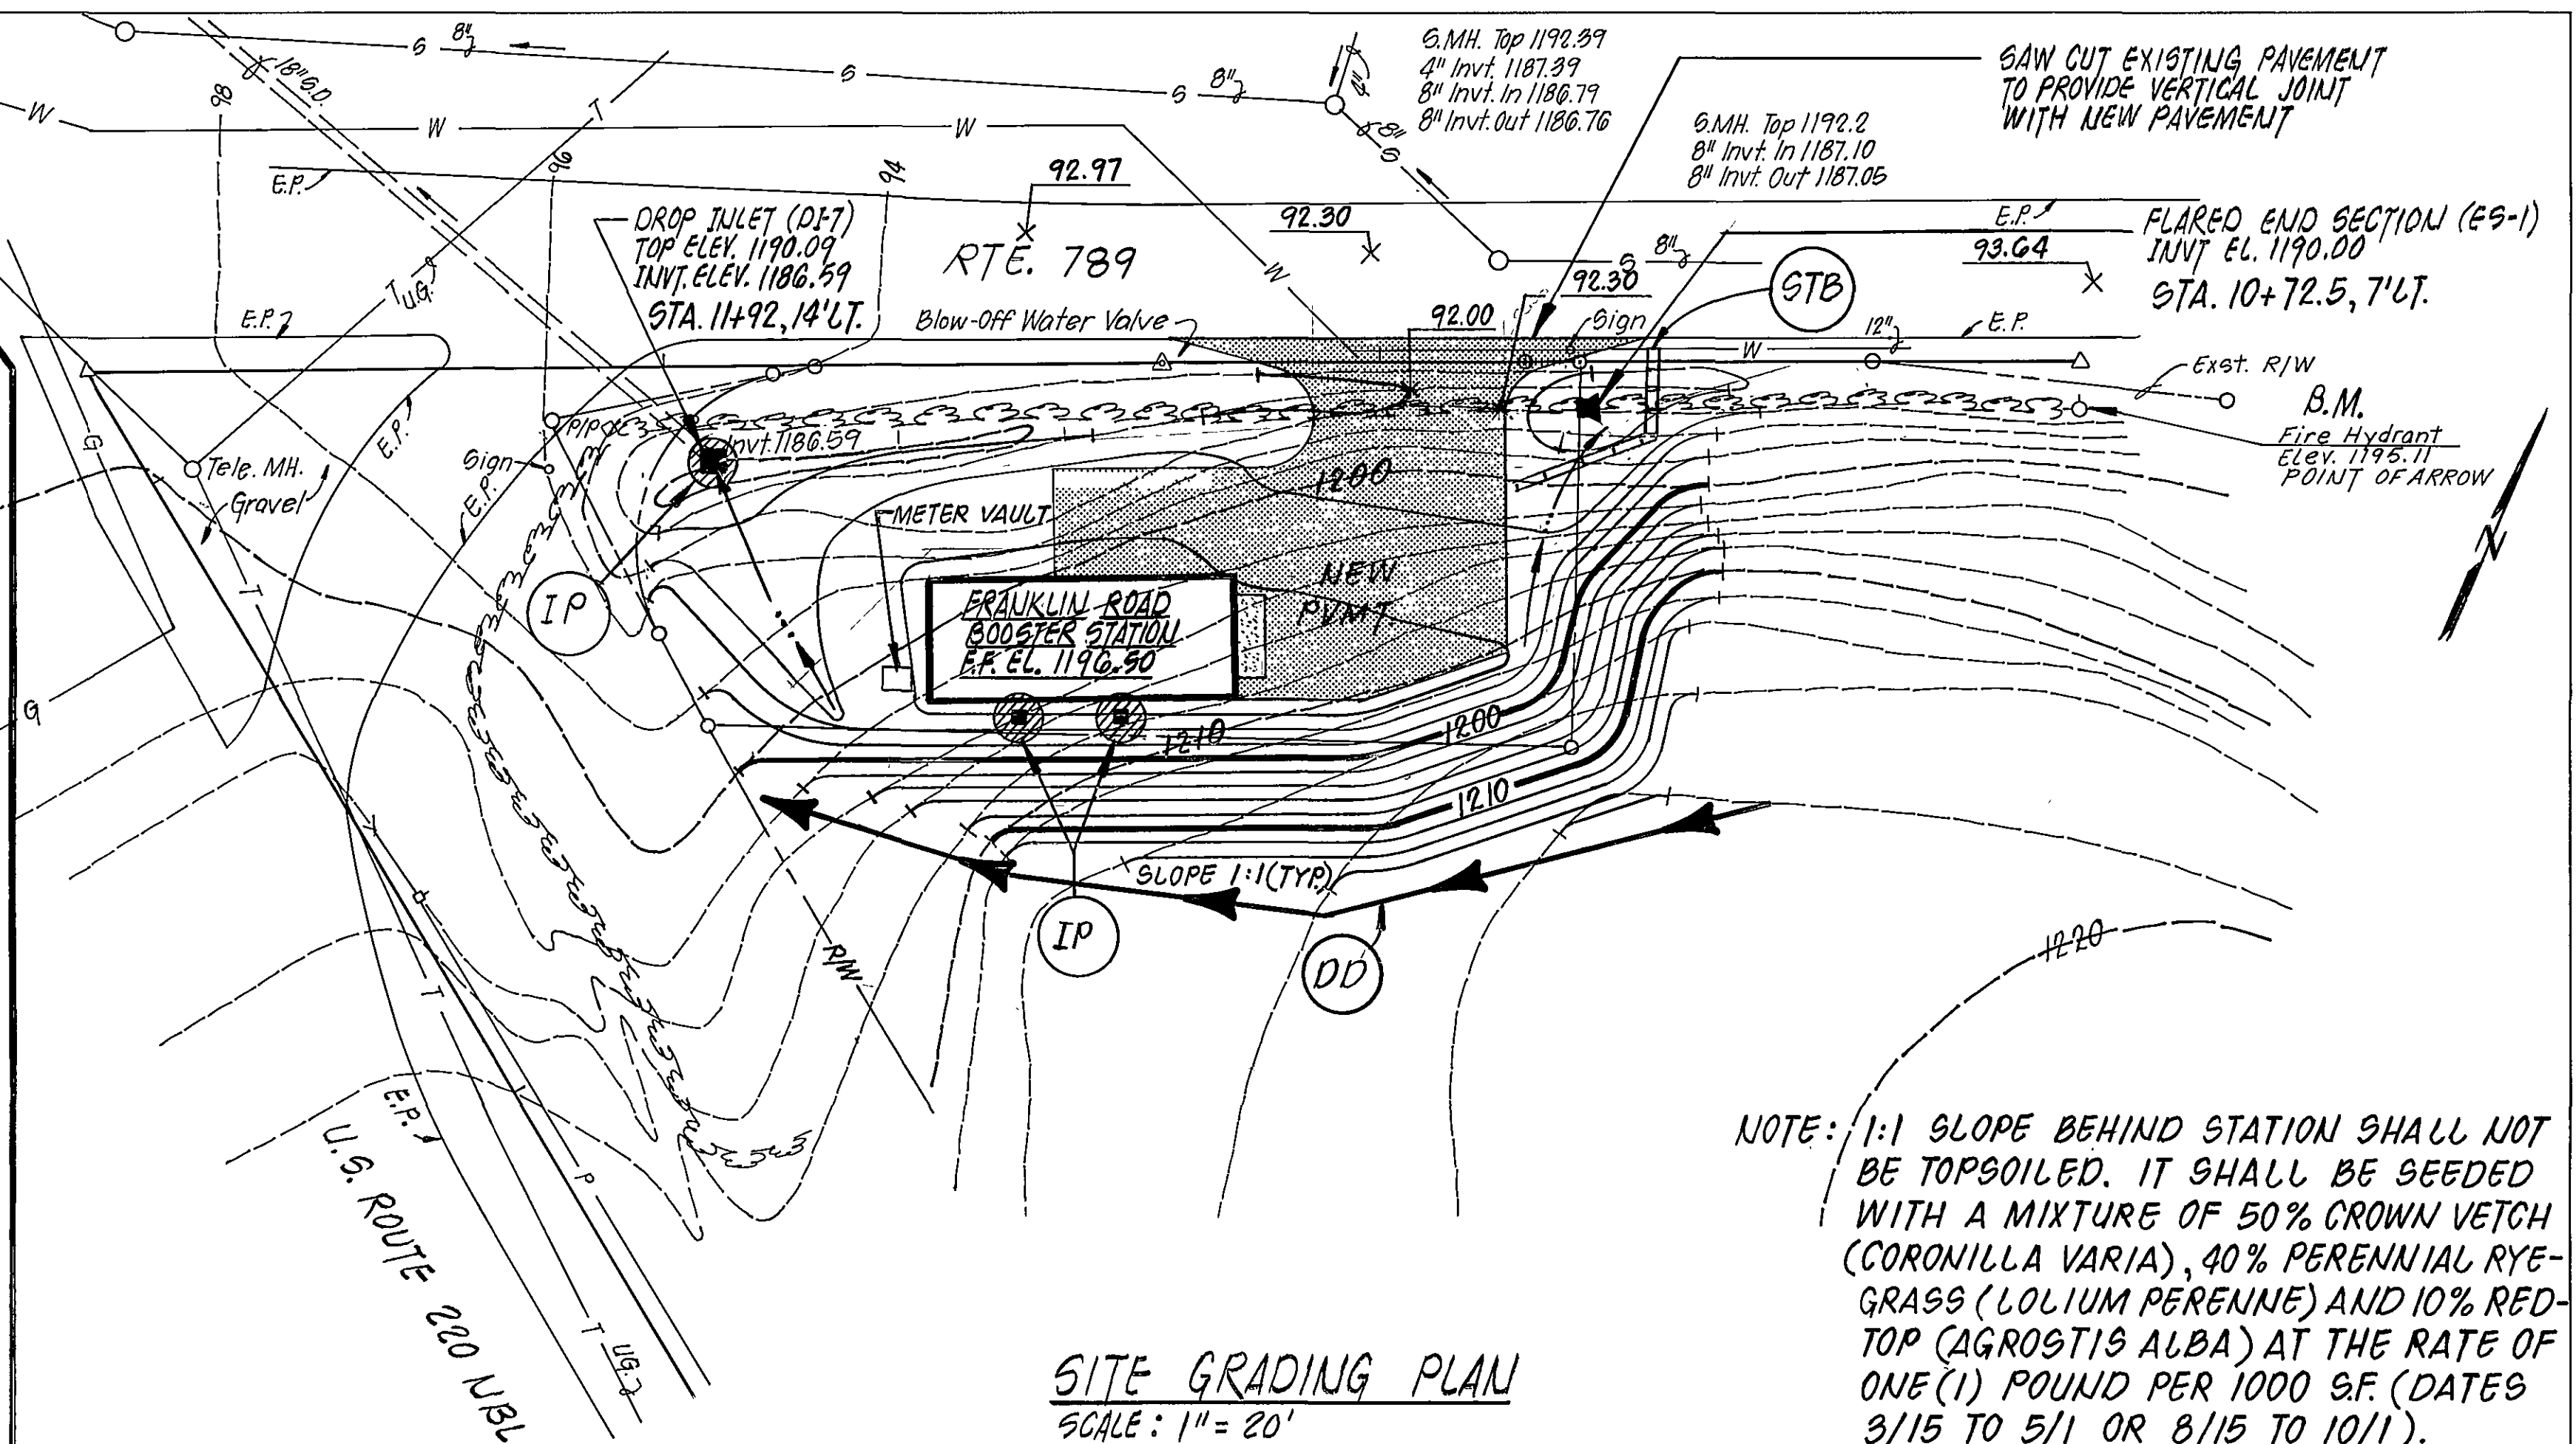


NOTE: 1:1 SLOPE BEHIND STATION SHALL NOT BE TOPSOILED. IT SHALL BE SEEDED WITH A MIXTURE OF 50% CROWN VETCH (CORONILLA VARIA), 40% PERENNIAL RYEGRASS (LOLIUM PERENNE) AND 10% REDTOP (AGROSTIS ALBA) AT THE RATE OF ONE (1) POUND PER 1000 S.F. (DATES 3/15 TO 5/1 OR 8/15 TO 10/1).

SITE GRADING PLAN
SCALE: 1" = 20'

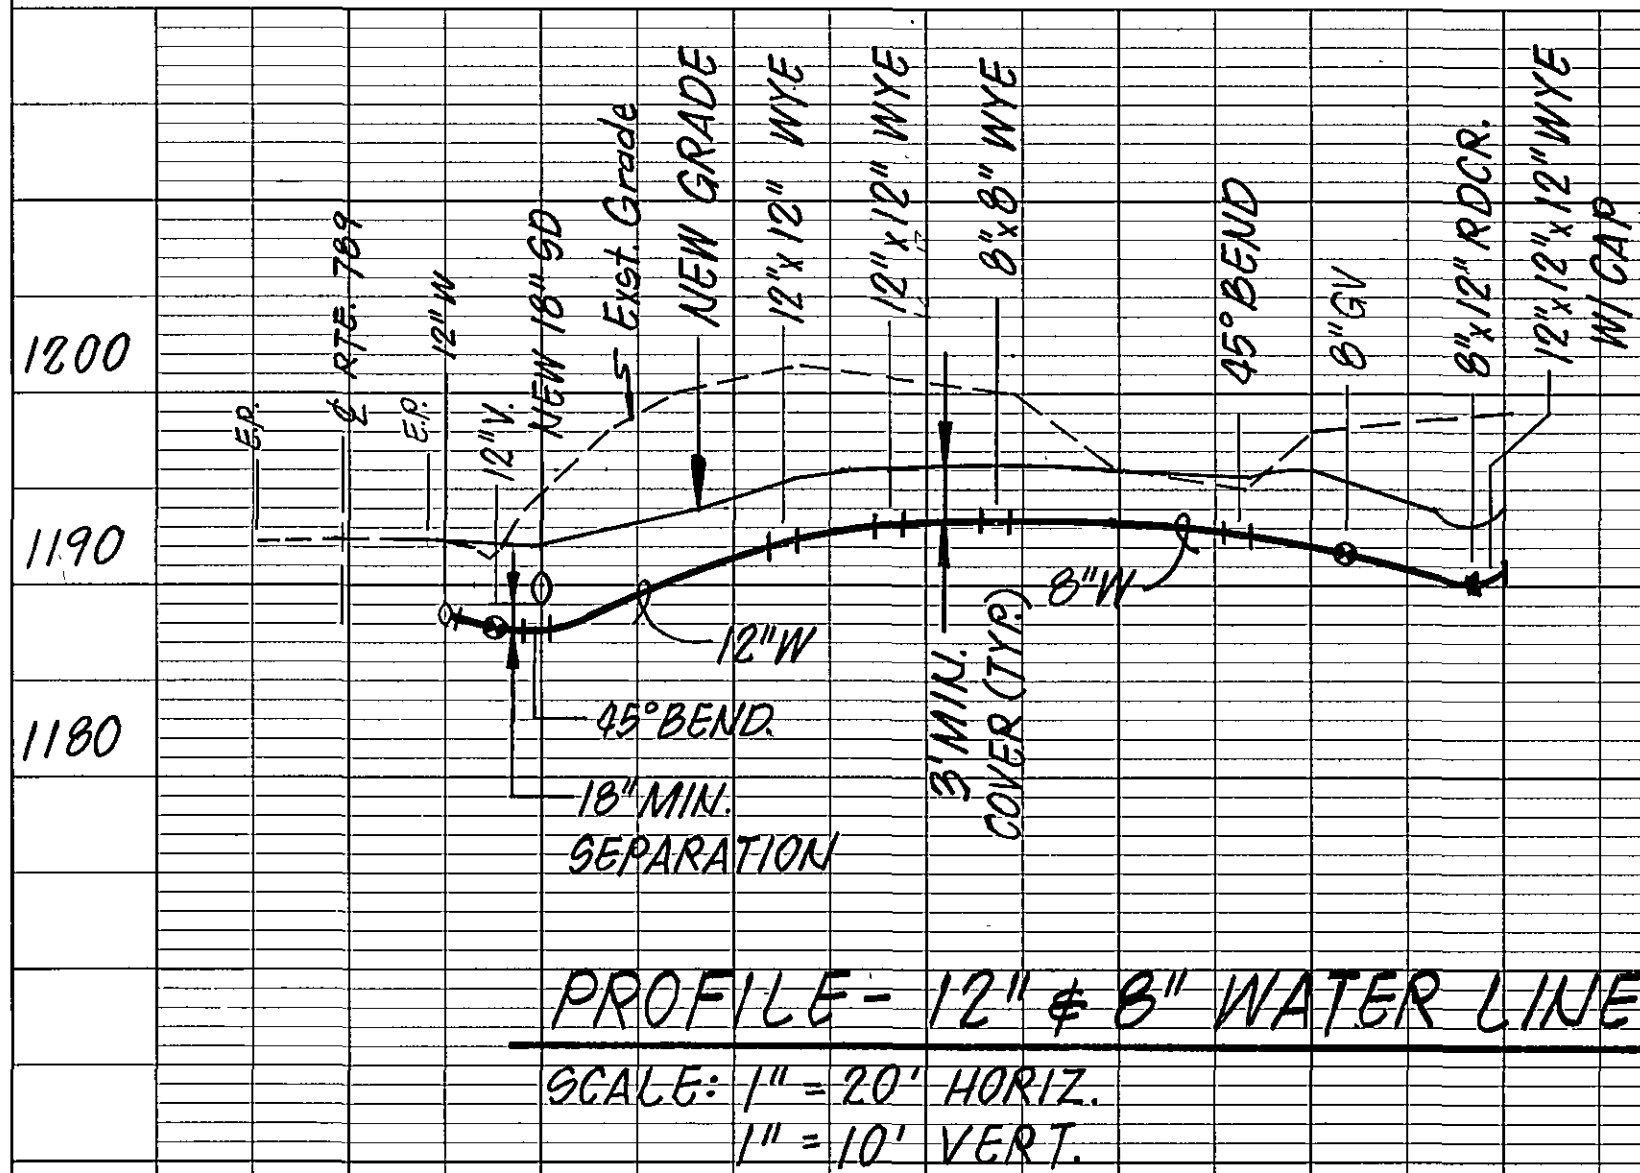


PROFILE - 12" & 8" WATER LINE
SCALE: 1" = 20' HORIZ.
1" = 10' VERT.

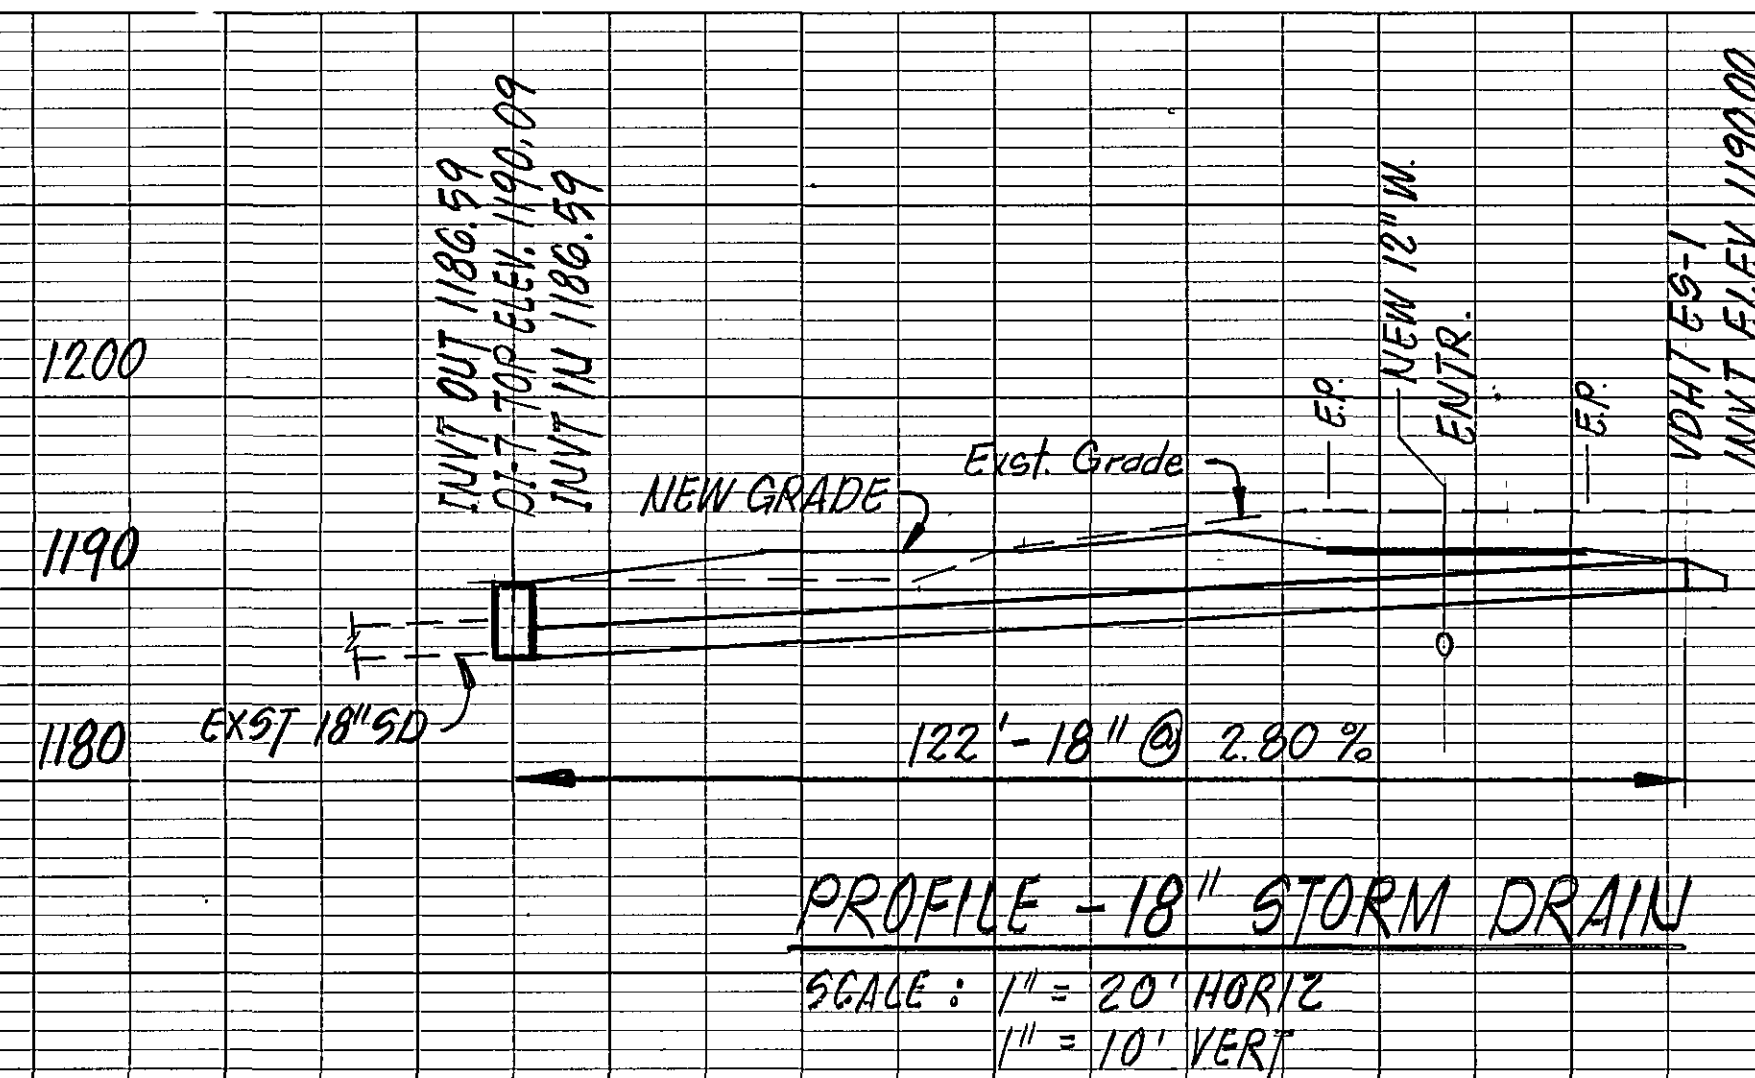

PROFILE - 18" STORM DRAIN
SCALE: 1" = 20' HORIZ.
1" = 10' VERT.

RECORD DRAWING

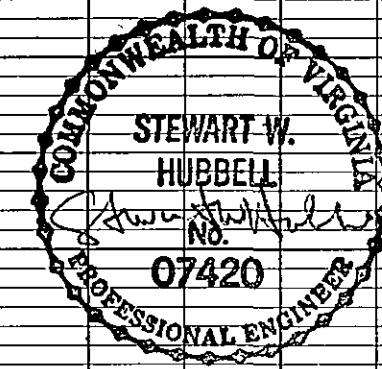

DESIGNED	W.J.J.	DATE	5/15/80	DESCRIPTION	REVISED SLOPE BEHIND STATION	BY	ARB	APP.	SWH
DRAWN	ARB								
CHECKED	SWH								
APPROVED									
SUBMITTED									
				FRANKLIN ROAD BOOSTER PUMPING STATION					
				SITE PLAN					
				SCALE	NOTED	COMM NO.	565		
				DATE	DEC. 85	SHEET	3		

Mattern & Craig
CONSULTING ENGINEERS