
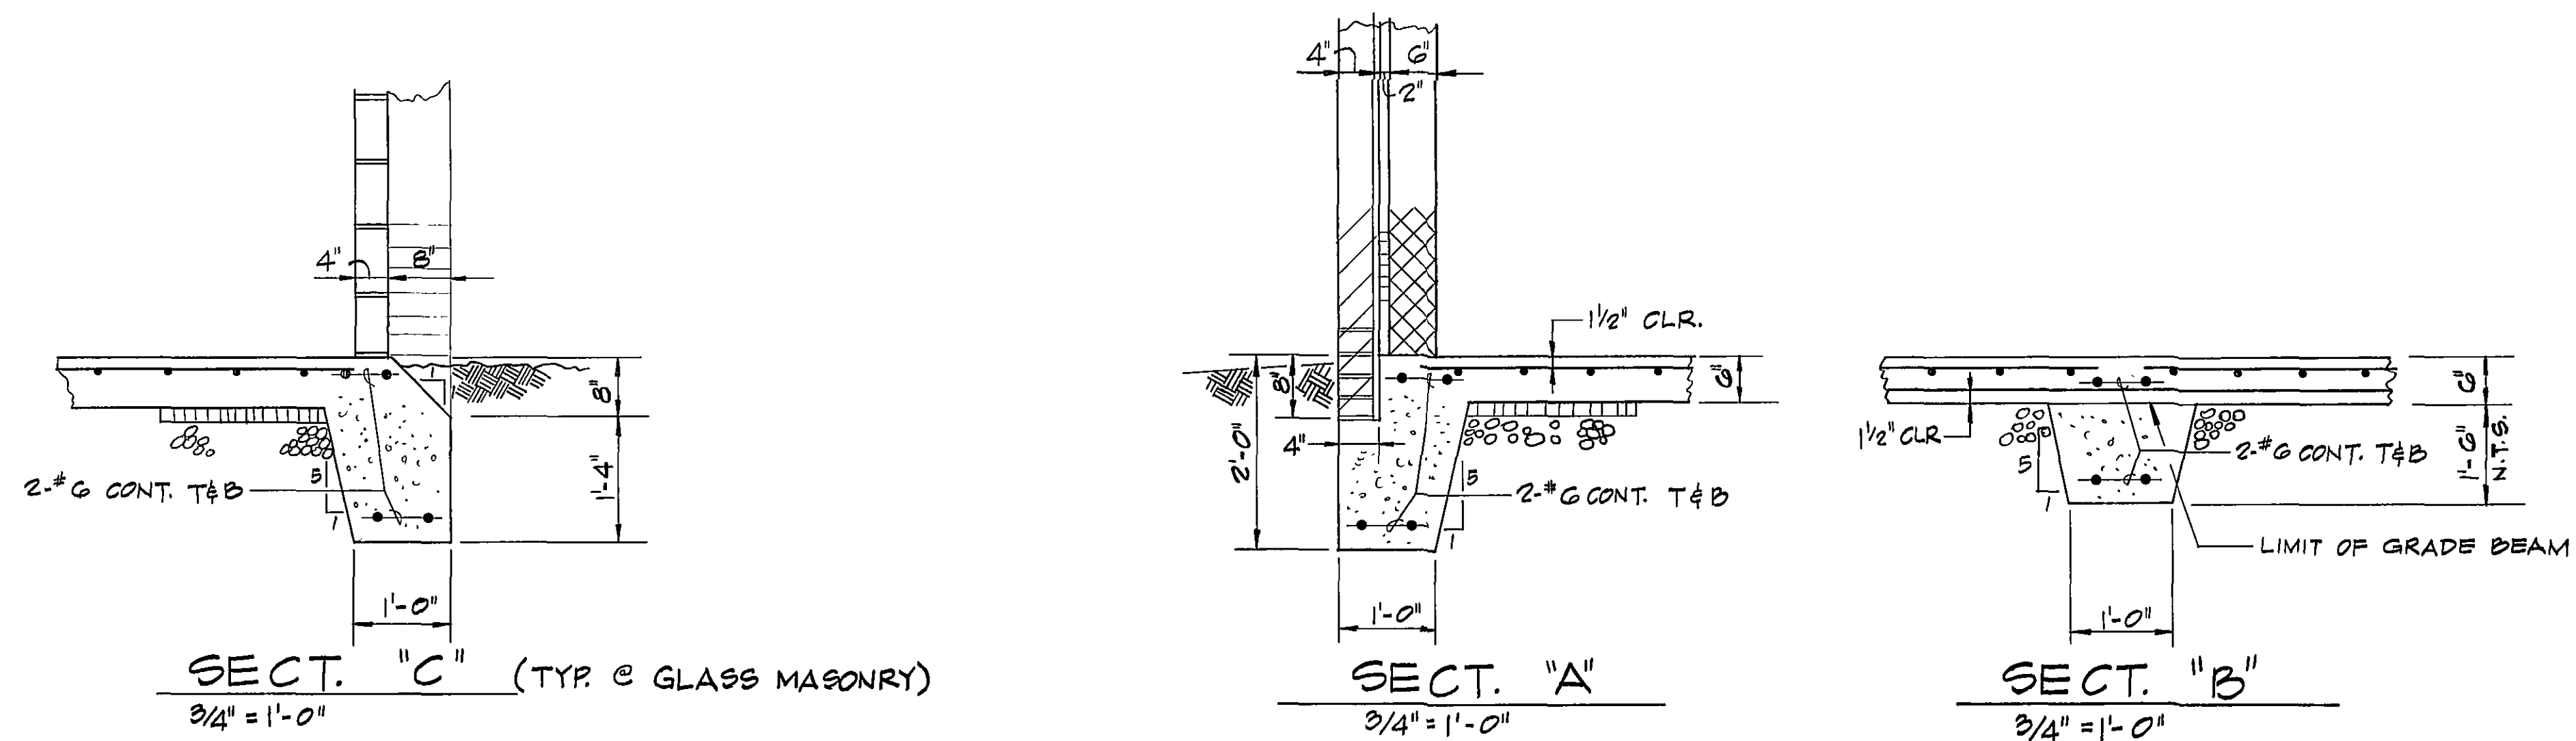


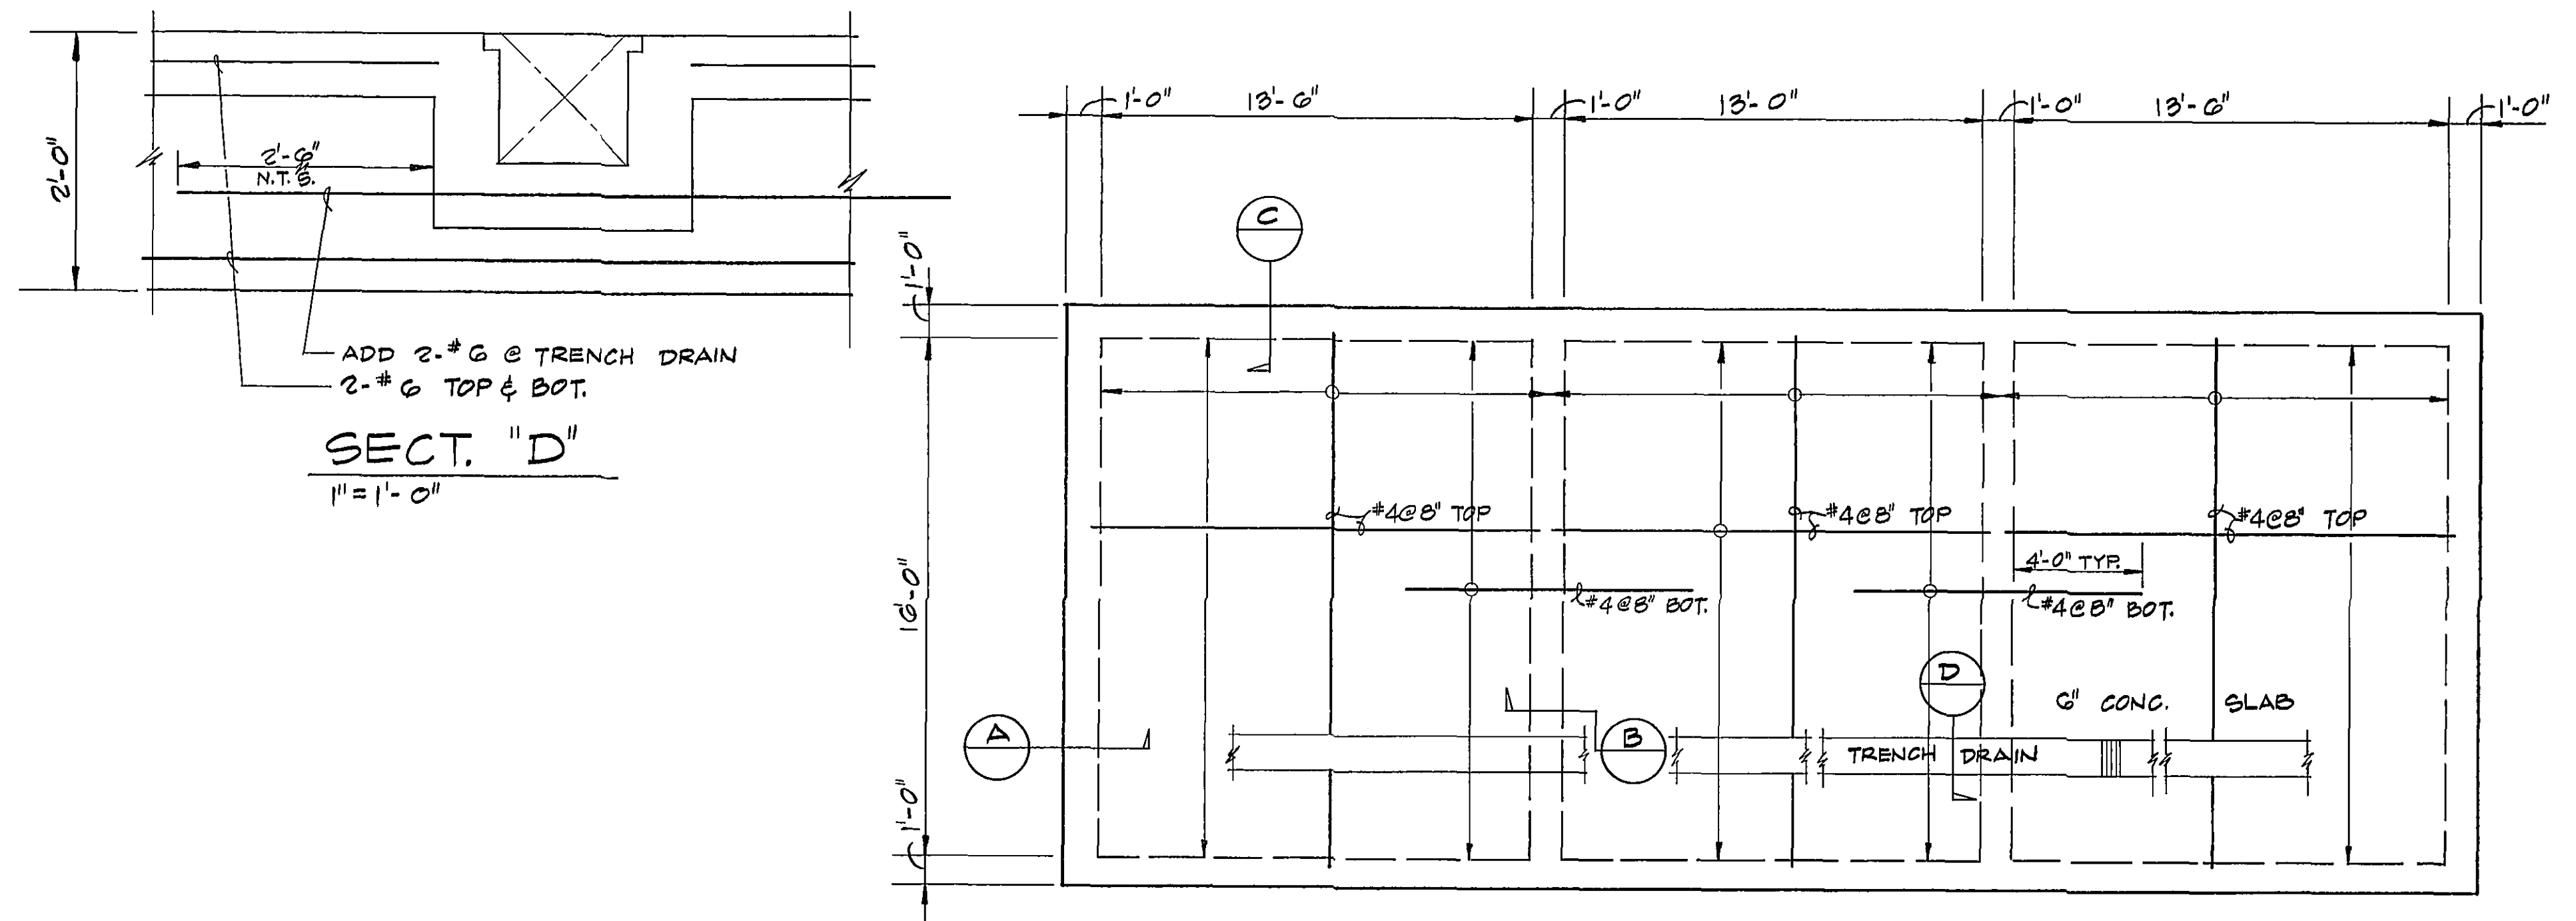

NOTE: GRADE BEAMS WERE CONSTRUCTED

DESIGNED	12/10/87	RECORD DWGS	BY	APP.
DRAWN				
CHECKED				
APPROVED				
SUBMITTED				
FRANKLIN ROAD BOOSTER PUMPING STATION ALTERNATE FOUNDATION PLAN				
SCALE NOTED			COMM NO	565
DATE DEC 85			SHEET	9

RECORD DRAWING

Mattern & Craig
CONSULTING ENGINEERS

