




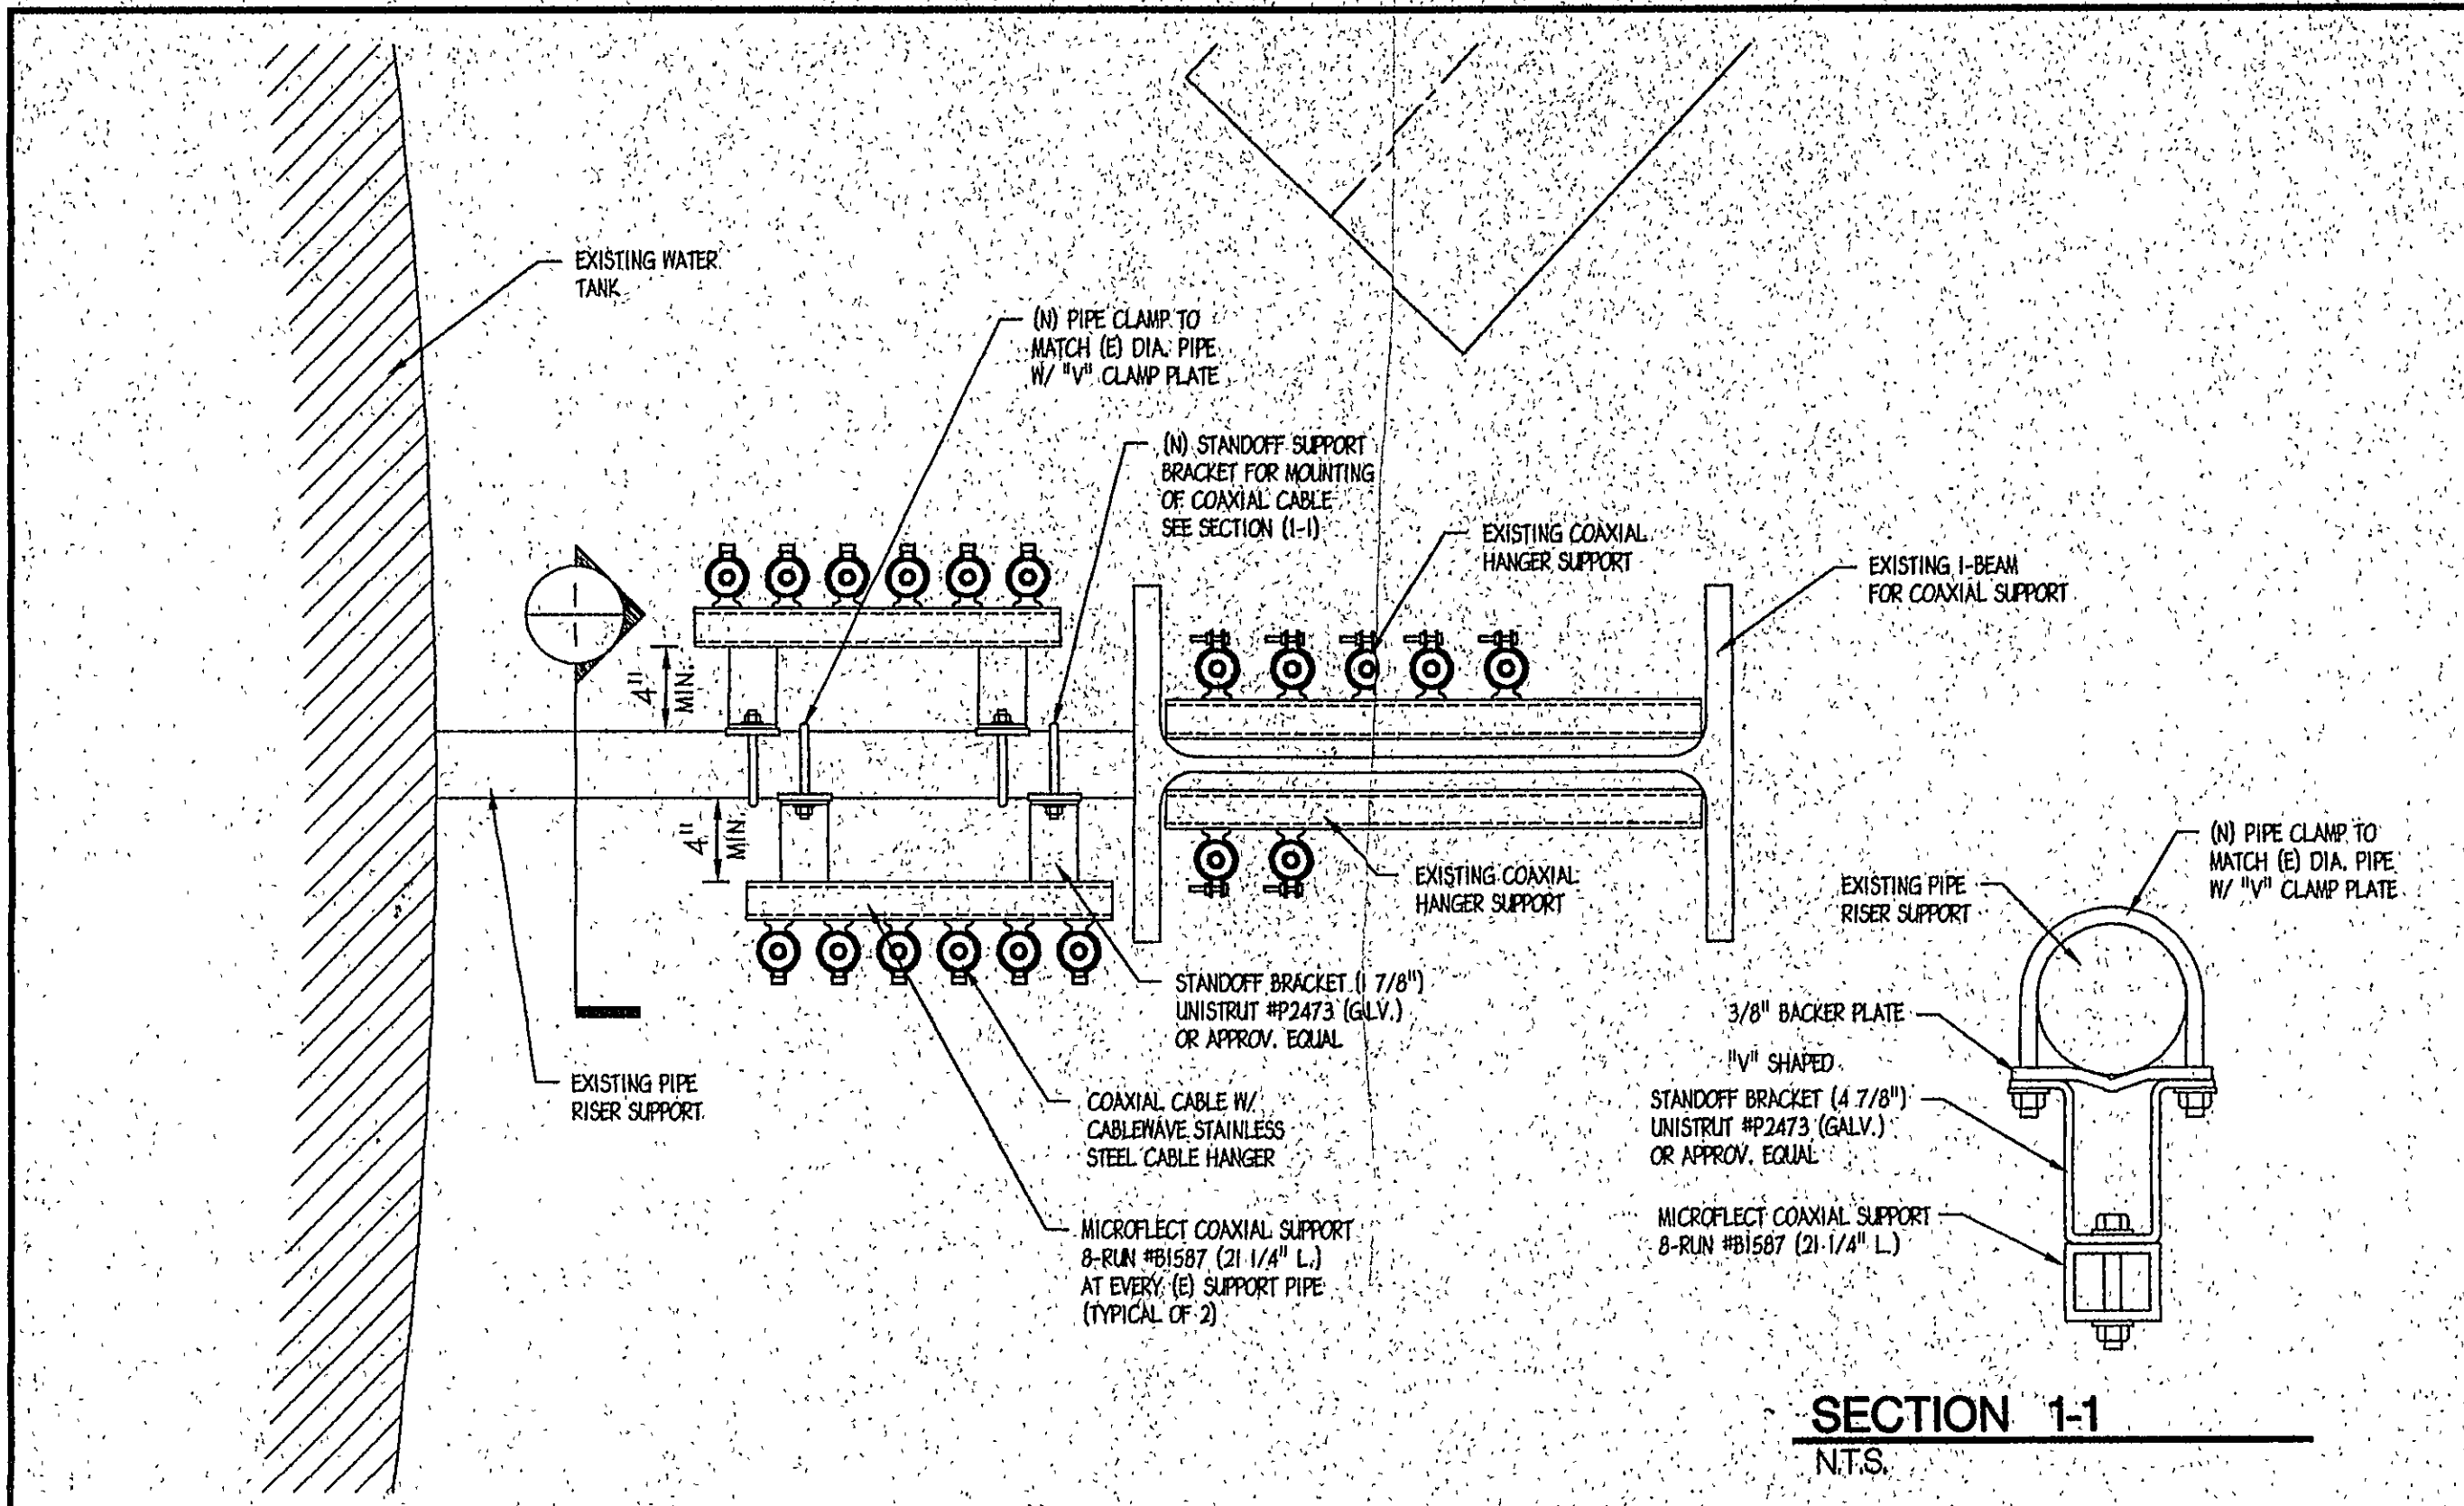


2 VERTICAL COAXIAL CABLE SUPPORT
S-2 N.T.S.

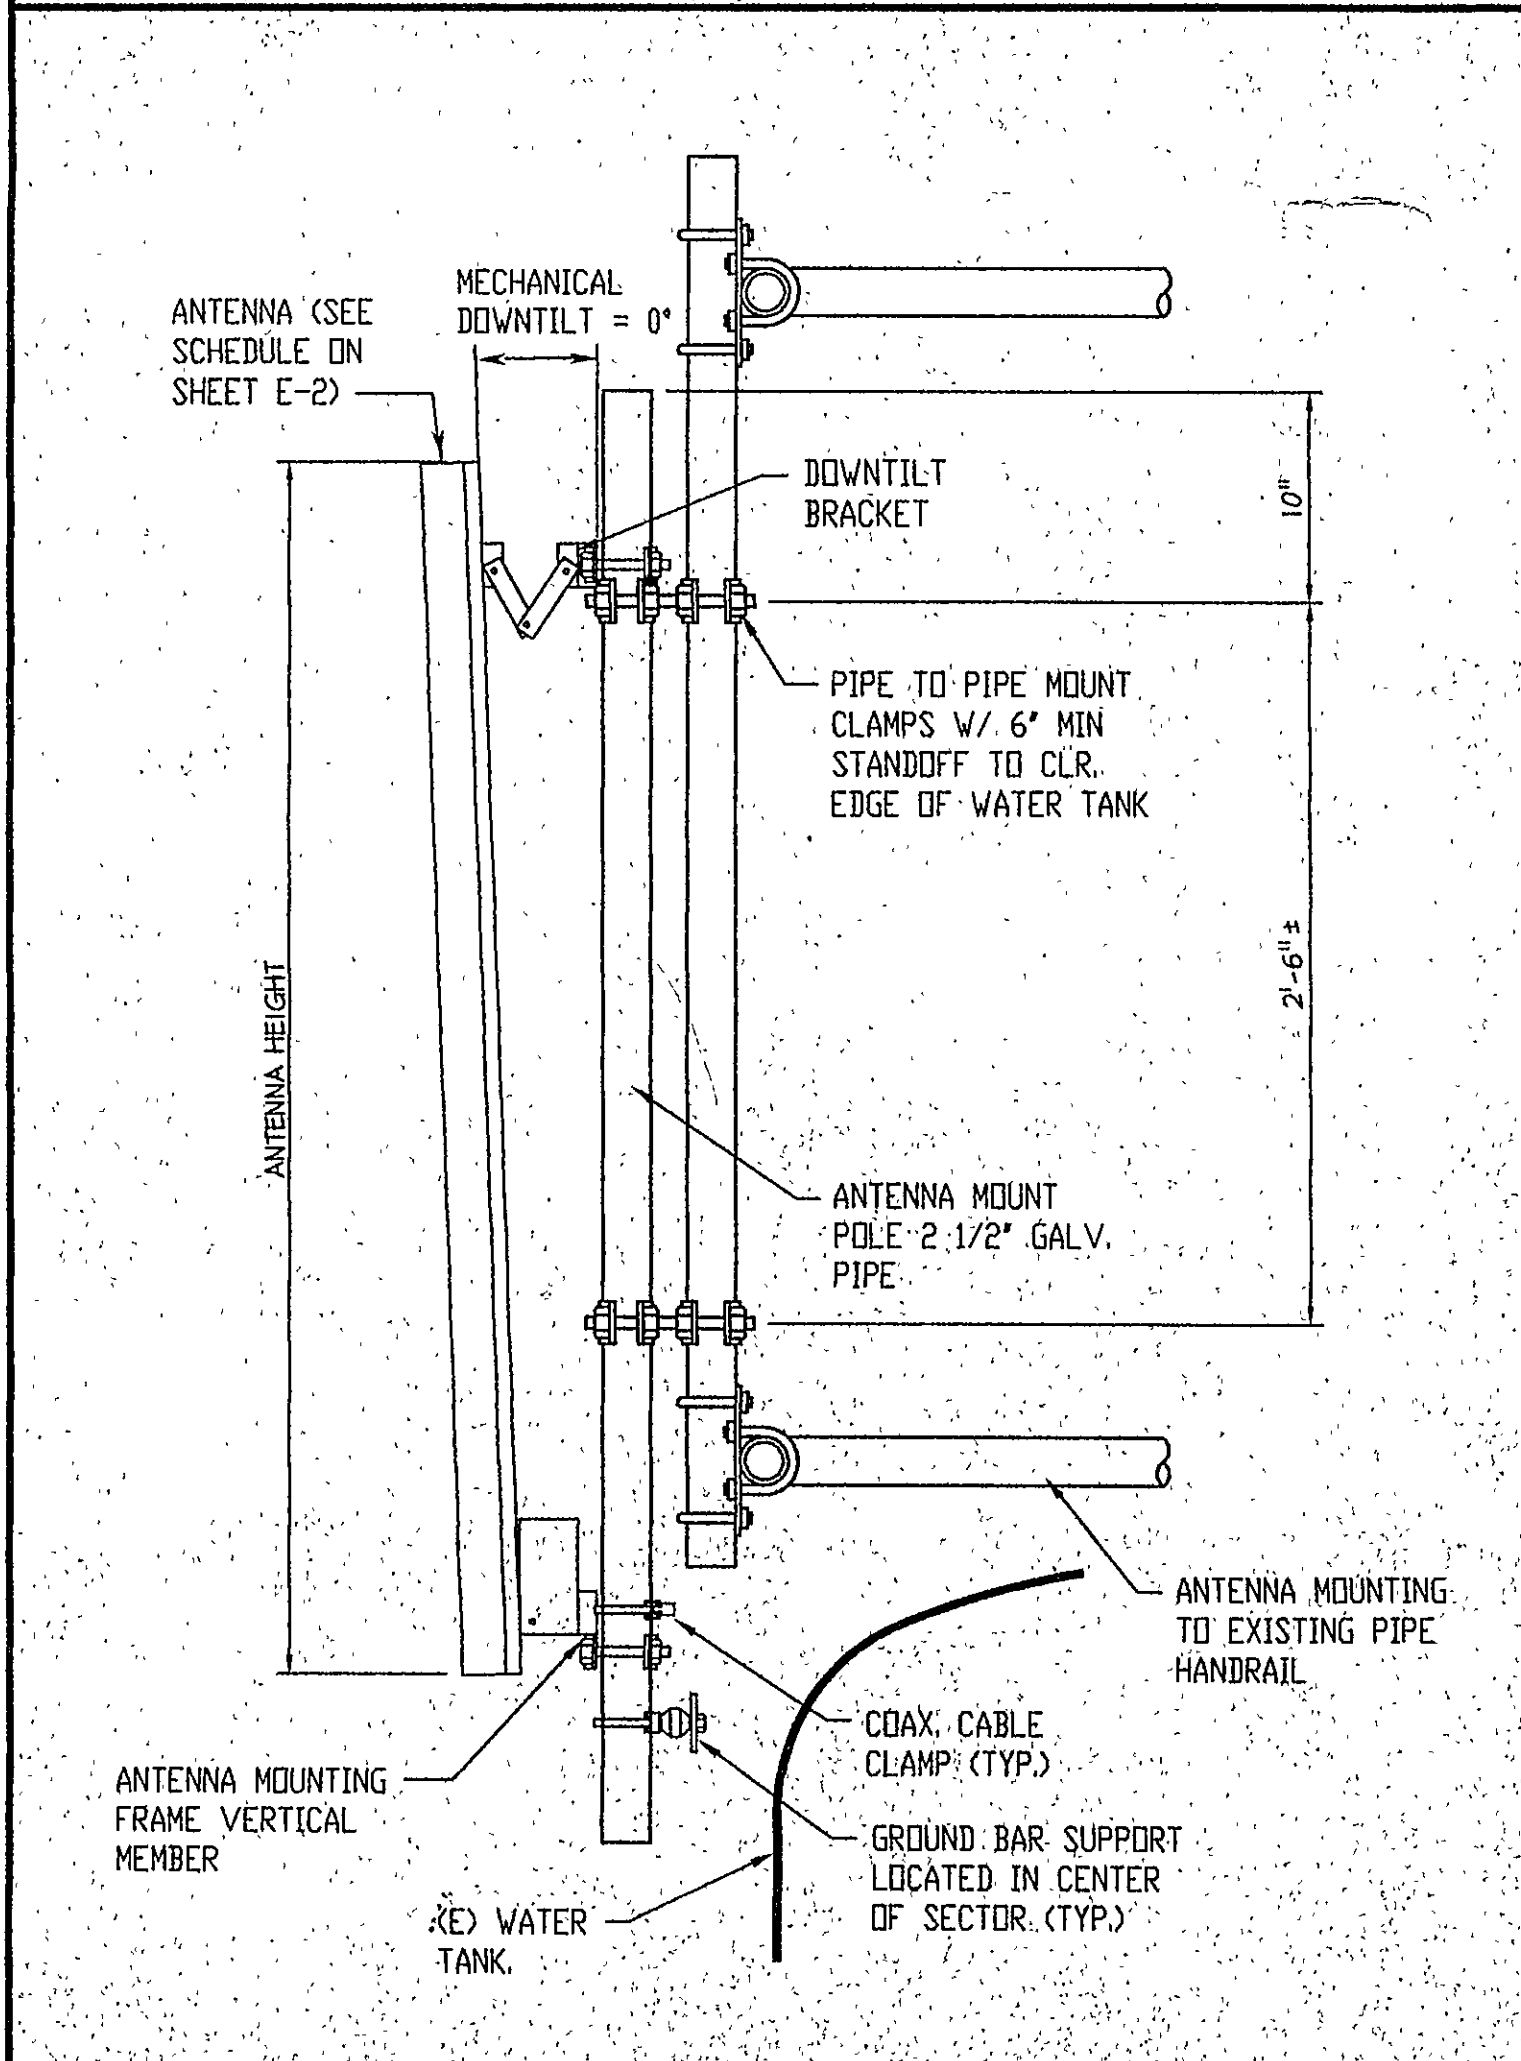

3 ANTENNA MOUNTING DETAIL
S-2 N.T.S.

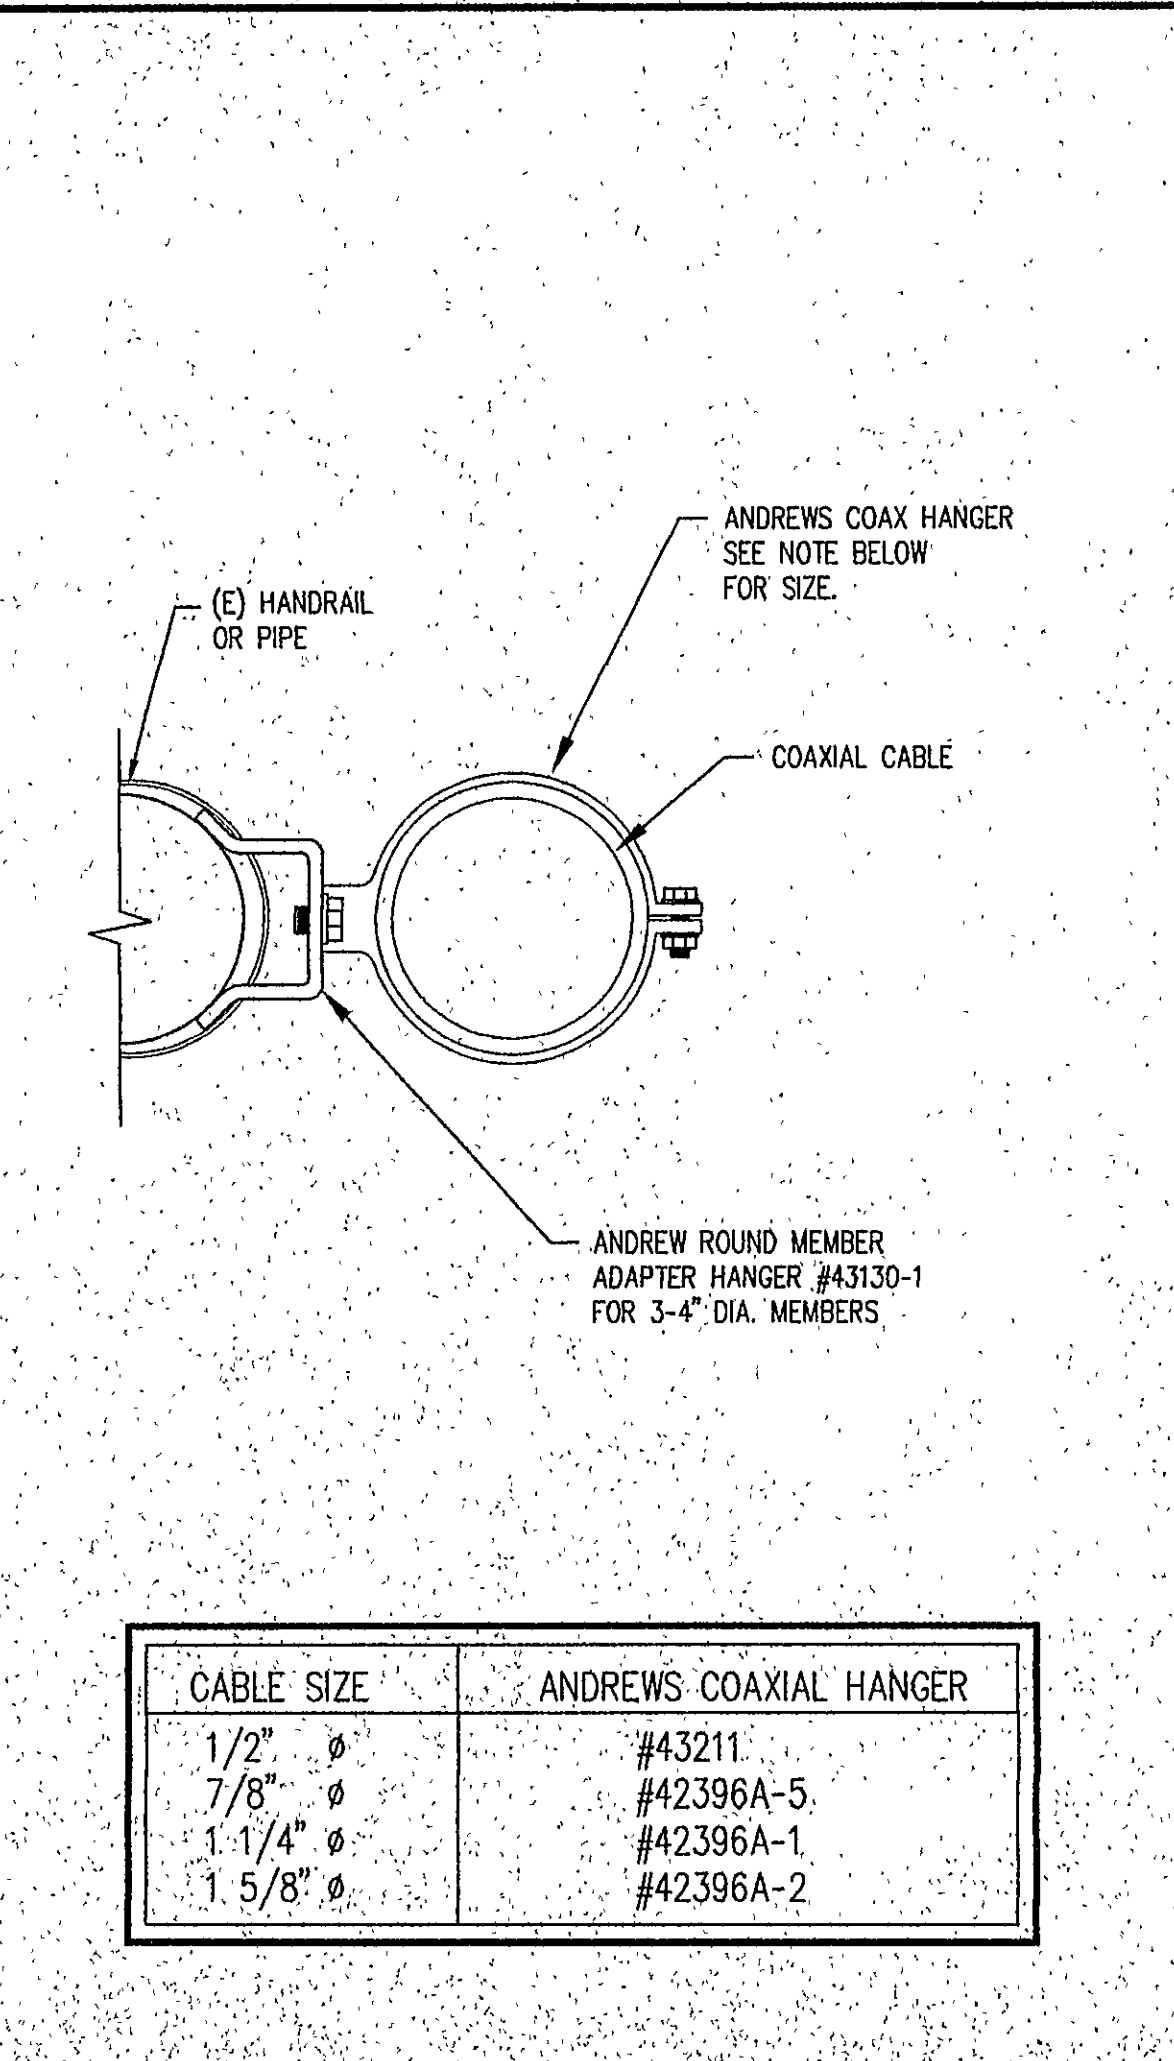

4 SINGLE COAXIAL CABLE SUPPORT
S-2 N.T.S.

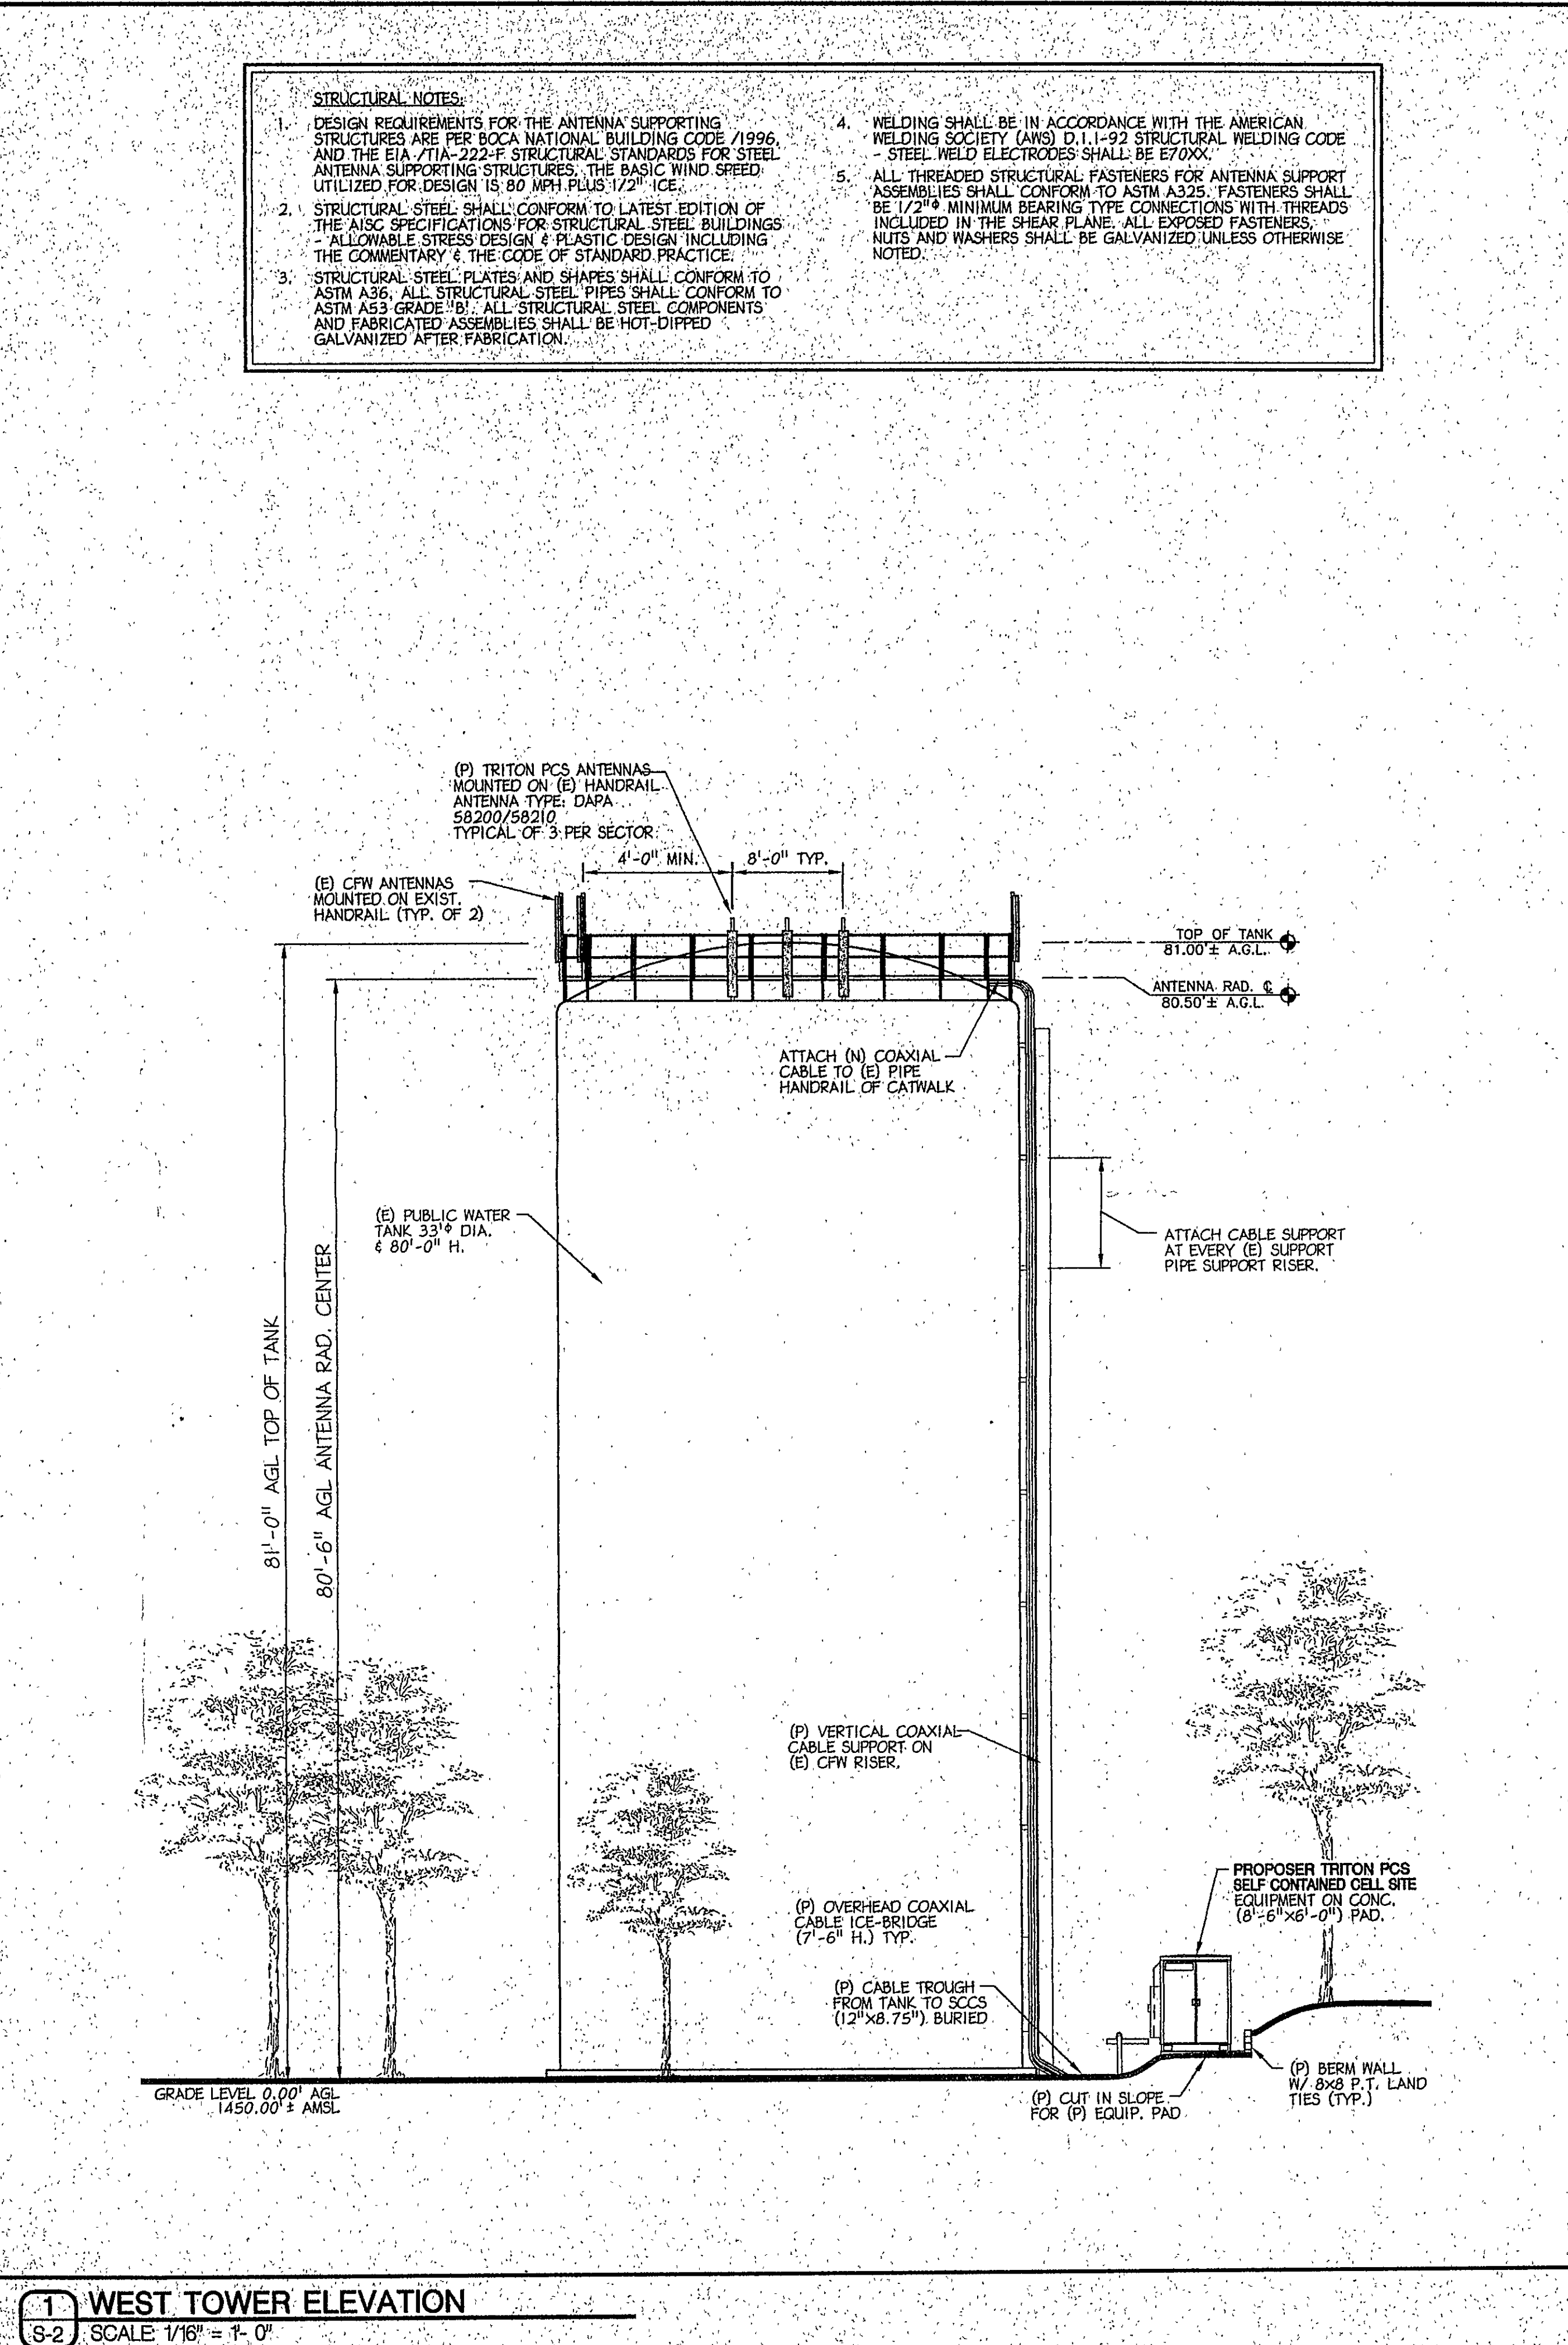

1 WEST TOWER ELEVATION
S-2 SCALE 1/16" = 1'-0"

Betzwood Associates PC
Architects & Engineers
Robin J. Kohn AIA Regis W. Kubik PE
301 Gay Street
Phoenixville PA 19460
Tel (610) 917-8881 Fax 917-8886

SEAL BLOCK
I CERTIFY THAT THIS DOCUMENT WAS PREPARED OR APPROVED BY ME OR A PERSON UNDER MY CLOSE PERSONAL SUPERVISION AND TO THE BEST OF MY KNOWLEDGE AND BELIEF IT COMPLIES WITH ALL APPLICABLE REQUIREMENTS OF THE VIRGINIA BOARD OF ARCHITECTS.
ROBIN J. KOHN
No. 010568
ARCHITECT
ROBIN J. KOHN AIA - VA #010568 12-31-99

TRITON PCS Incorporated
8211 Aboretum Parkway, Suite 200
Richmond, Virginia 23238-3489
Tel. (804) 323-9500 FAX (804) 323-1560

APPROVALS

Triton PCS _____

LANDLORD _____

LEASING _____

R.F. _____


ZONING _____

CONSTRUCTION _____

PROJECT NO. TR-005 **DRAWN BY** EMH **CHECK BY** RJK

SUBMITTALS

NO.	DATE	ISSUE
0	06-05-97	ITT DATE
1	06-25-97	ISSUED FOR REVIEW (ZONING)
2	07-17-98	ISSUED FOR REVIEW (CONST.)
3	07-24-98	ISSUED FOR CONSTRUCTION
4	08-04-98	REISSUED FOR CONSTRUCTION
5	09-18-98	REVISED ANTENNA HEIGHT
6	10-08-98	FINAL CONSTRUCTION REVISIONS
7	10-23-98	OWNER REVISIONS
8	12-10-98	REVISED CHANGES
9	3-16-99	AS BUILT DESCRIPTION

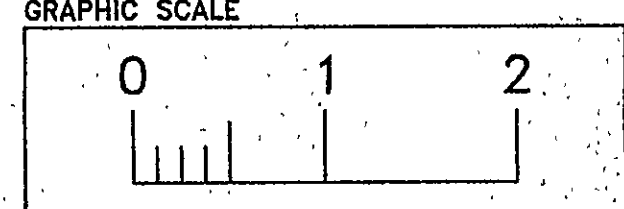

PROJECT
HIGHWAY 220 RO-1-429-A
ROANOKE CITY PUBLIC WORKS
1423 SUMMIT LANE
ROANOKE, VA 24011
AS - BUILT COPY

SHEET TITLE
WATER TANK ELEVATION ANTENNA SUPPORT STRUCTURE AND DETAILS

SHEET NUMBER
S-2