




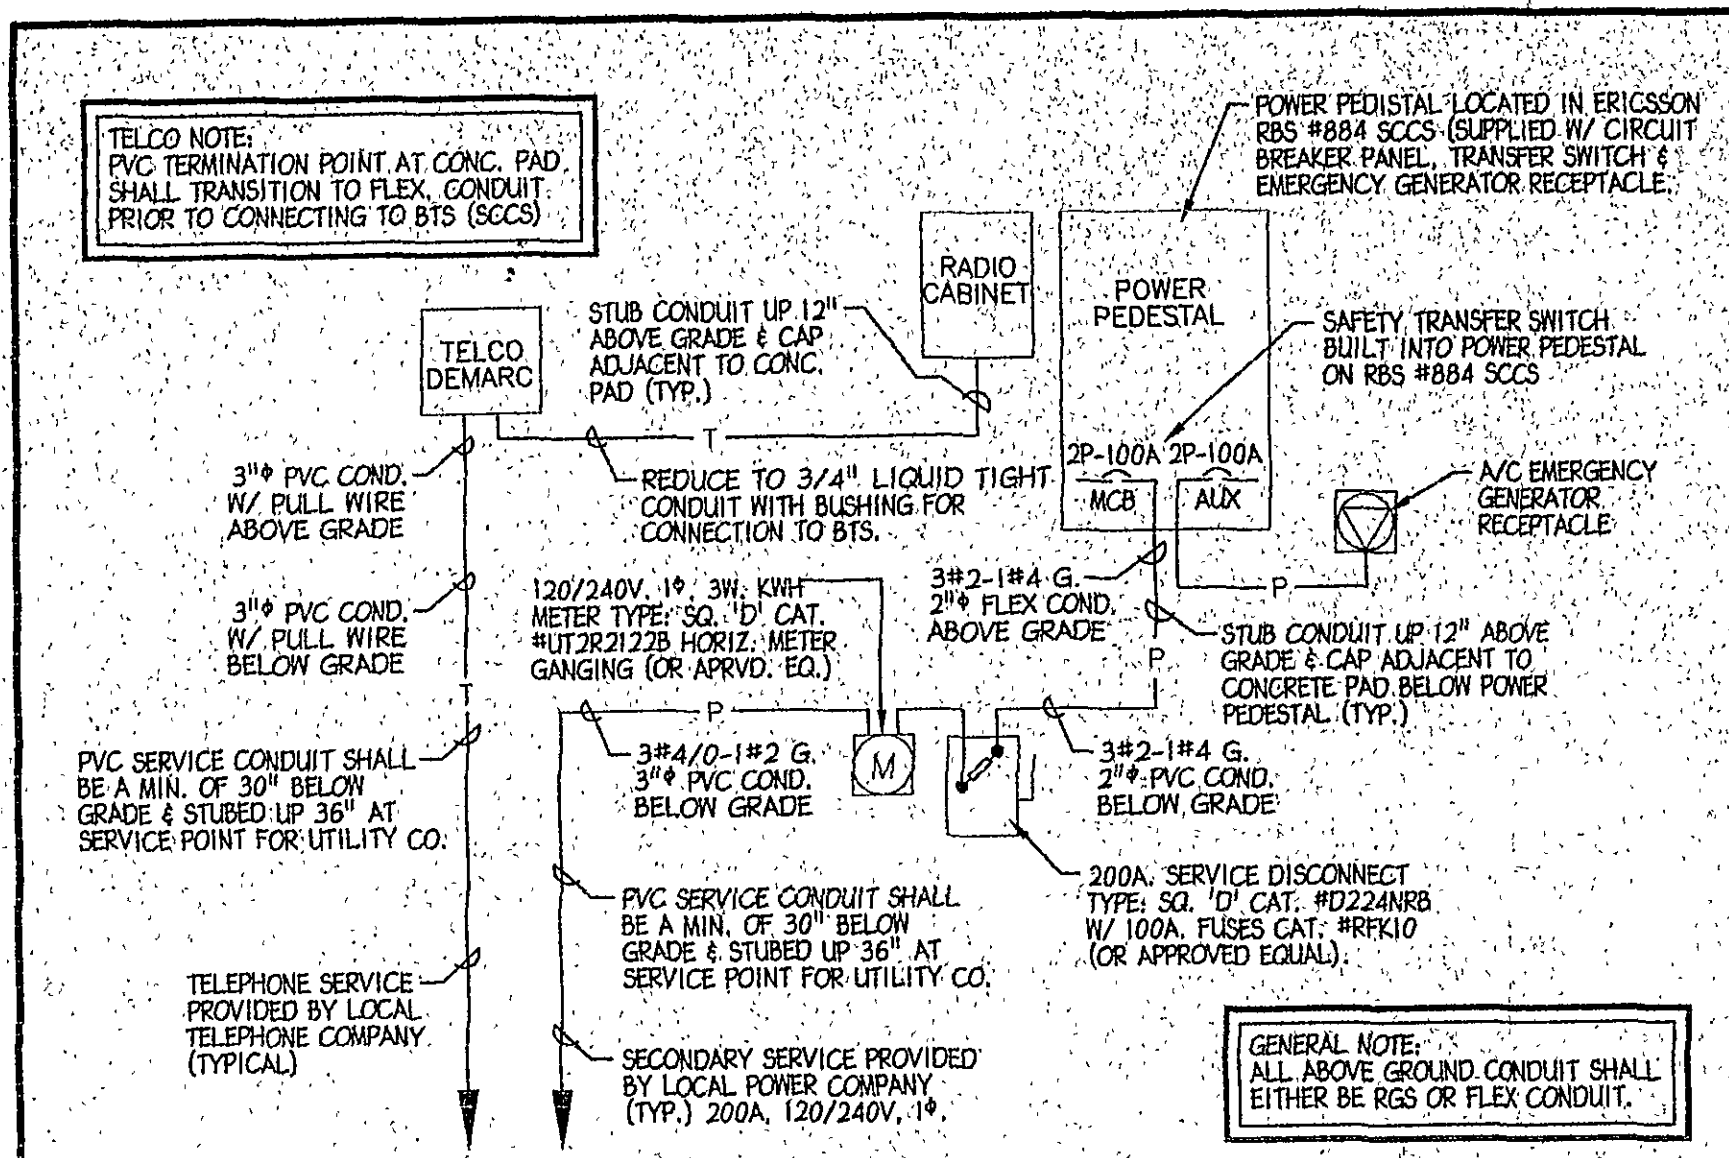


2 SINGLE LINE DIAGRAM
E-1 N.T.S.

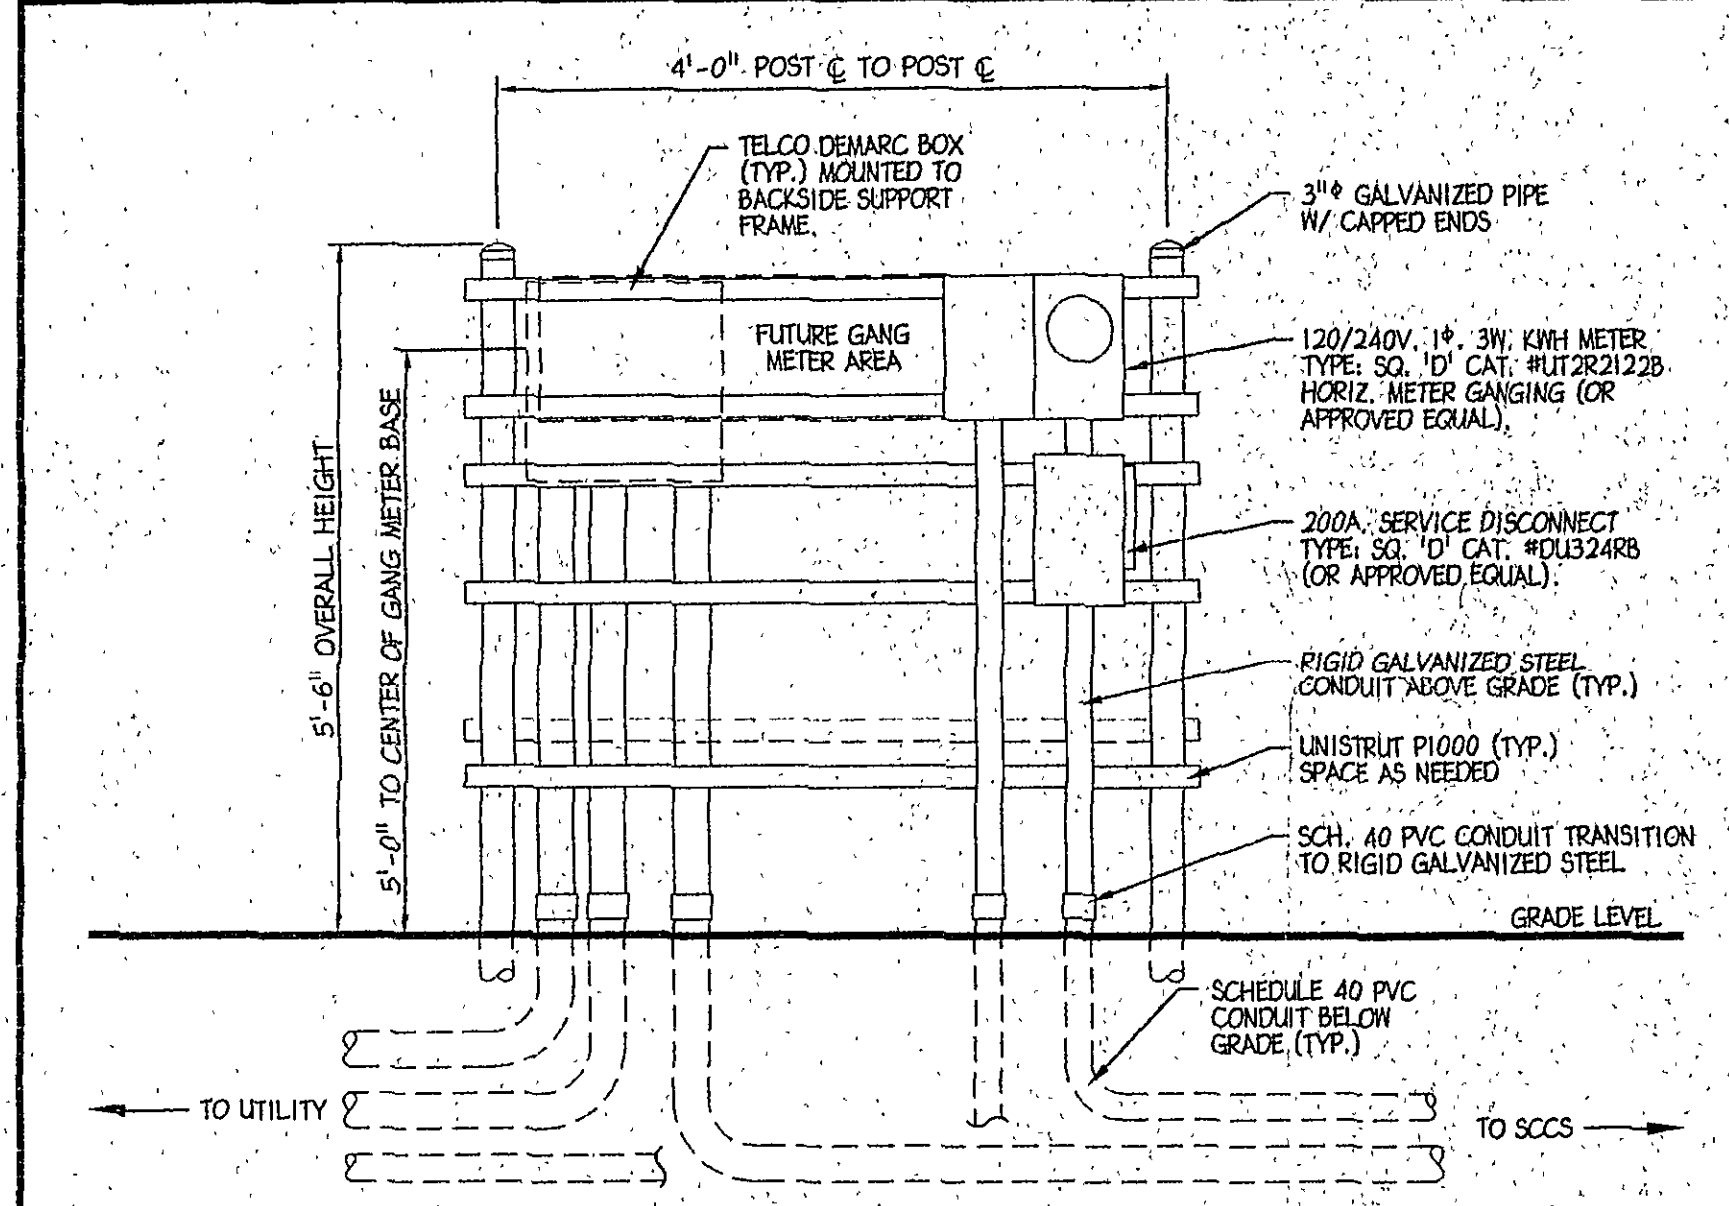


3 ELECTRICAL & TELCO SERVICE ELEVATION
E-1 N.T.S.

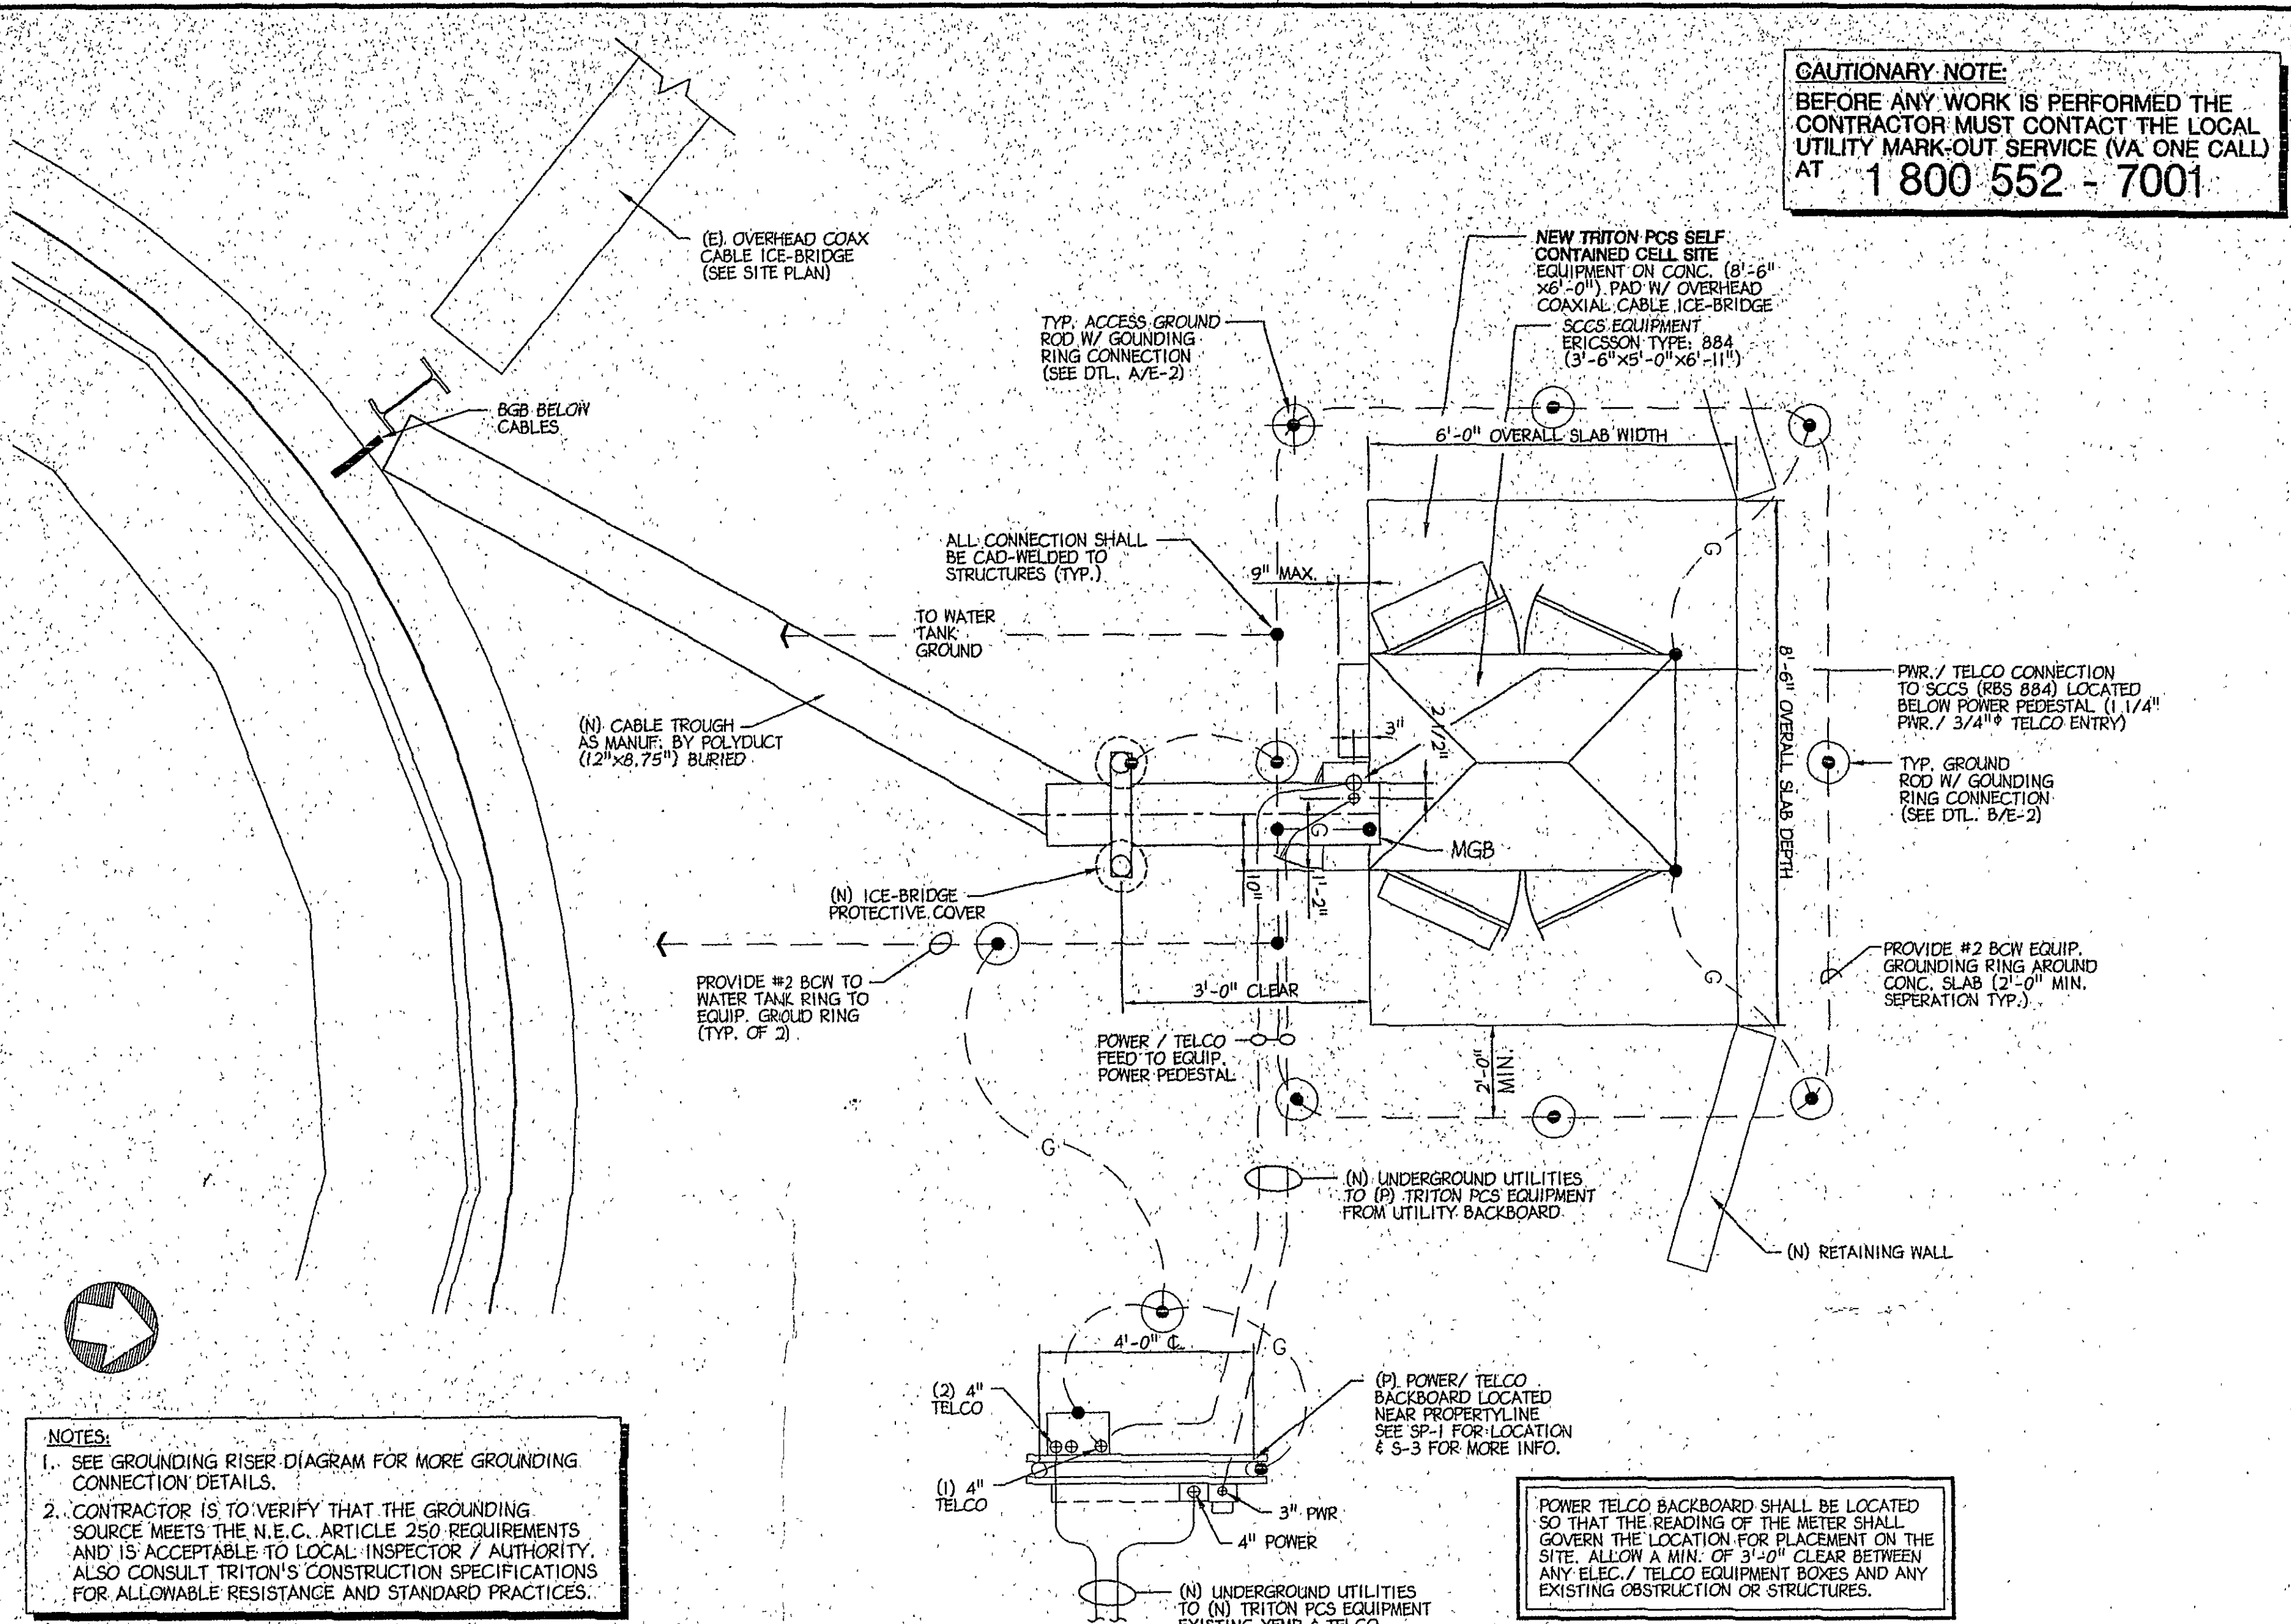

1 ELECTRICAL PLAN
E-1 1/4" = 1'-0"

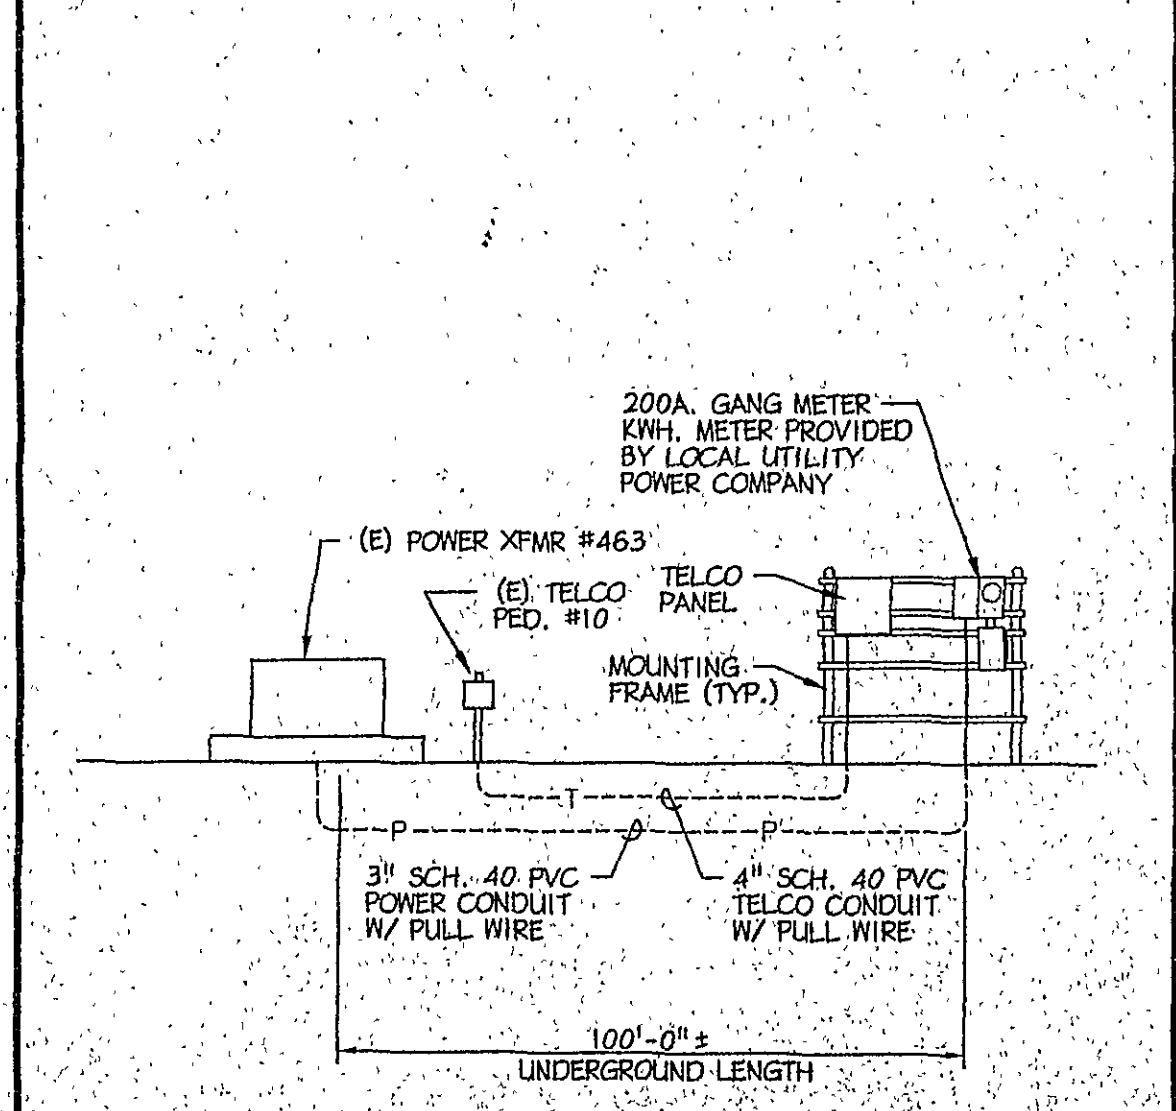

4 ELECTRICAL / TELEPHONE RISER
E-1 N.T.S.

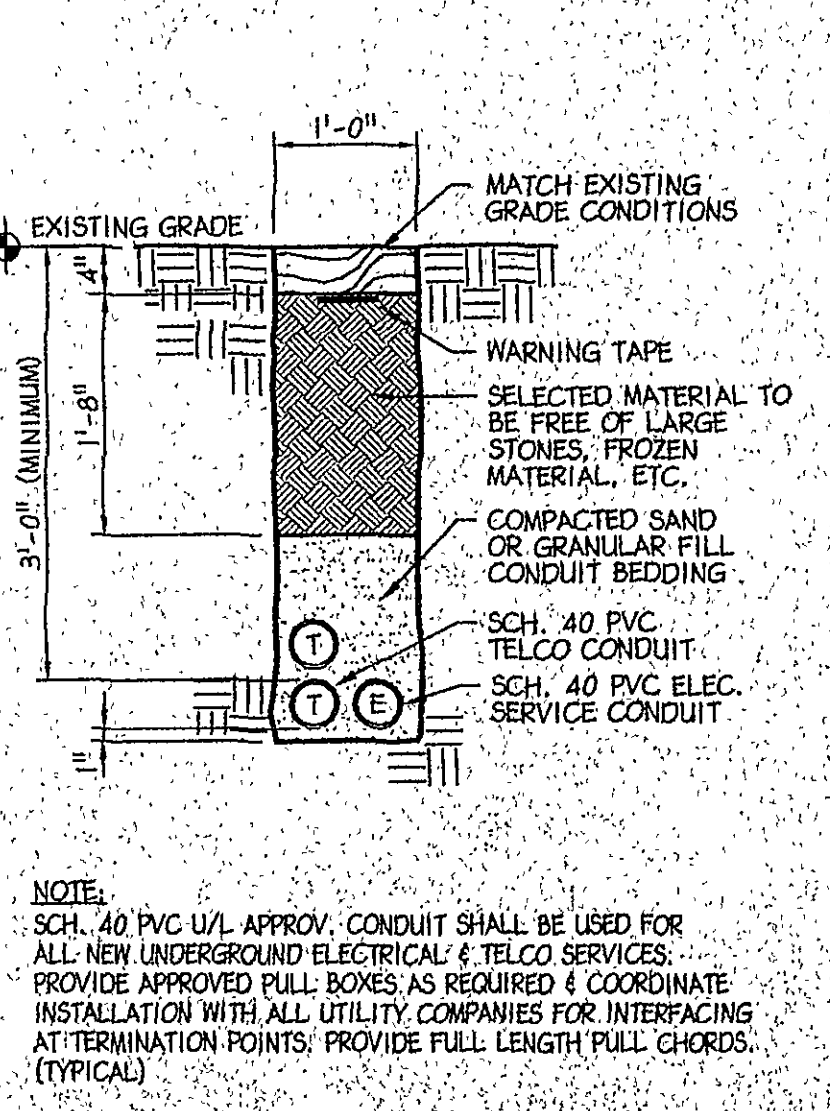

5 DUCT BANK DETAIL
E-1 N.T.S.

ELECTRICAL NOTES

1. ALL ELECTRICAL WORK SHALL CONFORM TO THE NATIONAL ELECTRICAL CODE (LATEST EDITION) AND ANY LOCAL CODES.
2. GROUNDING SHALL COMPLY WITH ARTICLE 250 OF THE NATIONAL ELECTRICAL CODE.
3. ALL ELECTRICAL ITEMS SHALL BE LISTED, APPROVED OR LISTED ALL WIRES SHALL BE COPPER THIN/THIN. GROUND WIRES SHALL BE BARE, TIN-COATED OR GREEN INSULATED.
4. CONDUCTORS SHALL BE INSTALLED IN GALVANIZED RIGID STEEL CONDUIT, SCHEDULE 40 PVC, OR FLEXIBLE LIQUIDTIGHT CONDUIT AS INDICATED.
5. OBTAIN ALL PERMITS, PAY PERMIT FEES AND SCHEDULE INSPECTIONS.
6. OBTAIN LOCAL POWER AND TELEPHONE COMPANY APPROVAL AND COORDINATE WITH UTILITY COMPANIES SERVICE ENTRANCE REQUIREMENTS.
7. PROVIDE ALL LABOR AND MATERIAL DESCRIBED ON THIS DRAWING AND ALL ITEMS IDENTICAL TO COMPLETE AND PRESENTING THIS PROJECT AS FULLY OPERATIONAL.
8. REFER TO STRUCTURAL DRAWINGS FOR PHYSICAL LOCATIONS OF SURFACE-MOUNTED GROUND BARS, GROUNDING CONNECTIONS SHALL BE EXOTHERMIC TYPE ("CAWELD") TO ANTENNA MASTS, FENCE POSTS, TOWER STEEL, AND GROUNDING RING. REMAINING GROUNDING CONNECTIONS SHALL BE COMPRESSION FITTINGS ALL GROUND BAR CONNECTIONS SHALL BE MADE WITH TWO-HOLE LUGS.
9. GROUND COAXIAL CABLE SHIELDS AT BOTH ENDS WITH MANUFACTURER'S GROUNDING KITS. GROUNDING SHALL NOT EXCEED 100.0 FT. BETWEEN GROUND KITS.
10. ROUTE GROUNDING CONDUCTORS ALONG THE SHORTEST AND STRAIGHTEST PATH POSSIBLE. BEND GROUNDING LEADS WITH MINIMUM 12 IN. RADIUS.
11. PROVIDE GROUND RODS AND GROUND RING AS SHOWN ON SITE PLAN AND GROUNDING RISER DIAGRAM. TEST AND VERIFY THAT THE IMPEDANCE DOES NOT EXCEED 5 OHMS TO GROUND BY MEANS OF BUDLE-HEGGER TESTER. GROUNDING AND OTHER OPERATIONAL TESTING SHALL BE WITNESSED BY THE OWNER'S REPRESENTATIVE.
12. PROVIDE 4 IN. SCH. 40 PVC BELOW OR RIGID GALVANIZED STEEL CONDUIT ABOVE GRADE WITH PULL WIRE BETWEEN TELEPHONE COMPANY DEMARCATION POINT AND THE TELCO PANEL CONDUCTOR TYPE: CATEGORY 5, 6 PAIR SHIELDED CABLE.
13. PROVIDE 3 IN. SCH. 40 PVC BELOW OR RIGID GALVANIZED STEEL CONDUIT ABOVE GRADE WITH PULL WIRE BETWEEN UTILITY SERVICE SUPPLY AND NEW ELECTRICAL DISTRIBUTION PANEL.
14. INSTALL #2 COPPER STRANDED WIRE WITH GREEN INSULATION FOR ABOVE GRADE GROUNDING AND #2 BARE SOLID TINNED COPPER WIRE FOR BELOW GRADE GROUNDING, UNLESS OTHERWISE SPECIFIED.
15. GROUNDING CONDUCTORS FROM ABOVE THE GROUND TO THE BELOW-GRADE GROUNDING RING SHALL BE INSULATED FROM EARTH CONTACT BY PASSING THROUGH A PVC PIPE. PVC PIPE SHALL EXTEND AT LEAST 12 IN. ABOVE AND 12 IN. BELOW THE GRADE LEVEL.
16. BONDING OF GROUND CONDUCTORS (NEUTRAL) AND GROUNDING CONDUCTORS SHALL BE AT THE SERVICE DISCONNECT DEVICE, BONDING JUMPER SHALL BE INSTALLED PER NEC ARTICLE 250-26.
17. ALL ABOVE GROUND CABLEWELDING SHALL BE COATED WITH A ZINC RICH PAINT.
18. IF CODES REQUIRE VERTICAL RISER TO BE ISOLATED IN THE CONDUIT, PVC CONDUIT IS PREFERRED. IF METALLIC CONDUIT SHOULD BE REQUIRED, GROUNDING BUSHINGS SHALL BE INSTALLED ON EACH END OF THE CONDUIT AND BONDED TO GROUND BARS USING #2 AWG THIN STRANDED COPPER CONDUCTORS WITH GREEN INSULATOR.
19. WHEN BONDING TO MAIN COLD WATER LINE, BRASS GROUNDING CLAMP MUST BE INSTALLED WITHIN A MAXIMUM DISTANCE OF 5 FEET ALONG THE LENGTH OF PIPE FROM POINT OF ENTRY INTO BUILDING WITH WATER PIPE FOR A MINIMUM OF 4 LINEAR INCHES.
20. ALL LATEST PUBLISHED STANDARDS OF THE FOLLOWING ASSOCIATIONS/ORGANIZATIONS SHALL BE FOLLOWED AND APPLIED WHERE APPLICABLE, AS MINIMUM REQUIREMENTS:
(ANSI) AMERICAN NATIONAL STANDARDS INSTITUTE
(ASTM) AMERICAN SOCIETY FOR TESTING MATERIALS
(ICEA) INSULATED CABLE ENGINEERS ASSOCIATION
(NEMA) NATIONAL ELECTRICAL MANUFACTURERS ASSOCIATION
(NEC) NATIONAL ELECTRICAL SAFETY CODE
(UL) UNDERWRITER'S LABORATORIES
21. ALL CONDUIT STUB UP LOCATIONS MUST COORDINATE WITH THE EQUIPMENT LAYOUT.
22. PROVIDE EQUIPMENT WITH HIGHER FAULT CURRENT RATINGS AS NEEDED TO MATCH AVAILABLE FAULT CURRENT.
23. AFTER TESTING BY CONTRACTOR, OWNER OR ENGINEER, CORRECT ANY DEFICIENCIES AND REPLACE MATERIALS AND EQUIPMENT SHOWN TO BE DEFECTIVE OR UNABLE TO PERFORM AT DESIGN OR RATED CAPACITY.
24. CONTRACTOR SHALL CONDUCT A CONTINUITY AND INSULATION TEST ON CONDUCTORS BETWEEN SERVICE DISCONNECT SWITCH AND POWER CABINET.

A-1 NOTES AND LEGEND
E-1 N.T.S.

LEGEND

	SAFETY DISCONNECT SWITCH UNLESS NOTED OTHERWISE		AG GENERATOR CONNECTOR
	PANEL BOARD		COPPER GROUND BAR (1/4"x4"x12") UNLESS NOTED OTHERWISE
	KILOWATT HOUR METER		EXOTHERMIC WELD CONNECTION
	TRANSFORMER		COMPRESSION FITTING
	CIRCUIT BREAKER		COAXIAL CABLE SHIELD GROUND KIT CONNECTION
	MANUAL TRANSFER SWITCH		ACCESS GROUND ROD
	LIGHT FIXTURE		GROUND ROD
	LIGHT SWITCH		POWER CONDUIT
	GFI DUPLEX RECEPTACLE		TELCO CONDUIT
			GROUND CONDUIT

AMPERE	SN	SOLID NEUTRAL	TGB	TOP GROUND BAR
CONDUIT	SW	SWITCH	BGB	BOTTOM GROUND BAR
GROUND	V	VOLT	MGB	MASTER GROUND BAR
KWH	W	WIRE	(E)	EXISTING
POLE	Ø	PHASE	(N)	NEW

Betzwood Associates PC
ARCHITECTS & ENGINEERS
301 G. A. Street
Phoenixville, PA 19460
Tel. (610) 917-8831 Fax 917-8836

SEAL BLOCK
I CERTIFY THAT THIS SET OF DRAWINGS WAS PREPARED OR APPROVED BY ME OR BY AN ARCHITECT OR ENGINEER UNDER MY CLOSE PERSONAL SUPERVISION AND TO THE BEST OF MY KNOWLEDGE AND BELIEF THEY COMPLY WITH ALL THE REQUIREMENTS OF THE PROFESSIONAL SEAL ACT OF VIRGINIA.
ROBIN J. KOHN
No. 010566
ARCHITECT
ROBIN J. KOHN AIA - VA #010566 12.31.99

TRITON PCS Incorporated
9211 Aboretum Parkway, Suite 200
Richmond, Virginia 23236-3469
Tel. (804) 323-9500 FAX (804) 323-1580

APPROVALS
Triton PCS _____
LANDLORD _____
LEASING _____
R.F. _____
ZONING _____
CONSTRUCTION _____

PROJECT NO. TR-005
DRAWN BY EMH
CHECK BY RJK

SUBMITTALS		
NO.	DATE	ISSUE
0	06-05-97	TV DATE
1	06-25-97	ISSUED FOR REVIEW (ZONING)
2	07-17-98	ISSUED FOR REVIEW (CONST.)
3	07-24-98	ISSUED FOR CONSTRUCTION
4	09-04-98	REISSUED FOR CONSTRUCTION
5	09-18-99	REVISED ANTENNA HEIGHT
6	10-08-99	FINAL CONSTRUCTION REVISIONS
7	10-23-98	OWNER REVISIONS
8	12-10-98	REVISED CHANGES
9	3-16-99	AS BUILT DESCRIPTION

GRAPHIC SCALE
0 1 2

PROJECT
HIGHWAY 220 RO-1429-A
ROANOKE CITY PUBLIC WORKS
1423 SUMMIT LANE
ROANOKE, VA 24011

AS - BUILT COPY

SHEET TITLE
**ELECTRICAL PLAN
SERVICE RISER PLAN,
ELECTRICAL DIAGRAM,
NOTES & DETAILS**

SHEET NUMBER

E-1