


PROJECT LOCATION MAP

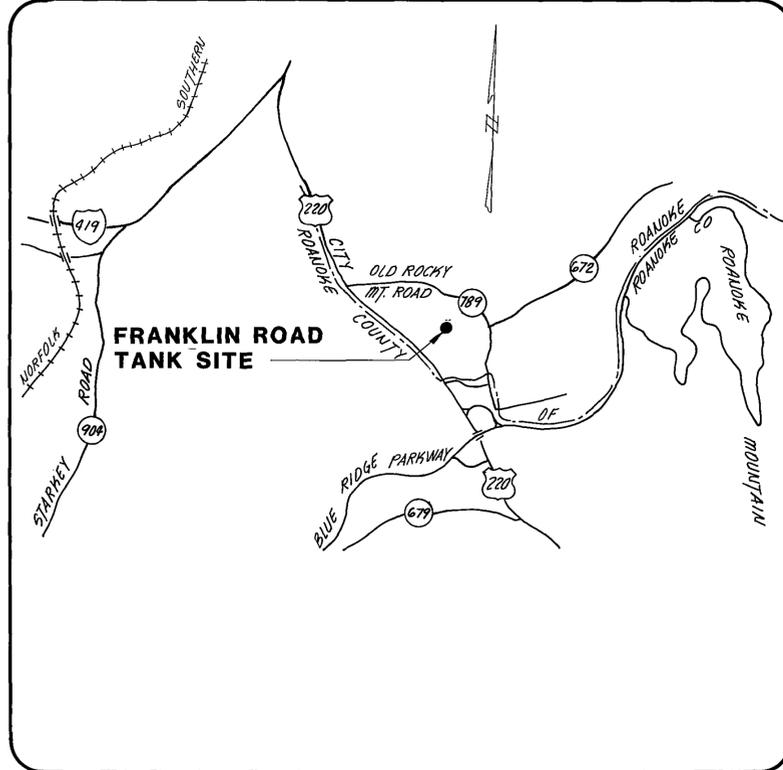

OFFICE OF CITY ENGINEER
 ROOM 350
 MUNICIPAL BUILDING
 215 CHURCH AVENUE, S.W.
 ROANOKE, VIRGINIA 24011

INDEX OF SHEETS

- 1 TITLE SHEET
- 2 ABBREVIATION, LEGEND, VICINITY MAP AND GENERAL NOTES
- 3 PLAN AND
- 4 PROFILE AND DETAILS
- 5 DETAILS
- 6 STRUCTURAL DETAILS

CONSULTING ENGINEERS

**MATTERN AND CRAIG
 CONSULTING ENGINEERS
 ROANOKE, VIRGINIA**

COMMISSION NUMBER: **564**



PROJECT NAME

FRANKLIN ROAD WATER TANK

PROJECT NO. **85-13**

COMM. NO. **564**

PROJECT NUMBER: **85-13**

REVISION	BY	DESCRIPTION	DATE

APPROVED FOR CONSTRUCTION

Charles M. Huffine
 ROANOKE CITY ENGINEER 6/19/86
 DATE

William F. Clash
 DIRECTOR OF PUBLIC WORKS 6-19-86
 DATE

Leit B. ...
 DIRECTOR OF UTILITIES AND OPERATIONS 6/19/86
 DATE

 DATE

 DATE

ADVERTISED DATE: _____

SET NUMBER: _____

SHEET NUMBER **1** OF **6**

RECORD DRAWING