
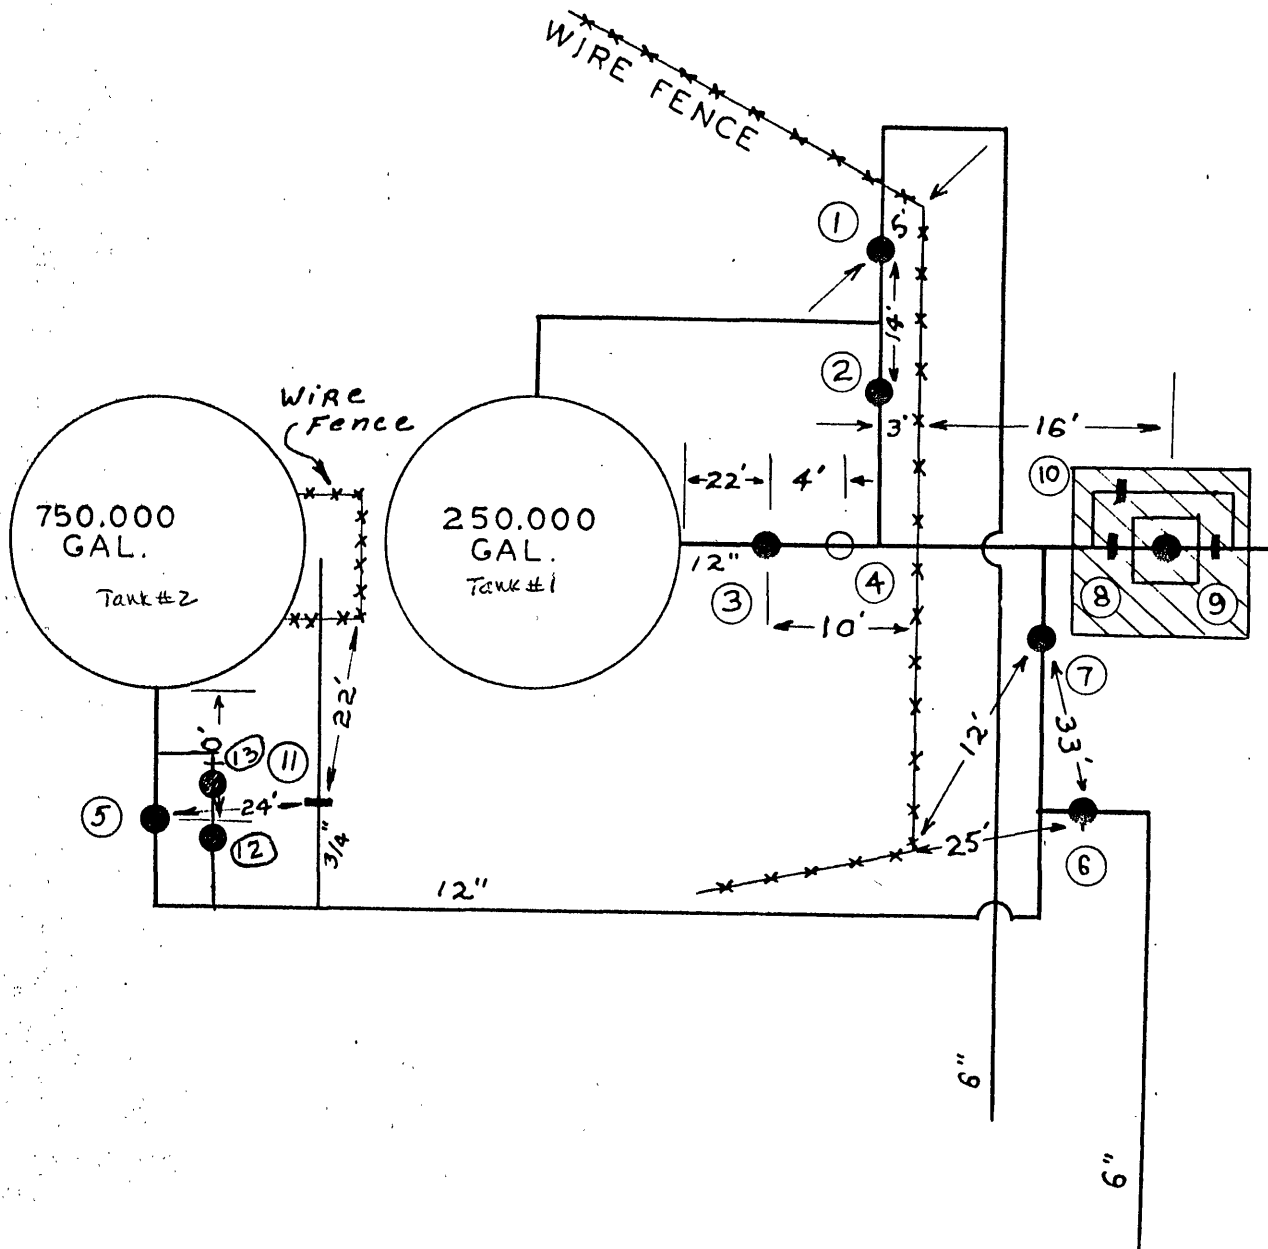


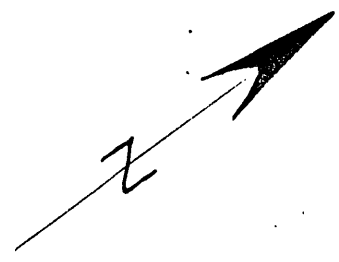

DATE	NO.	SIZE	MAKE	OPEN	TURNS
	1	6"			
	2	6"			
	3	12"			
	4	1" TAP			
	5	12"			
	6	6"			
	7	12"			
	8	12"			
	9	12"			
	10	6"			
	11	3/4" CURB COCK			
	12	4"			
	13	4"			

CITY OF ROANOKE - WATER DEPT.	
VALVE DIAGRAM	
GRANDIN COURT TANKS	
SEC. MAP 157	
DATE	PAGE NO.

30" ALUMINUM TRACING CLOTH
K & E CO., N. Y.