
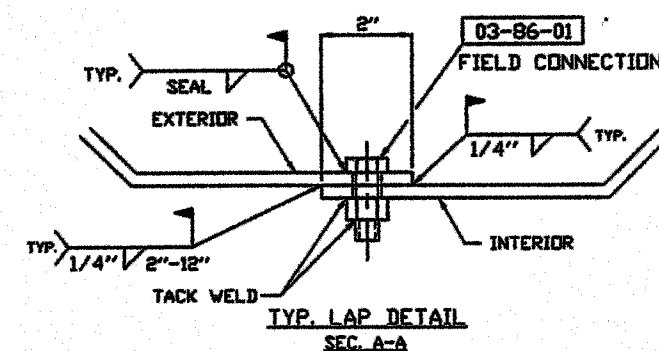
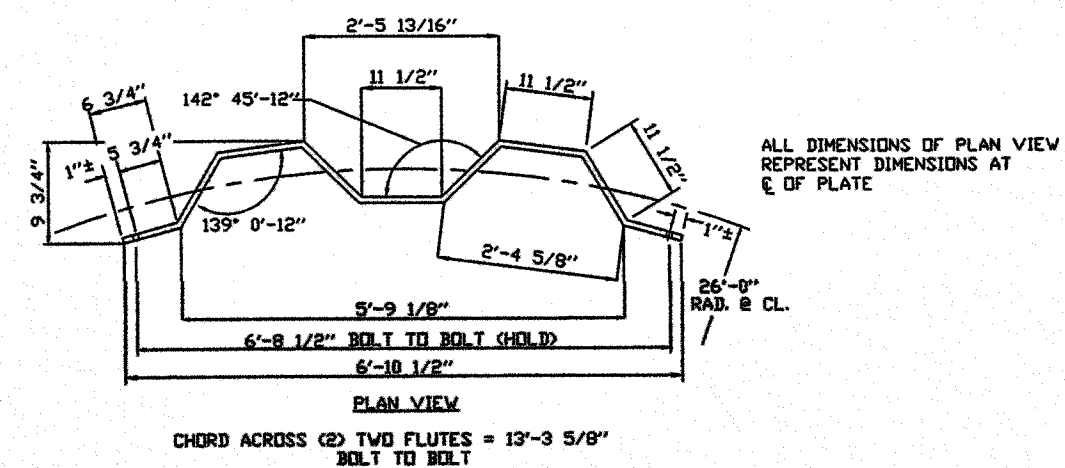
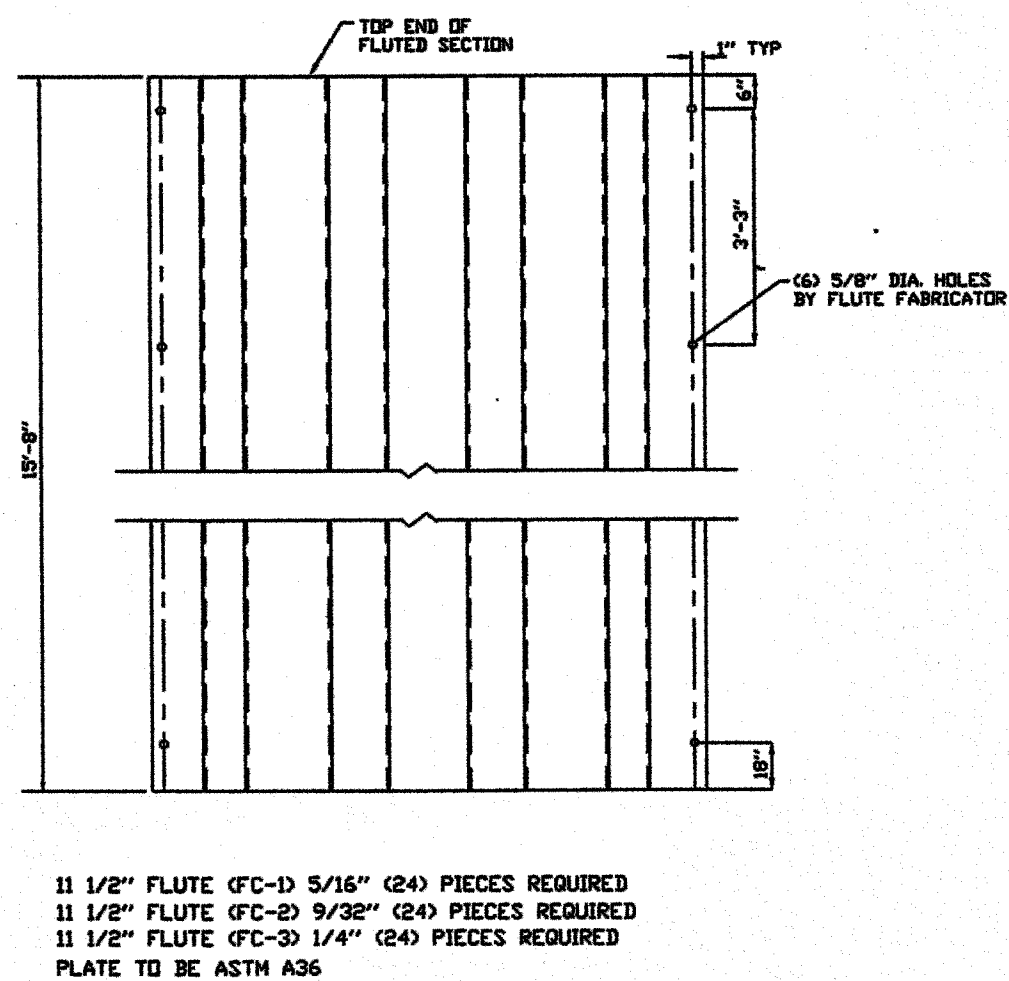


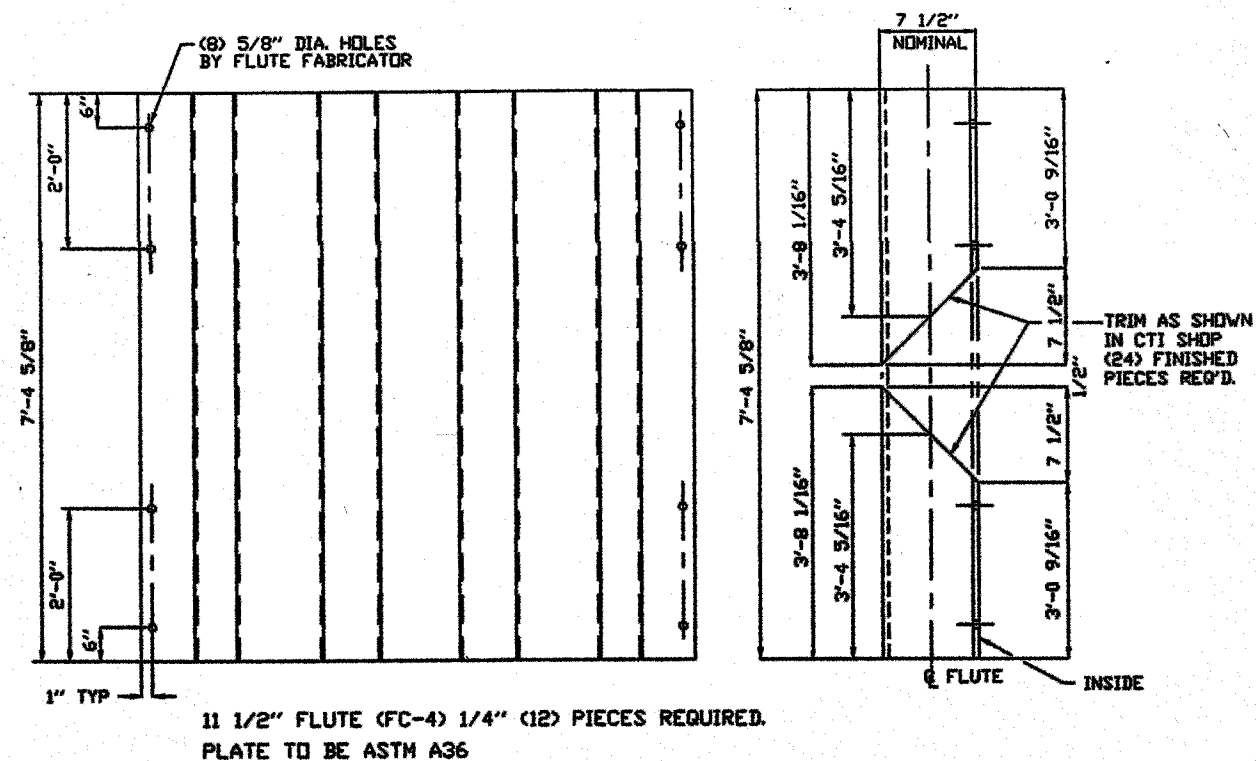

| REV.                                    | BY: | DATE        | REMARKS                          |
|-----------------------------------------|-----|-------------|----------------------------------|
| COLDWELL TANKS, INC.<br>LOUISVILLE, KY. |     |             |                                  |
| BOTETOURT COUNTY, VA                    |     |             |                                  |
| BY:                                     | BAW | DATE:       | TITLE: FLUTE FABRICATION DETAILS |
| 4-98                                    |     | DRAWING NO: | E-4291 03-A                      |