


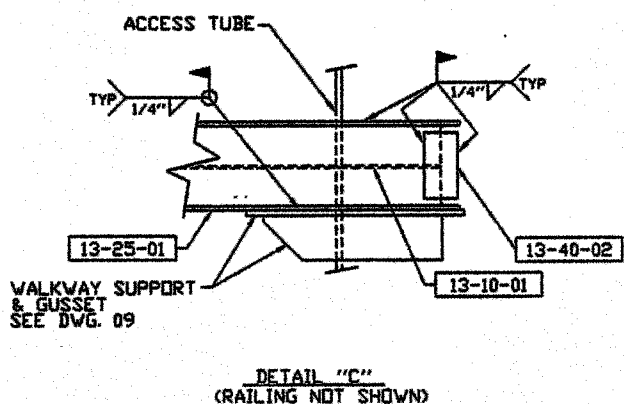

REV.	BY:	DATE	REMARKS		
CALDWELL TANKS, INC.					
LOUISVILLE, KY					
BOTETOURT COUNTY, VA					
BY:	BAW/TB	TITLE:	WALKWAY DETAILS		
DATE:	5-98	DRAWING NO.	E-4291	13	