


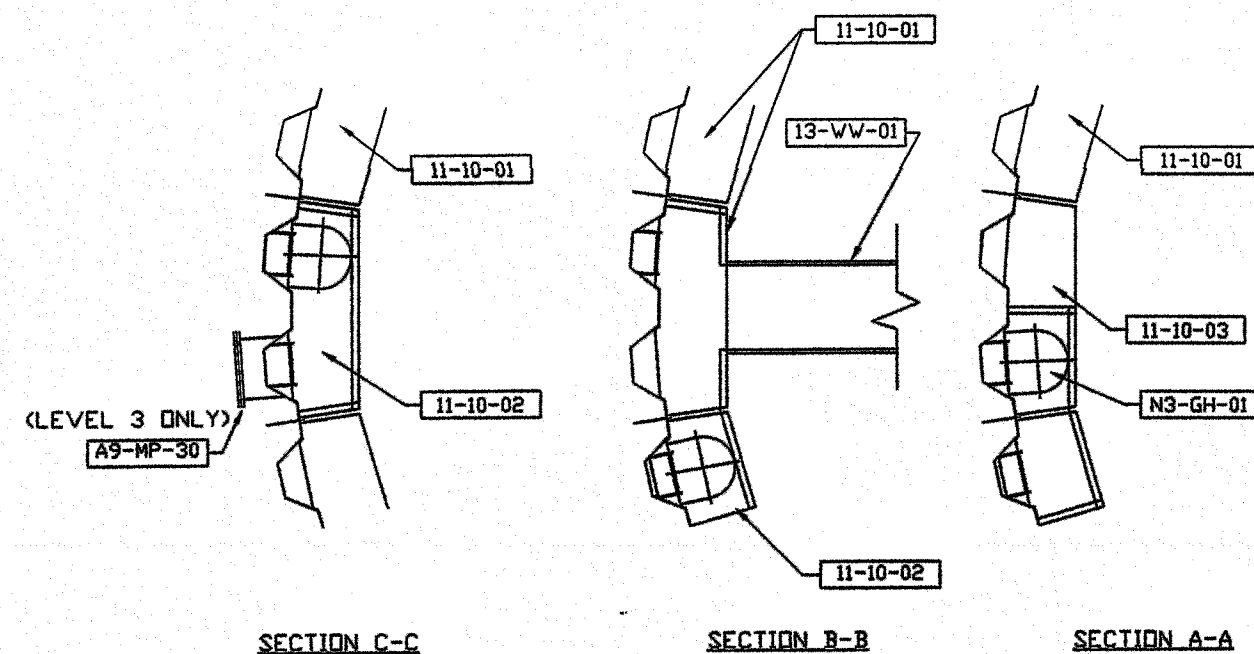

Technical drawing of a ladder elevation for a fluted column, showing various components and dimensions.

Dimensions:

- 15'-8"
- 7'-8"
- 19'-10 1/4"
- 4'-0"
- 4'-0"
- 4'-0"

Labels and Callouts:

- GIRDER LEVEL 3
- GIRDER LEVEL 2 WALKWAY ELEVATION
- GIRDER LEVEL 1 CONDENSATE CEILING LEVEL
- TOP OF FDN.
- 12-RA-01
- 12-RA-04
- 12-RA-03
- 12-RA-02
- 12-RA-02
- 12-RA-05
- 16-LA-04
- 16-LA-02
- 16-LA-01
- AP-MP-30
- FIELD WELD FLUTE SEAMS
- SHOP WELD FLUTE SEAM
- AP-MP-30
- 12-RA-01
- 12-RA-04
- 12-RA-03
- 12-RA-02
- 12-RA-02
- 12-RA-05
- 16-LA-04
- 16-LA-02
- 16-LA-01
- AP-MP-30
- FIELD WELD FLUTE SEAMS
- SHOP WELD FLUTE SEAM

Legend:


- AP-MP-30
- 12-RA-01
- 12-RA-04
- 12-RA-03
- 12-RA-02
- 12-RA-02
- 12-RA-05
- 16-LA-04
- 16-LA-02
- 16-LA-01
- AP-MP-30
- FIELD WELD FLUTE SEAMS
- SHOP WELD FLUTE SEAM

Notes:

- LADDER ELEVATION - FLUTED COLUMN
- (VIEW FROM CL. TANK - OUTWARD)

NOTES:
SEE DWG. 16 FOR LADDER DETAILS
SEE DWG. 11 & 12 FOR GIRDER DETAILS
SEE DWG. N3 FOR GIRDER HATCH DETAILS.

Ⓝ DENOTES NON-STANDARD PRACTICE

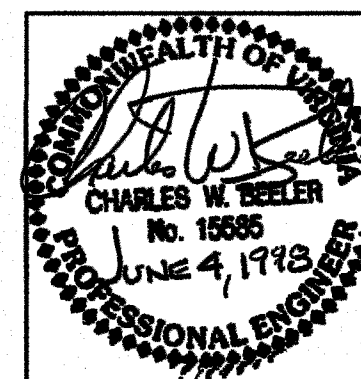

REV.	BY:	DATE	REMARKS
CALDWELL TANKS, INC. LOUISVILLE, KY.			
BOTETOURT COUNTY, VA			
BY:	BAW/TB	TITLE:	LADDER ELEVATION
DATE:	4-98	DRAWING NO.:	E-4291 15