

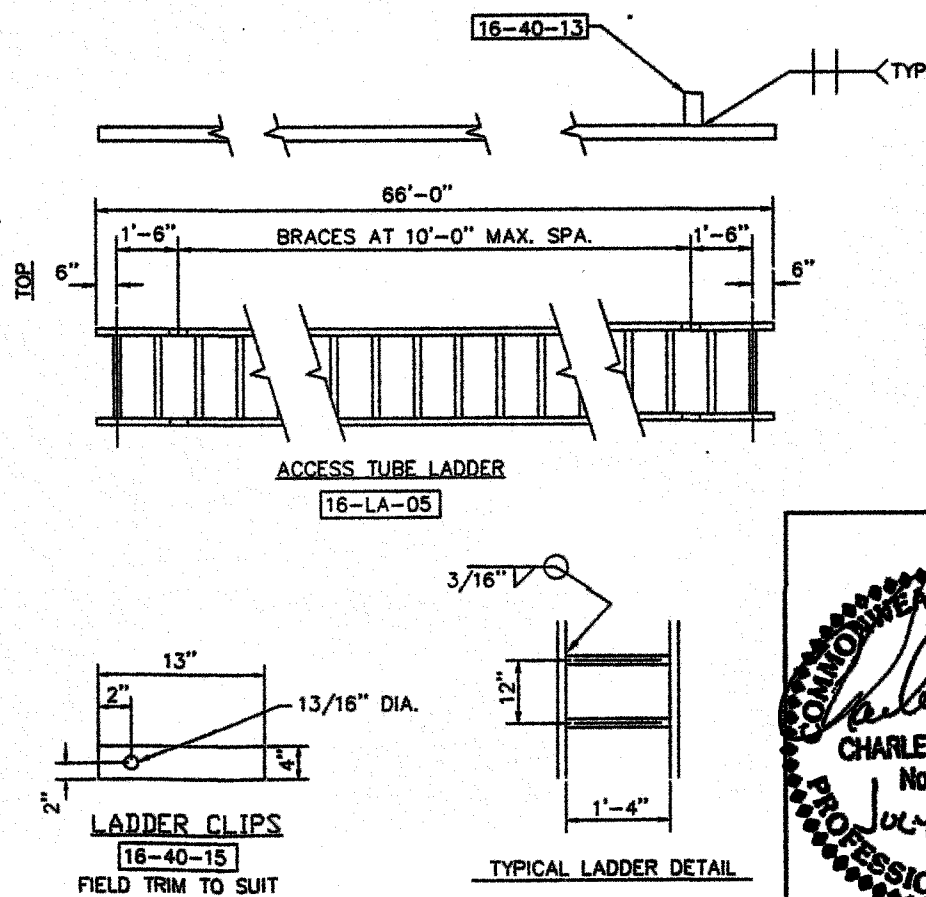
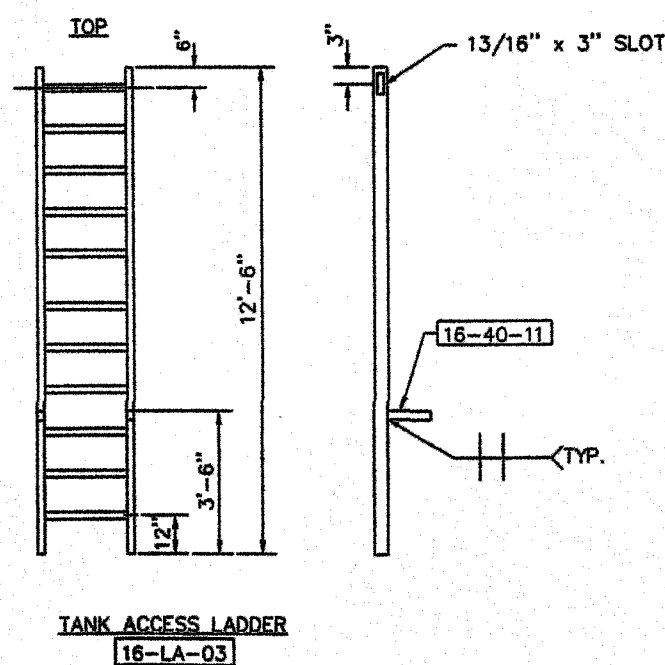
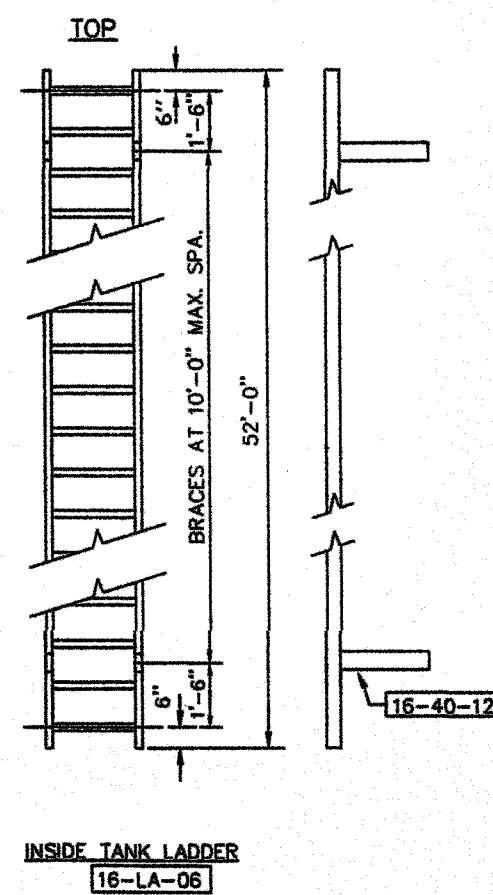
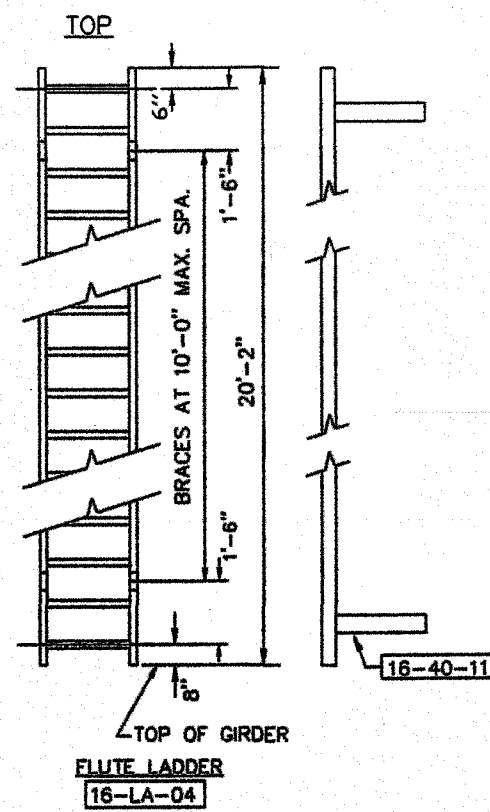
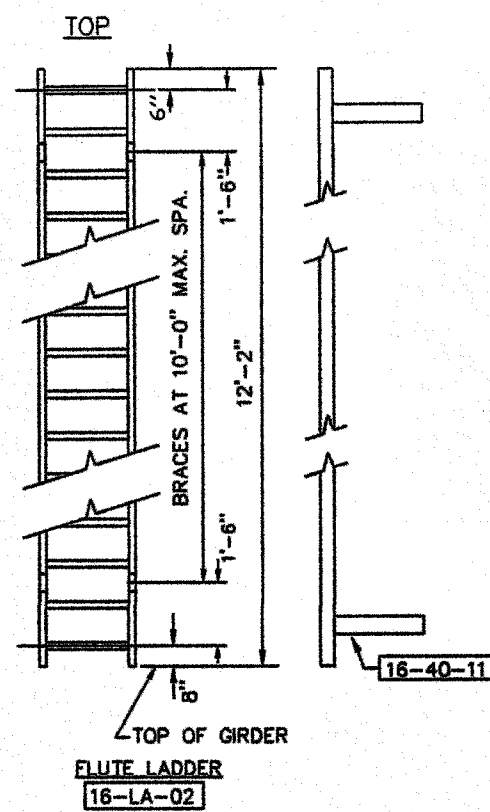


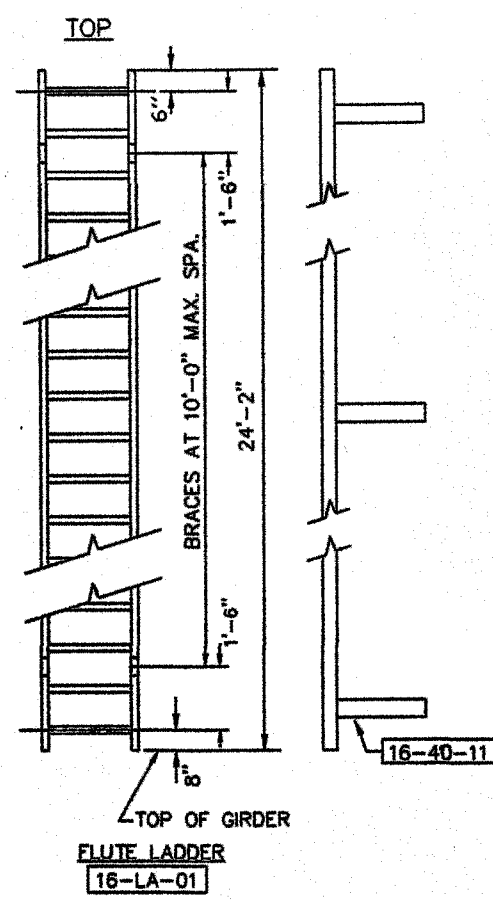

NOTE: TEMPORARY LADDER TO BE INSTALLED IN TEMPORARY RISER ASSEMBLY (SEE DWG 09).

SUB ASSY NO	PART NO	QTY	DESCRIPTION	MATERIAL	WT/PC	TOTAL WT
16-LA-01		1	FLUTE LADDER			180
	16-40-02	2	STRINGER	2" x 3/8" BAR x 24'-2"		
	16-35-01	24	RUNG	3/4" DIA. REBAR x 1'-4" LG.		
	16-40-11	6	BRACE	2" x 3/8" BAR x 6" LG.		
16-LA-02		1	FLUTE LADDER			90
	16-40-02	2	STRINGER	2" x 3/8" BAR x 12'-2"		
	16-35-01	12	RUNG	3/4" DIA. REBAR x 1'-4" LG.		
	16-40-11	4	BRACE	2" x 3/8" BAR x 6" LG.		
16-LA-03		1	TANK ACCESS LADDER			90
	16-40-02	2	STRINGER	2" x 3/8" BAR x 12'-6"		
	16-35-01	12	RUNG	3/4" DIA. REBAR x 1'-4" LG.		
	16-40-11	2	BRACE	2" x 3/8" BAR x 6" LG.		
16-LA-04		1	FLUTE LADDER			150
	16-40-02	2	STRINGER	2" x 3/8" BAR x 20'-2"		
	16-35-01	20	RUNG	3/4" DIA. REBAR x 1'-4" LG.		
	16-40-11	6	BRACE	2" x 3/8" BAR x 6" LG.		
16-LA-05		1	ACCESS TUBE LADDER	(SHIP W/ ACCESS TUBE)		470
	16-40-05	2	STRINGER	2" x 3/8" BAR x 66'-0"		
	16-35-01	66	RUNG	3/4" DIA. REBAR x 1'-4" LG.		
	16-40-11	16	BRACE	2" x 3/8" BAR x 6" LG.		
16-LA-06		1	INSIDE TANK LADDER			385
	16-40-05	2	STRINGER	2" x 3/8" BAR x 52'-0" LG.		
	16-35-01	52	RUNG	3/4" DIA. REBAR x 1'-4" LG.		
	16-40-12	12	BRACE	2" x 3/8" BAR x 8" LG.		
ALL ITEMS LISTED BELOW ARE SHIPPED LOOSE						
	16-40-15	2	LADDER CLIP	4" x 3/8" BAR x 1'-1"		
	16-86-01	2	LADDER CLIP BOLT	3/4" x 2" LG. ZINC PL. BOLT		
	16-70-01	2	SLEEVE - SHIP DIRECT	304 STAINLESS STEEL		
	16-70-02	2	HARNESS - SHIP DIRECT	304 STAINLESS STEEL		
	16-70-03	2	CONNECTOR	A36 STEEL, ZINC PL.		
	16-70-04	6	TOP BRACKET	GALVANIZED		
	16-70-05	8	CABLE GUIDE	NON-METALLIC		
	16-70-06	6	BOTTOM BRACKET	GALVANIZED		
	16-70-07	1	24 LIN. FT. CABLE (16-LA-01)	3/8" GALVANIZED		
	16-70-08	1	12 LIN. FT. CABLE (16-LA-02)	3/8" GALVANIZED		
	16-70-09	1	12 LIN. FT. CABLE (16-LA-03)	3/8" GALVANIZED		
	16-70-10	1	20 LIN. FT. CABLE (16-LA-04)	3/8" GALVANIZED		
	16-70-11	63	LIN. FT. CABLE (16-LA-05)	3/8" GALVANIZED		
	16-70-12	52	LIN. FT. CABLE (16-LA-06)	3/8" STAINLESS STEEL		

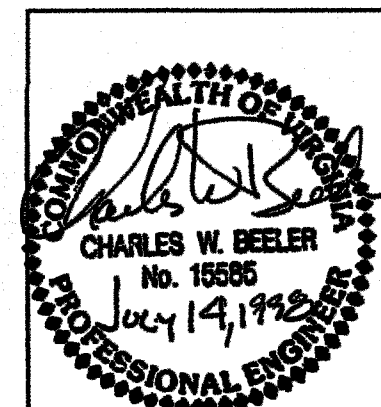

REV.	BY:	DATE	REMARKS
A	BAW	6-98	AS NOTED
Caldwell Tanks, Inc.			
LOUISVILLE, KY.			
BOTETOURT COUNTY, VA			
BY:	BAW	TB	TITLE: LADDER DETAILS
DATE:	4-98	DRAWING NO:	E-4291 16