
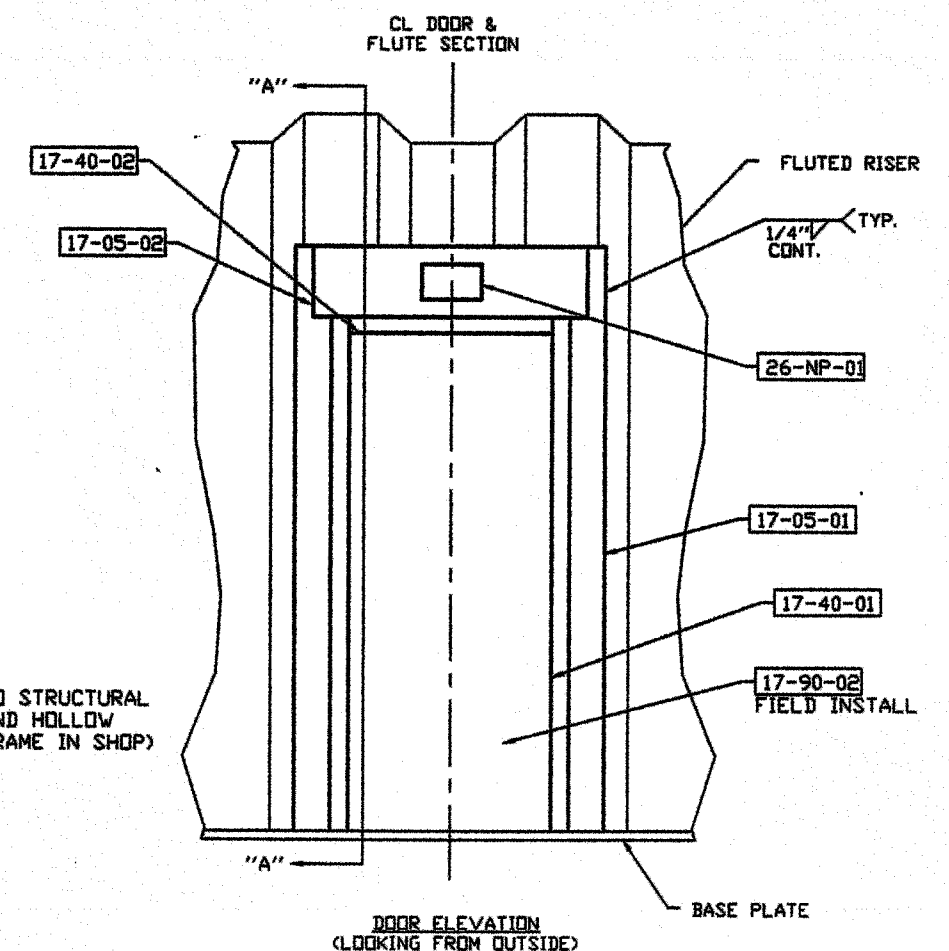




Diagram of the Door Side Frame showing dimensions and part numbers:

- Overall height: 7'-11"
- Top section height: 12"
- Top section width: 3/8"
- Top section part number: 17-40-04
- Section below top: 11 5/8"
- Section below that: 3"
- Section below that: 6"
- Section below that part number: 17-05-01

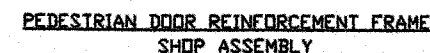

-
- COMMONWEALTH OF VIRGINIA
Charles W. Beeler
 CHARLES W. BEELER
 No. 15585
 JUNE 4, 1978
 PROFESSIONAL ENGINEER

71