




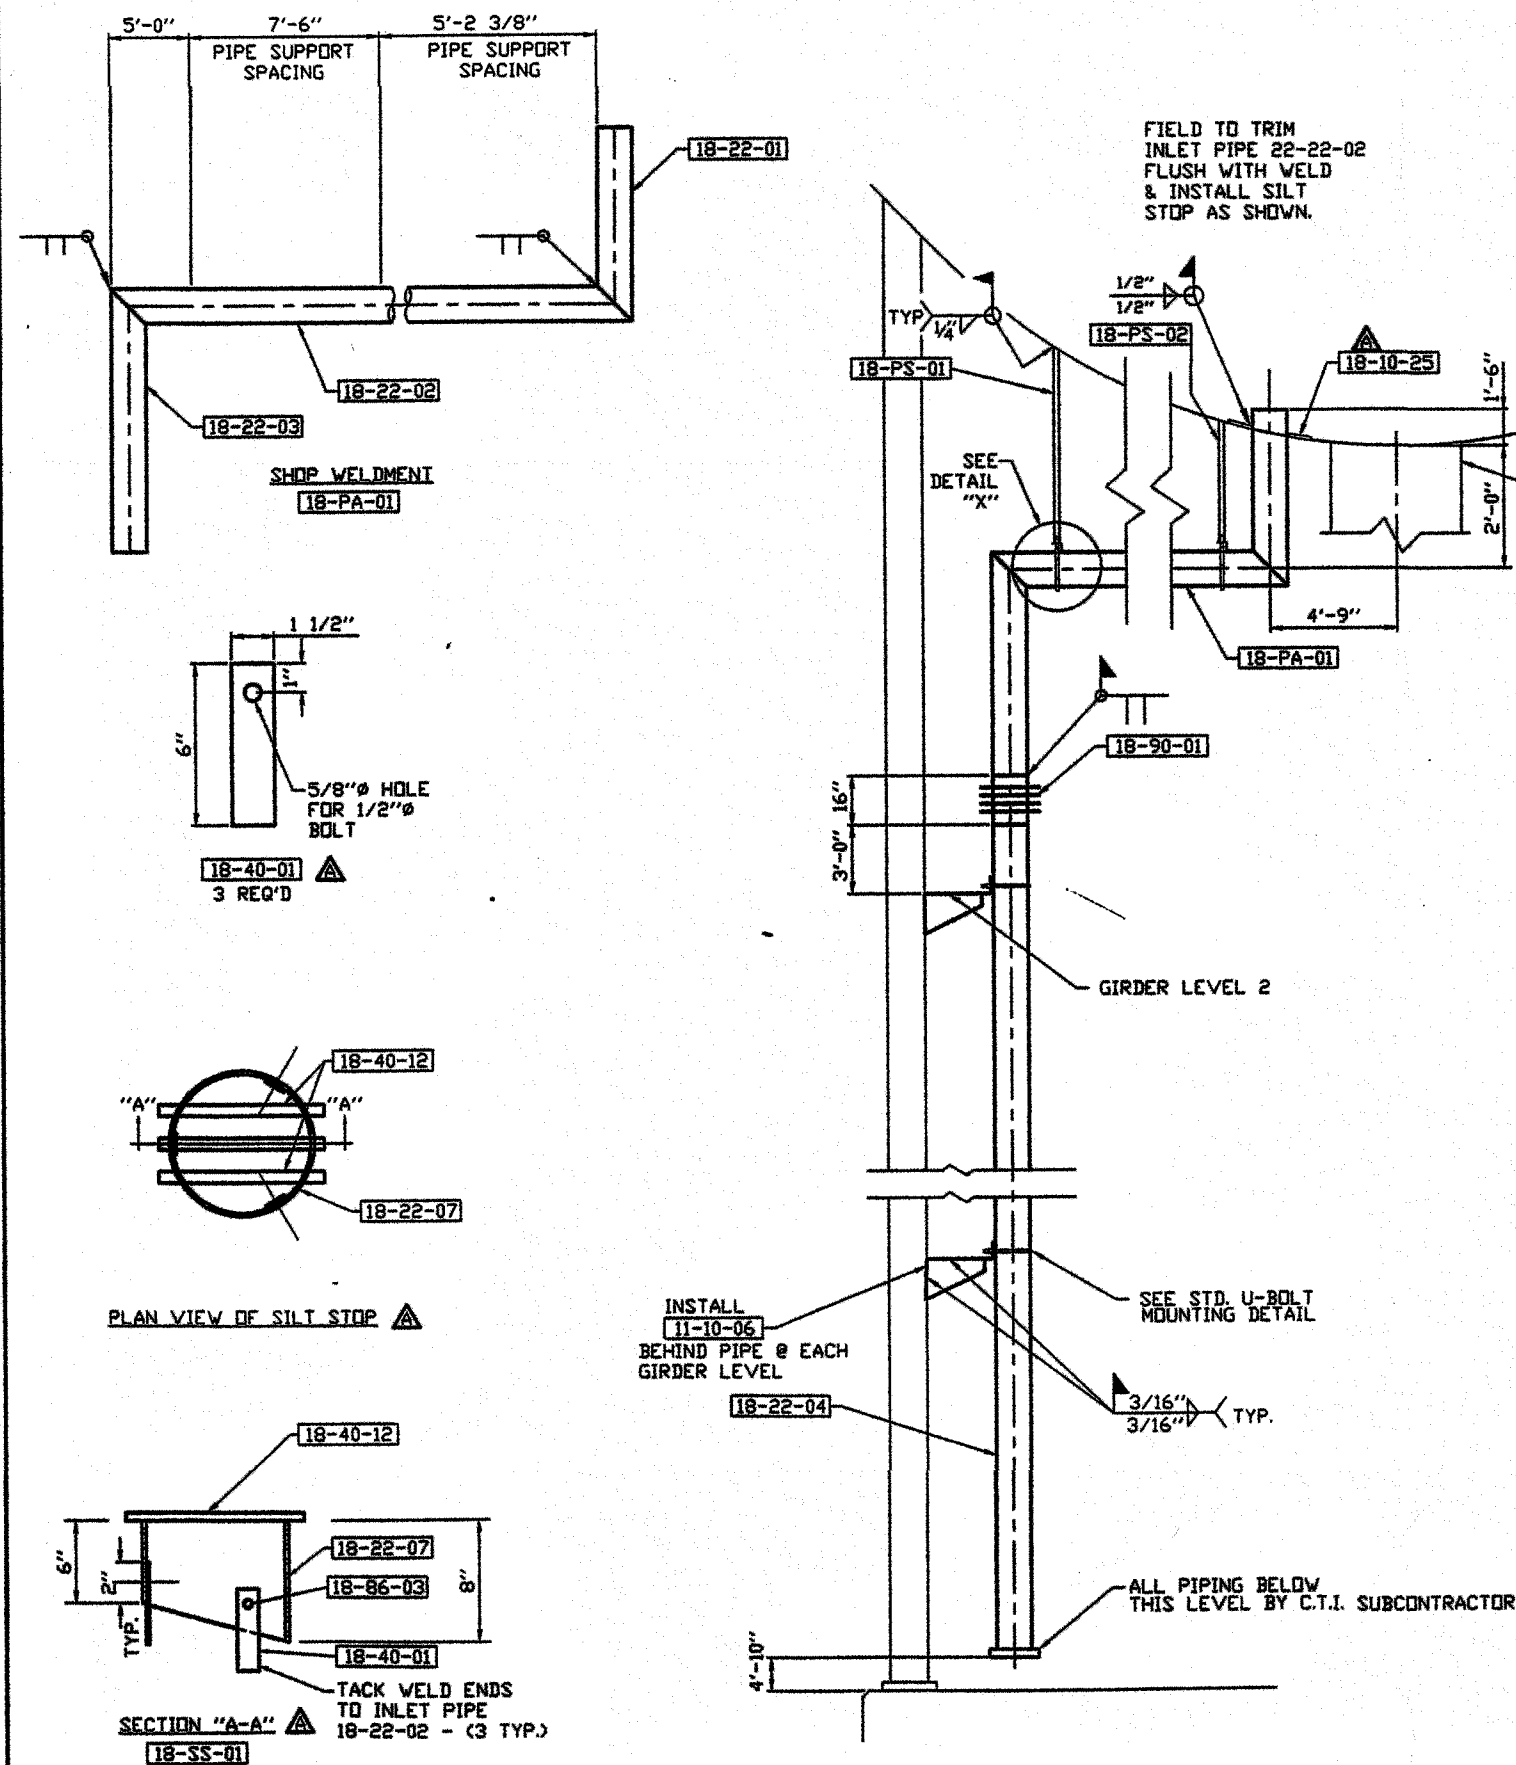

| SUB-ASSY. NO                              | PART NO. | QTY | DESCRIPTION                | MATERIAL                                     | PC. WT. | TOTAL |
|-------------------------------------------|----------|-----|----------------------------|----------------------------------------------|---------|-------|
| 18-PA-01                                  |          | 1   | INLET PIPE ASSY.           |                                              |         | 2600  |
|                                           | 18-22-01 | 1   | STEEL PIPE                 | 24" X-STR PIPE x 3'-6" LG.                   | 440     |       |
|                                           | 18-22-02 | 1   | STEEL PIPE                 | 24" STD. WT. PIPE x 17'-8 3/8" LG ON CL.     | 1680    |       |
|                                           | 18-22-03 | 1   | STEEL PIPE                 | 24" STD. WT. PIPE x 5'-1"                    | 480     |       |
| 18-PS-01                                  |          | 1   | INLET PIPE SUPPORT         |                                              |         |       |
|                                           | 18-22-05 | 1   | PIPE SUPPORT               | PIPE 3" DIA. x STD WT x 6'-6" (FIELD TRIM)   |         |       |
|                                           | 18-30-01 | 1   | ANGLE BRACE                | ANGLE 4" x 4" x 1/4" x 30"                   |         |       |
| 18-PS-02                                  |          | 1   | INLET PIPE SUPPORT         |                                              |         |       |
|                                           | 18-22-06 | 1   | PIPE SUPPORT               | PIPE 3" DIA. x STD WT x 3'-0" (FIELD TRIM)   |         |       |
|                                           | 18-30-01 | 1   | ANGLE BRACE                | ANGLE 4" x 4" x 1/4" x 30"                   |         |       |
| 18-SS-01                                  |          | 1   | SILT STOP ASSEMBLY         |                                              | 60      |       |
|                                           | 18-22-07 | 1   | SILT STOP                  | 12" Ø x X-HVY PIPE x 8" (DROP FROM 18-22-02) |         |       |
|                                           | 18-40-01 | 3   | LUG                        | 2" x 1/4" BAR x 6" LG                        |         |       |
|                                           | 18-86-03 | 3   | BOLT                       | 1/2" Ø x 1 1/2" N. BOLT W/ NUT               |         |       |
|                                           | 18-40-12 | 3   | PROTECTIVE BARS            | 3/4" SQ. x 28" LG.                           |         |       |
| ITEMS LISTED BELOW ARE SHIPPED SEPARATELY |          |     |                            |                                              |         |       |
|                                           | 18-22-04 | 26  | STEEL PIPE LIN. FT.        | 24" STD. WT. PIPE (SEE NOTE)                 | 2460    |       |
|                                           | 18-90-01 | 1   | STD. EXPANSION JOINT       | 24" Ø STD. 150# BELLOWS-TYPE                 |         |       |
|                                           | 18-86-01 | 4   | U-BOLTS W/ NUTS            | FOR 24" Ø STD. WT. PIPE                      |         |       |
|                                           | 18-10-25 | 1   | PLATE RING (2 PIECES)      | 31" O.D. x 24 1/4" I.D. x 3/8"               |         |       |
|                                           | 18-86-02 | 20  | BOLTS FOR FLG'D CONNECTION | 1 1/4" DIA. x 5 1/2" LG. w/ NUT              |         |       |
|                                           | 18-90-02 | 1   | STD. GASKET                | FOR 24" FLG'D CONNECTION                     |         |       |

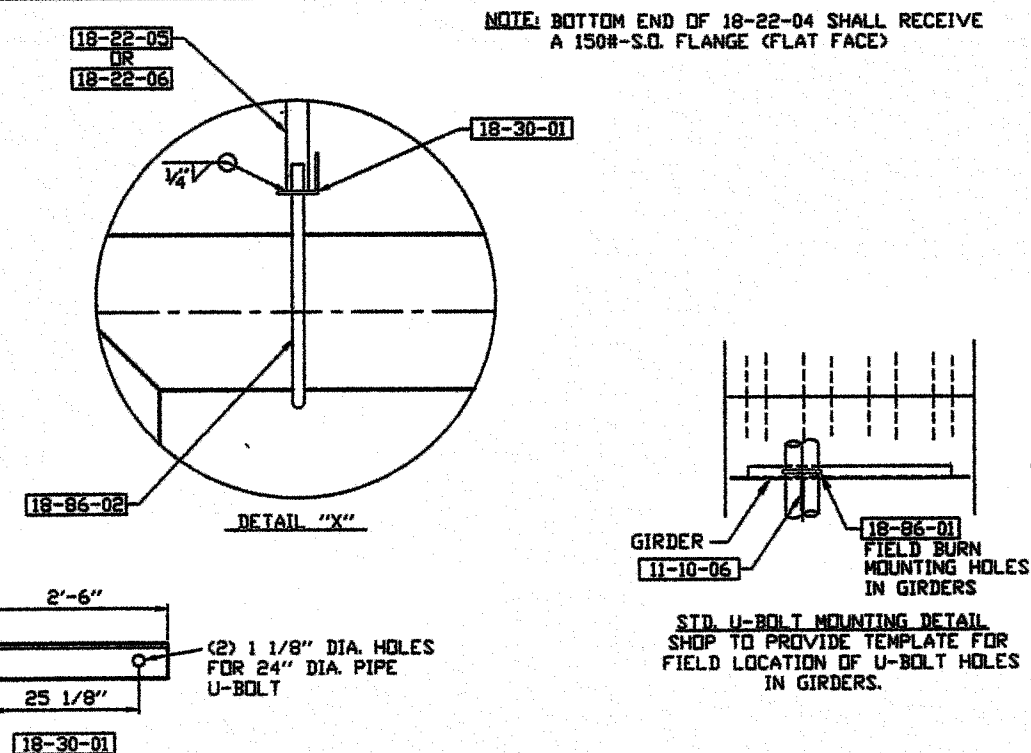

NOTE:  
1. SEE DRAWING E-4291 02 FOR ORIENTATION OF PIPING

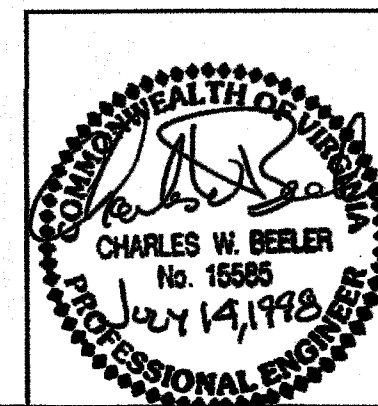

|                                         |      |      |             |                      |
|-----------------------------------------|------|------|-------------|----------------------|
|                                         |      |      |             |                      |
| A                                       | BAW  | 6/98 | AS NOTED    |                      |
| REV.                                    | BY:  | DATE | REMARKS     |                      |
| CALDWELL TANKS, INC.<br>LOUISVILLE, KY. |      |      |             |                      |
| BOTETOURT COUNTY, VA                    |      |      |             |                      |
| BY:                                     | BAW  | TB   | TITLE:      | INLET PIPING DETAILS |
| DATE:                                   | 5-98 |      | DRAWING NO. | E-4291 18            |