

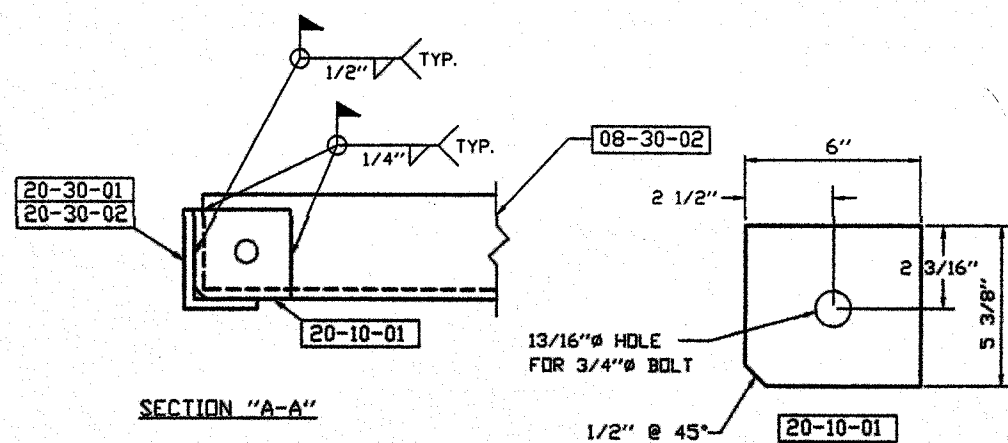
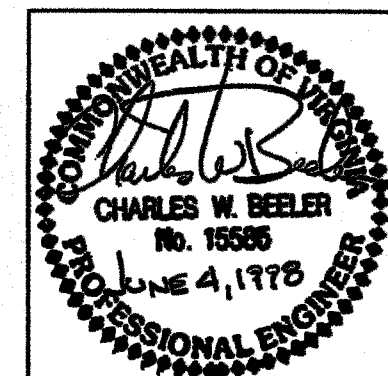
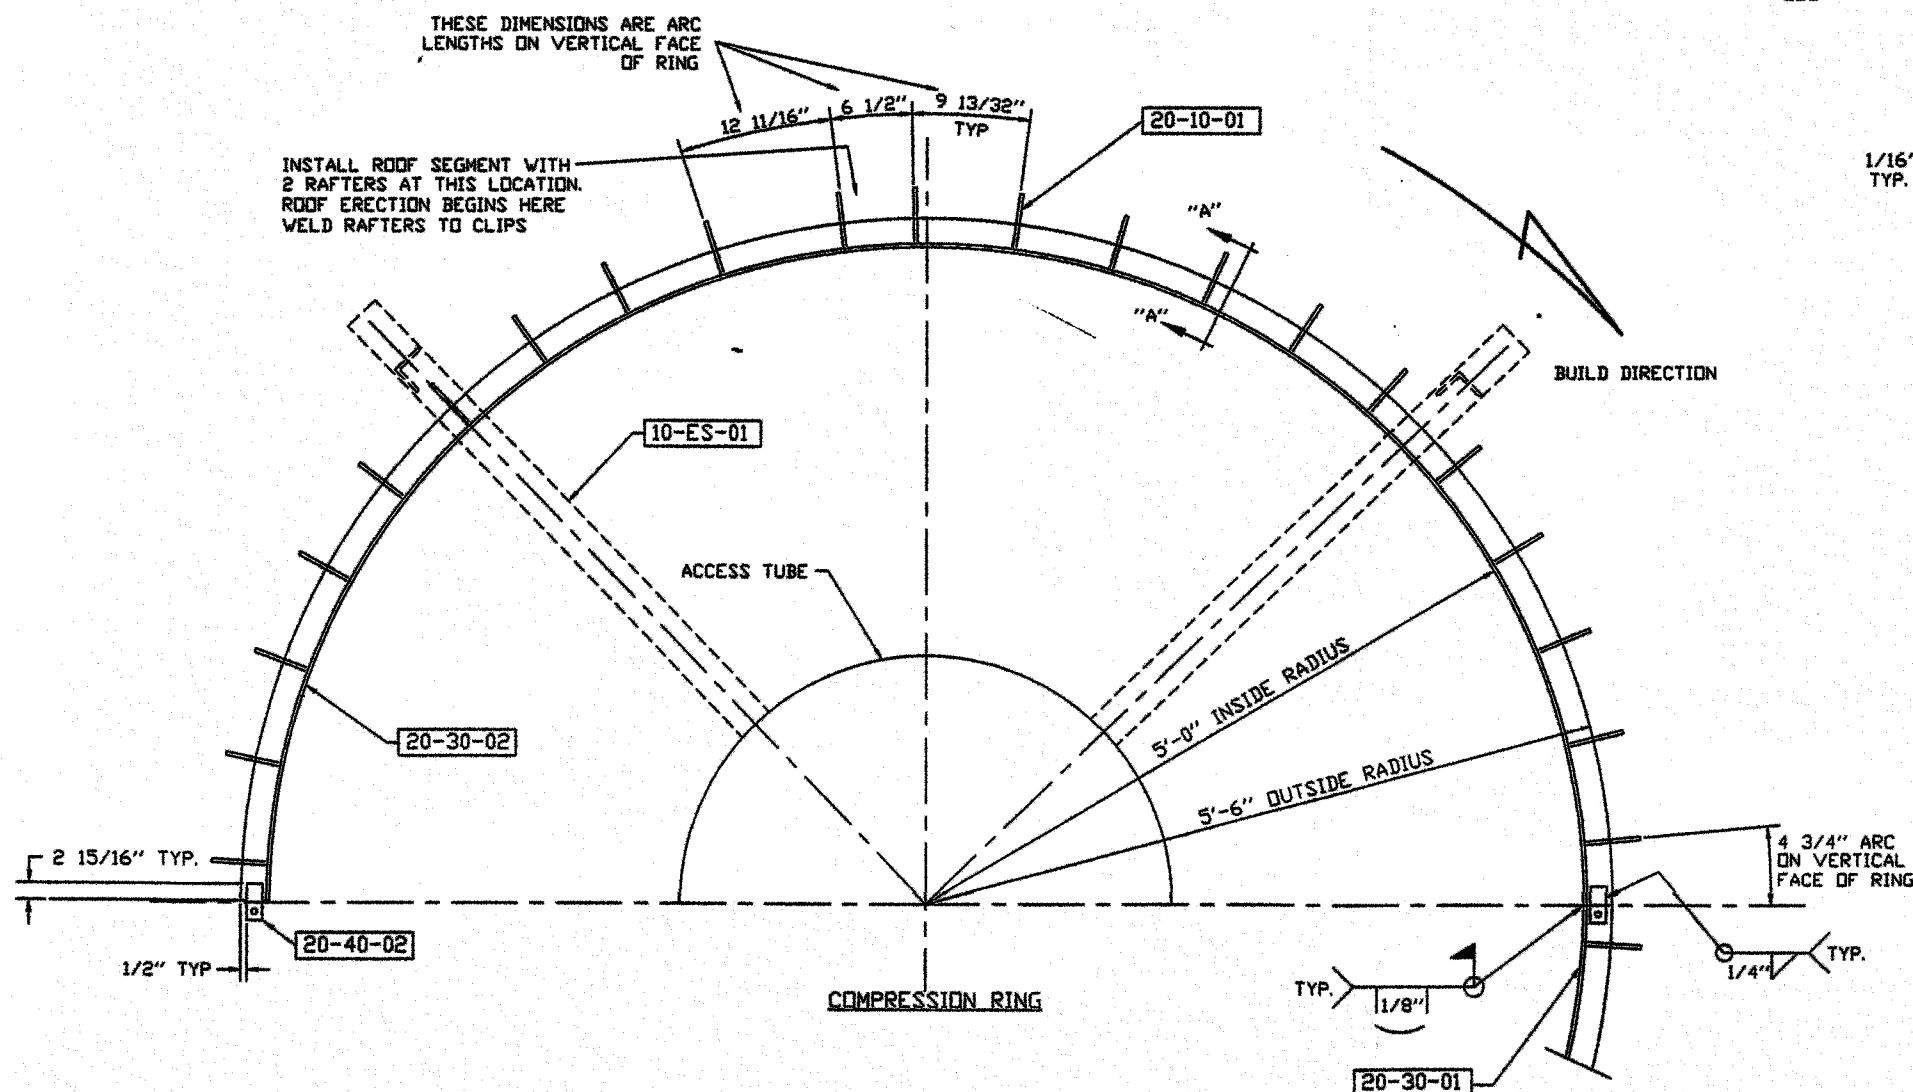


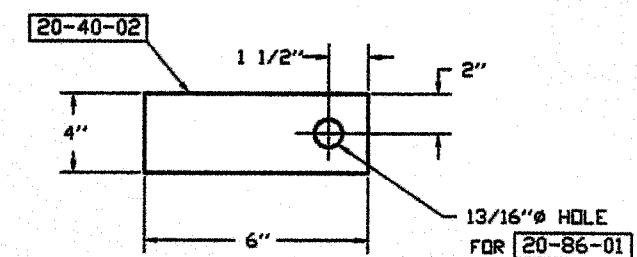

| BILL OF MATERIAL                          |          |      |                            |                                      |               |
|-------------------------------------------|----------|------|----------------------------|--------------------------------------|---------------|
| SUB ASSY NO                               | PART NO  | QTY. | DESCRIPTION                | MATERIAL                             | WT./PC. TOTAL |
| 20-CR-02                                  |          | 1    | COMPRESSION RING ASSY.     |                                      | 455           |
|                                           | 20-30-02 | 1    | COMPRESSION RING W/O HOLES | 6" x 6" x 5/8" STL. ANGLE 18'-5" LG. | 450           |
|                                           | 20-40-02 | 2    | SPLICE BARS                | 4" x 3/8" STL. BAR X 6" LG.          |               |
| ITEMS LISTED BELOW ARE SHIPPED SEPARATELY |          |      |                            |                                      |               |
|                                           | 20-86-01 | 2    | COMPRESSION RING BOLTS     | 3/4" x 1 1/2" LG. M. BOLT            |               |
|                                           | 20-10-01 | 40   | RAFTER CLIPS               | 6" x 1/2" PLATE x 5 3/8" LG.         |               |
|                                           | 20-86-02 | 40   | RAFTER CLIP BOLT           | BOLT 3/4" x 1 1/2" LG. W/ NUT        |               |
|                                           | 20-30-01 | 1    | COMPRESSION RING w/HOLES   | 6" x 6" x 5/8" STL. ANGLE 18'-5" LG. | 450           |

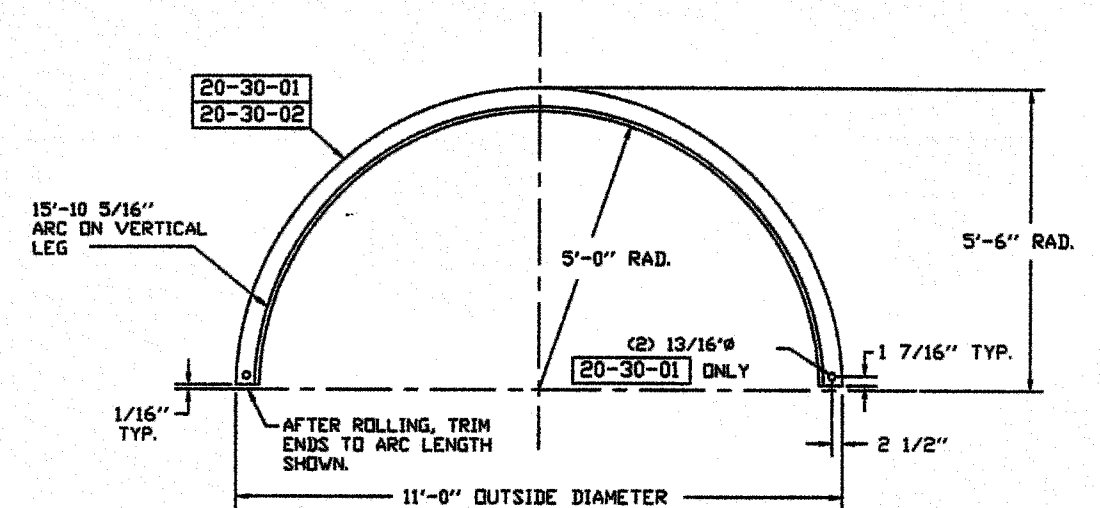

| REV.                                    | BY                           | DATE | REMARKS |
|-----------------------------------------|------------------------------|------|---------|
|                                         |                              |      |         |
| CALDWELL TANKS, INC.<br>LOUISVILLE, KY. |                              |      |         |
| BOTETOURT COUNTY, VA                    |                              |      |         |
| BY: BAW/TB                              | TITLE: ROOF COMPRESSION RING |      |         |
| DATE: 5-98                              | DRAWING NO: E-4291           | 20   |         |