


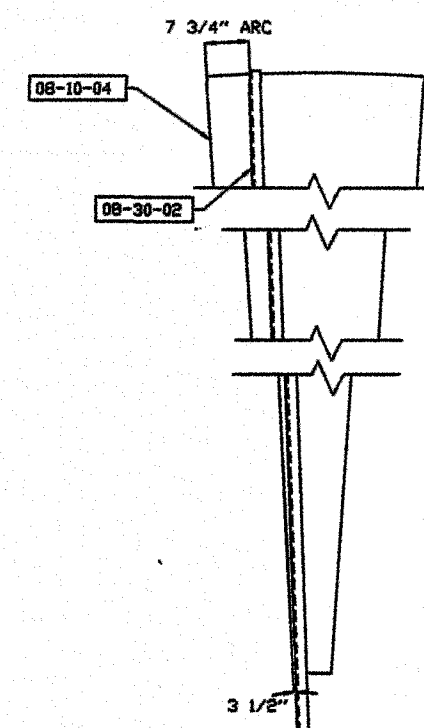
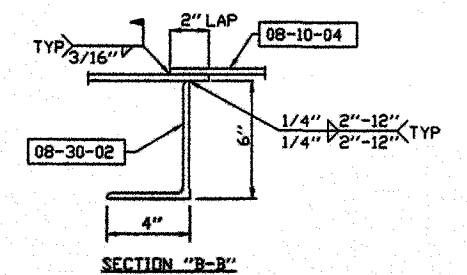
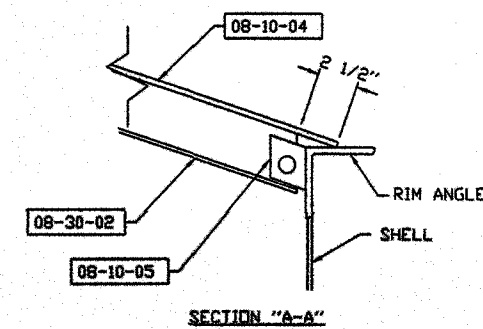


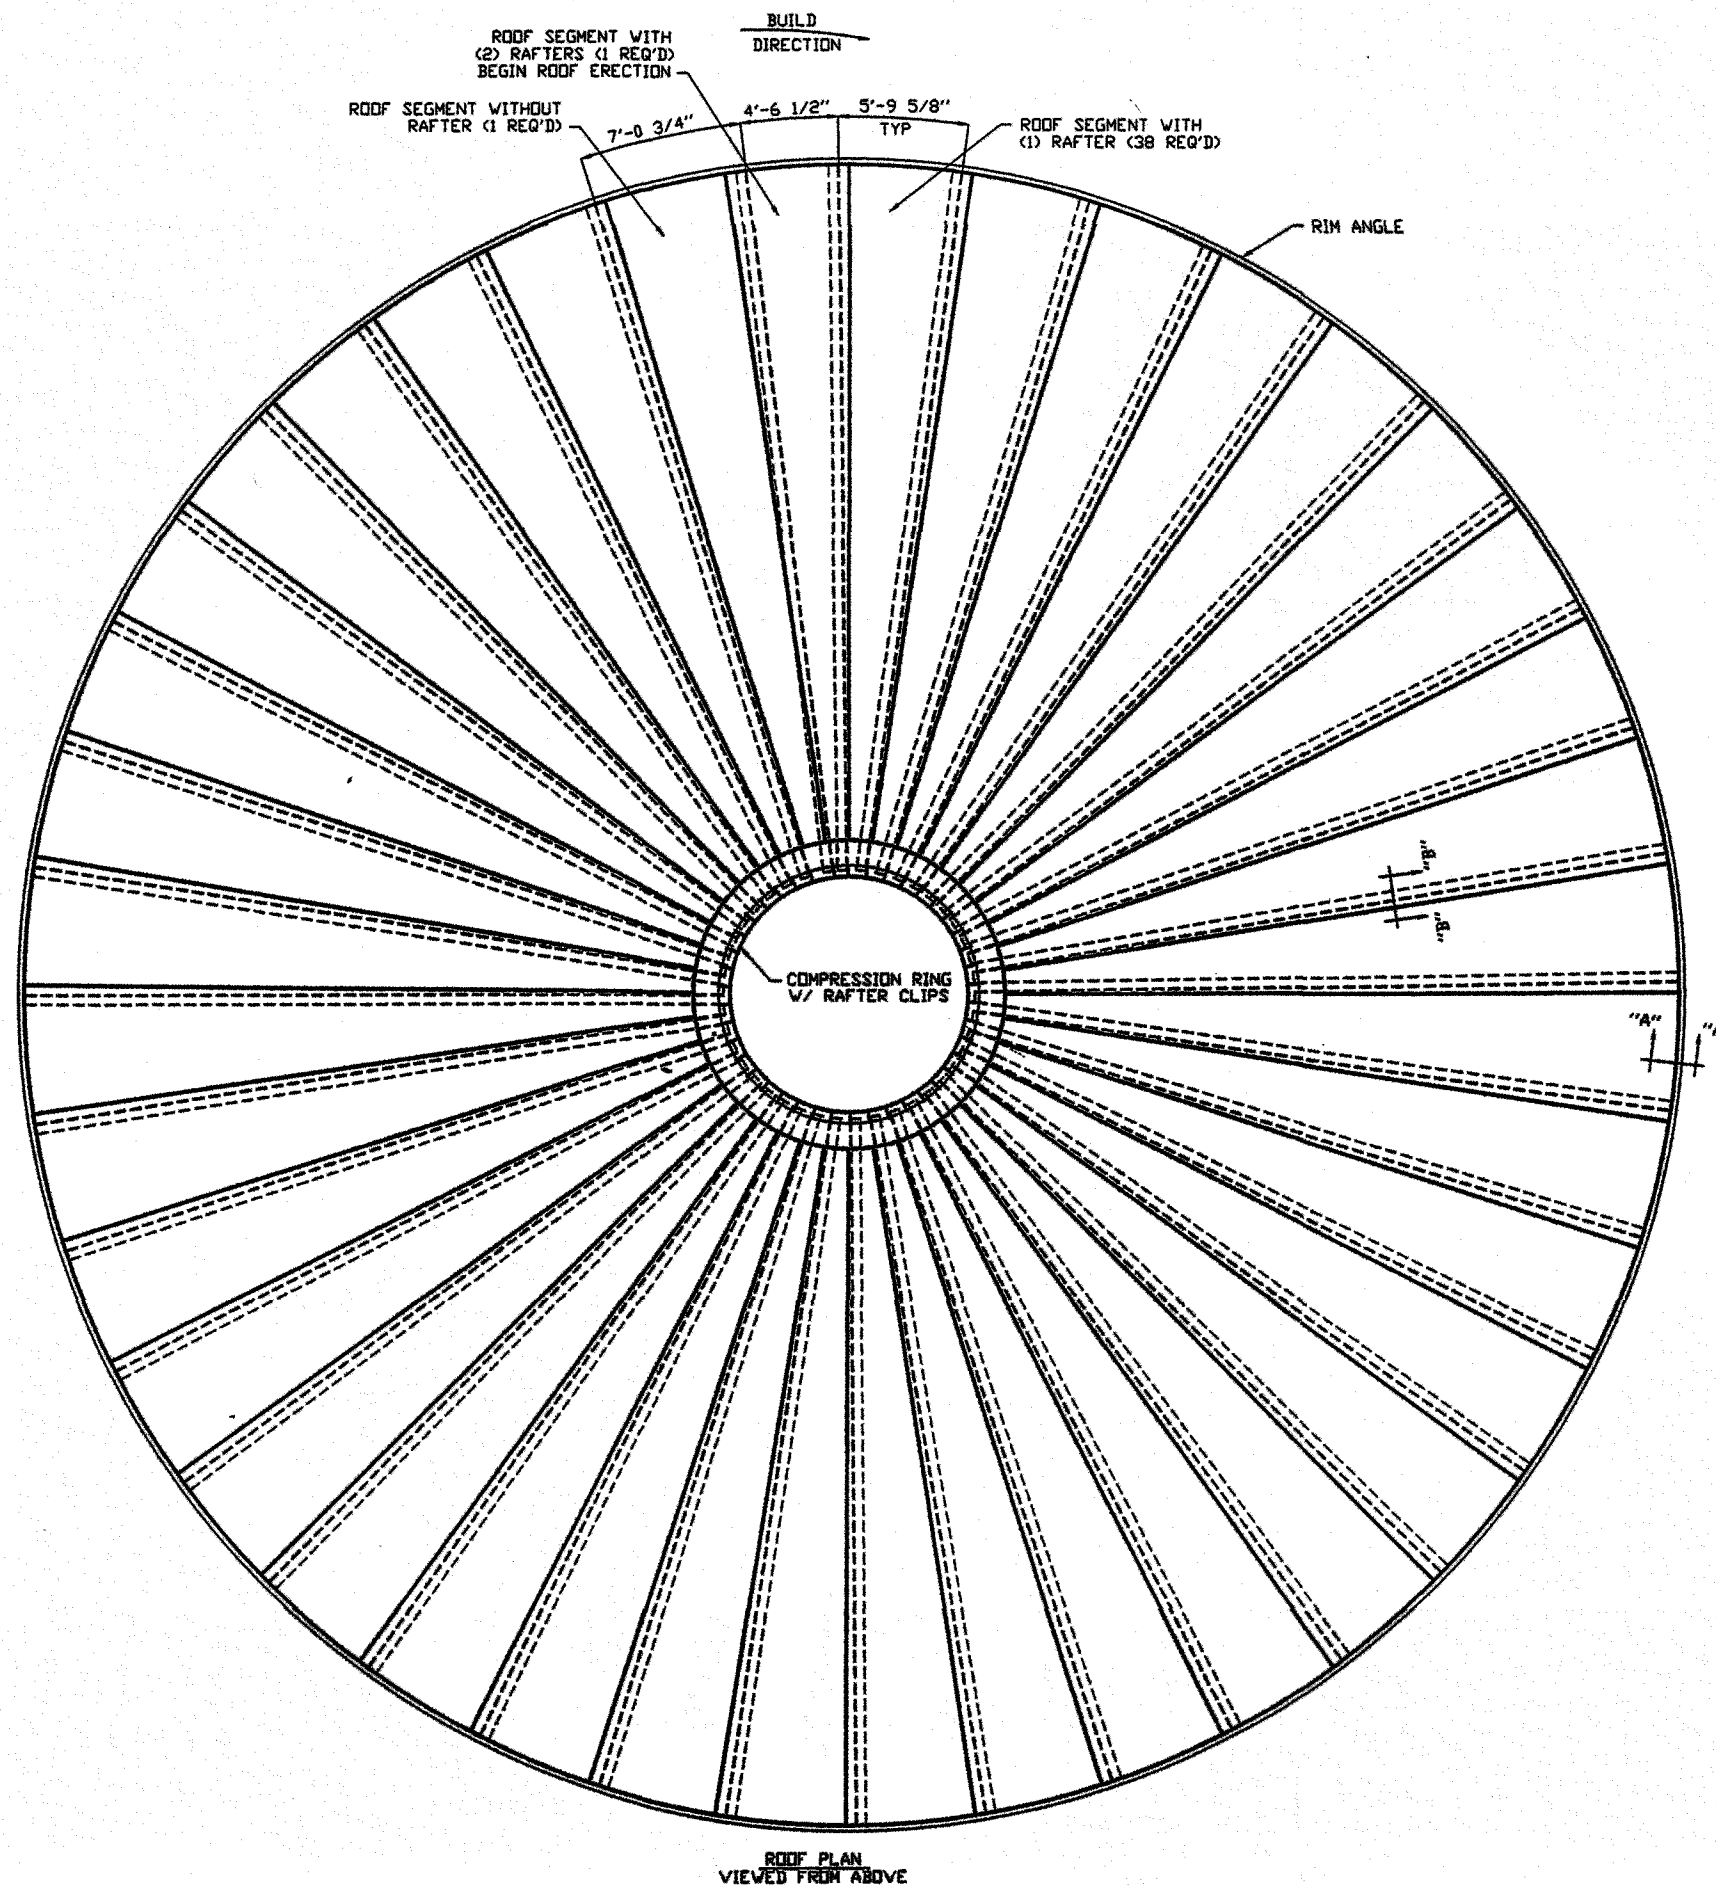

ROOF TAIL/RAFTER ASSY
VIEWED FROM UNDERSIDE
OF ROOF TAIL
08-RS-01

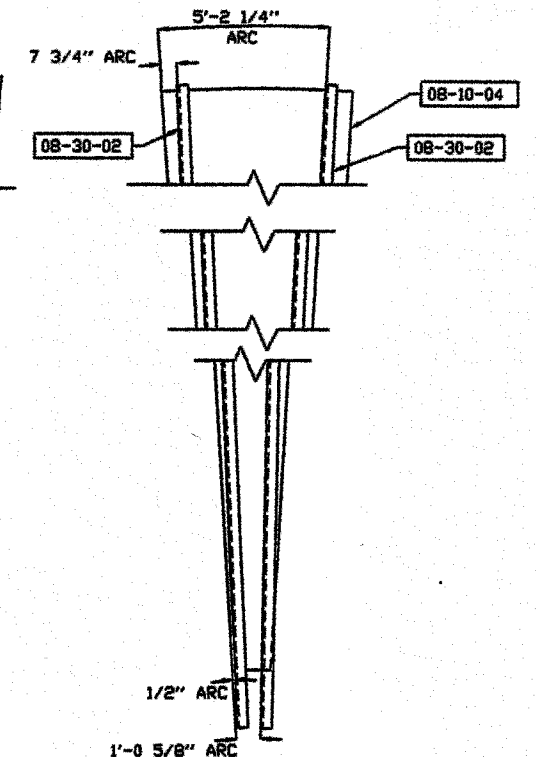

ROOF TAIL/RAFTER ASSY
VIEWED FROM UNDERSIDE
OF ROOF TAIL
08-RS-02

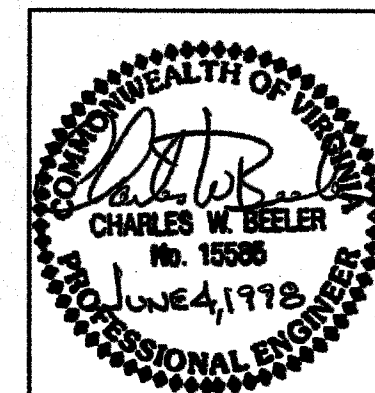

REV.	BY:	DATE	REMARKS
Caldwell Tanks, Inc.			
Louisville, KY			
BOTETOURT COUNTY, VA			
BY:	BAW/TB	TITLE:	ROOF ASSEMBLY
DATE:	5-98	DRAWING NO:	E-4291