

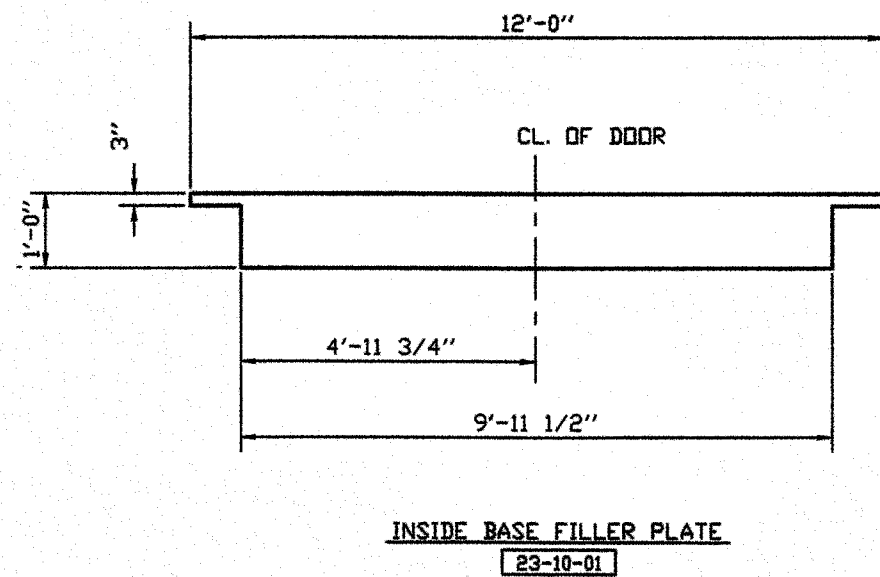


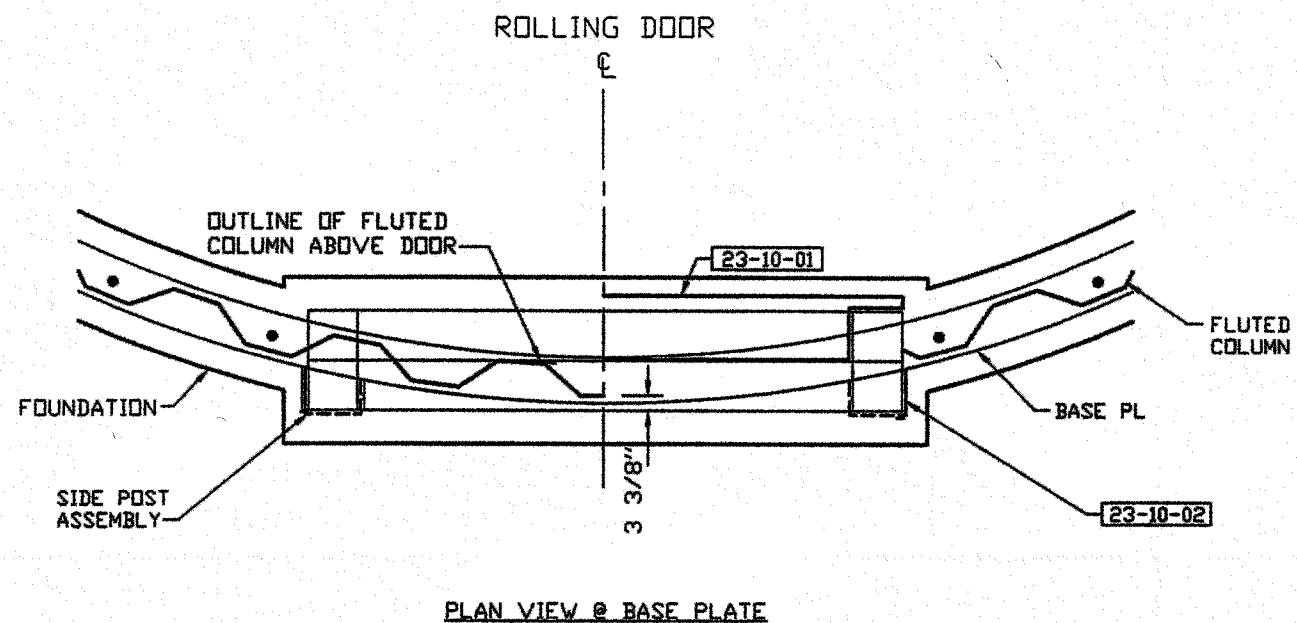

SUB ASS'Y NO.	PART NO.	QUANTITY	DESCRIPTION	MATERIAL REQ'D.	PC WT	TOT WT
ALL ITEMS SHIP LOOSE						
	23-10-01	1	INSIDE BASE FILLER PLATE	12" x 1/4" x 12'-0" LG.	143	
	23-10-02	2	BASE FILLER PLATE	1 1/4" PL. (MISC. DROP)	57	114

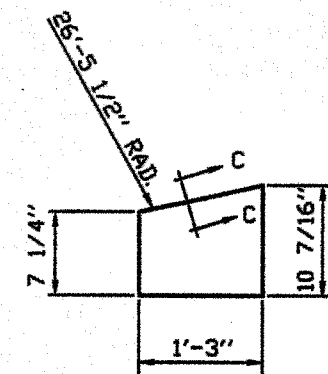


BASE FILLER PLATE


23-10-02

BEVEL ONE AS SHOWN

BEVEL ONE OPPOSITE HAND

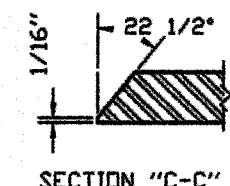

WORK THIS DRAWING
W/DWG. #22

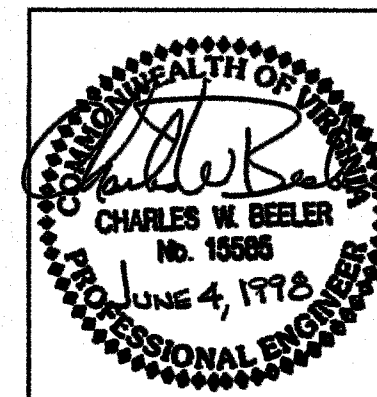

REV.	BY	DATE	REMARKS
Caldwell Tanks, Inc. Louisville, KY.			
BOTETOURT COUNTY, VA			
BY: BAW	DATE: 5-98	TITLE: ROLLING DOOR FRAMING	DRAWING NO: E-4291
			23