


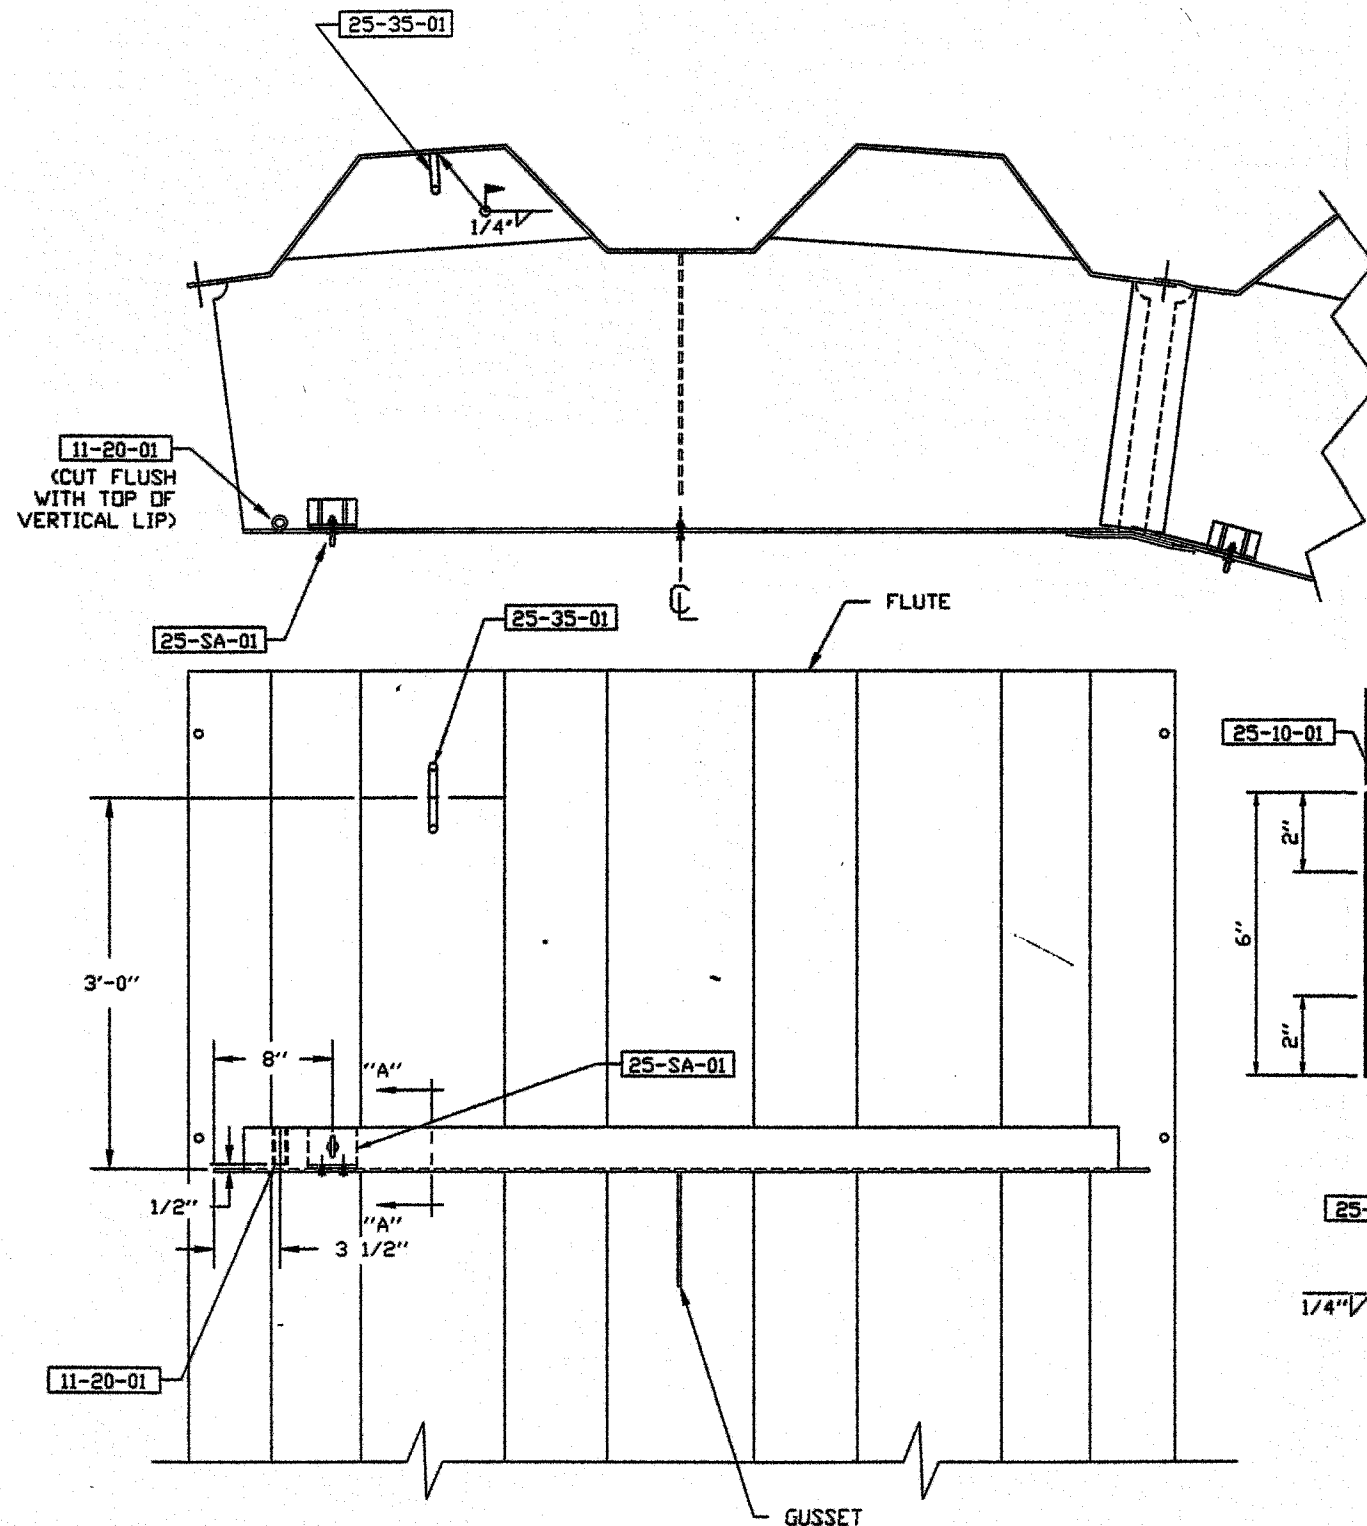


FLUTE AND GIRDER ASSEMBLY @ LEVEL 1
TYPICAL (24) PLACES

GENERAL NOTES:



- CONDENSATE CEILING TO BE 48'-0" DIA. FABRIC TYPE COMPLETE WITH
1. PERIMETER HEM WITH 1/4" DIA. POLY DRAW ROPE.
2. (1) 3" PVC CENTER DRAIN CONNECTION.
3. (2) PIPE SLEEVES FOR 24" O.D. PIPE.

CONDENSATE CEILING TO BE INSTALLED BY C.T.I. SUBCONTRACTOR
AS DIRECTED BY FABRIC CEILING MANUFACTURER.

BILL OF MATERIAL				
SUB-ASSY NO	PART NO	QTY	DESCRIPTION	MAT'L. REQ'D.
25-SA-01		24	CEILING ACCESSORIES	
	25-10-01	2	GUSSET SUPPORT	1/4" THK. PLATE
	25-10-02	1	BENT PLATE	6 1/2" x 1/4" PLATE x 6"
ITEMS LISTED BELOW ARE SHIPPED SEPERATELY				
	25-35-01	24	STD. COLUMN CLIPS	STOCK PART
	25-86-01	24	EYE BOLT & FLAT WASHER	3/4" DIA.
	25-90-01	154	LIN. FT. CABLE	GALVANIZED
	25-90-02	56	BEAM CLAMPS	FOR GIRDER
	25-90-03	60	CLEVIS	1/2" x 1" x 6 3/8" LG.

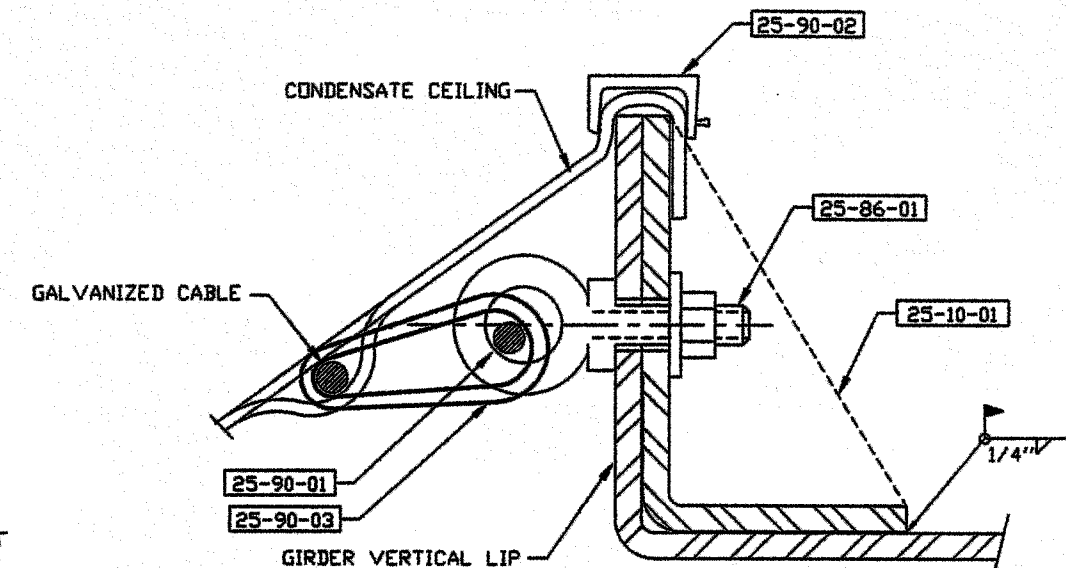

SECTION "A-A"

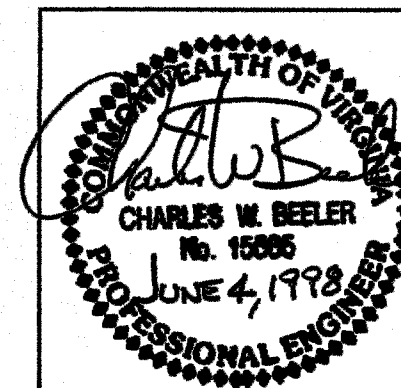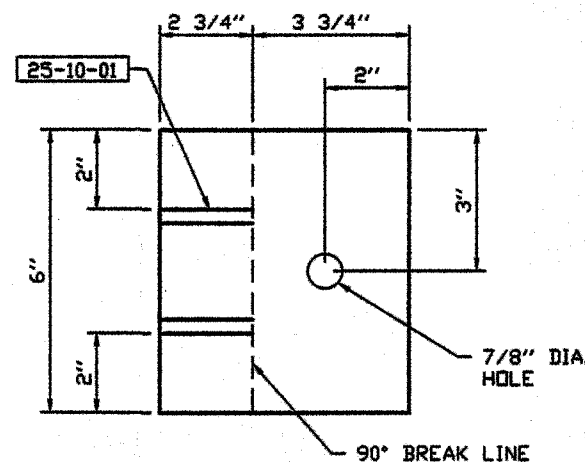

REV.	BY	DATE	REMARKS
CALDWELL TANKS, INC. LOUISVILLE, KY.			
BOTETOURT COUNTY, VA			
BY:	BAW/TB	TITLE:	CONDENSATE CEILING ASSY
DATE:	5-98	DRAWING NO:	E-4291
			25