

BILL OF MATERIAL					
SUB-ASSY NO	PART NO	QTY	DESCRIPTION	MAT'L. REQ'D.	PC. WT.
26-NP-01		1	NAMEPL. ASSY.	(SHIP W/ 17-DA-01)	
	26-90-01	1	NAMEPLATE	CAST ALUMINUM	
	26-30-01	2	MOUNTING ANGLE	1"x 1"x 1/8" ANGLE	
	26-86-01	4	DRIVE SCREW	#8 x 5/8"	

CALDWELL TANKS INC

LOUISVILLE , KENTUCKY

DATE: 1998

CAPACITY 1,000,000

BOTTOM HEIGHT 42

OVERFLOW HEIGHT 82

NO. E-4291

GALS.

FT. 0 IN.


FT. 0 IN.

26-90-01

NAMEPLATE ASSEMBLY

26-NP-01

SHOP INSTALL ABOVE
PEDESTRIAN DOOR- SEE DWG. 17

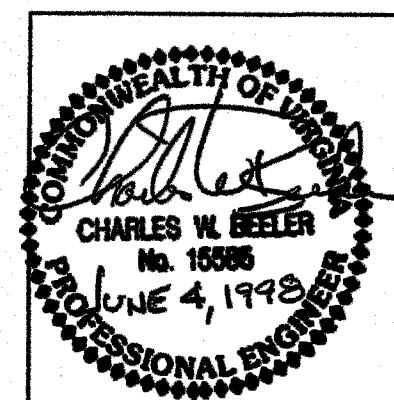

REV.	BY:	DATE	REMARKS
CALDWELL TANKS, INC.			
LOUISVILLE, KY.			
BOTETOURT COUNTY, VA			
BY:	BAW	TB	TITLE: NAMEPLATE
DATE:	5-98		DRAWING NO: E-4291 26