
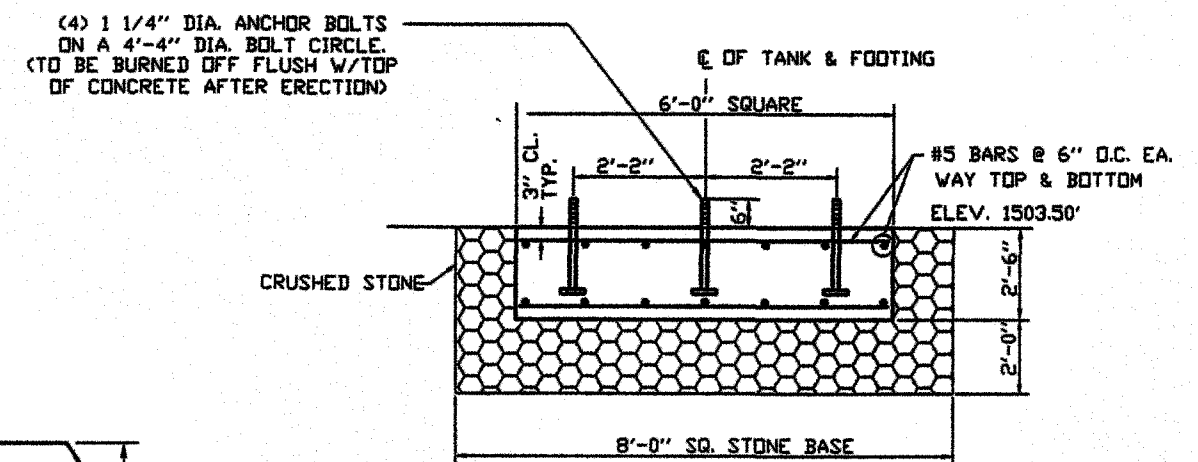
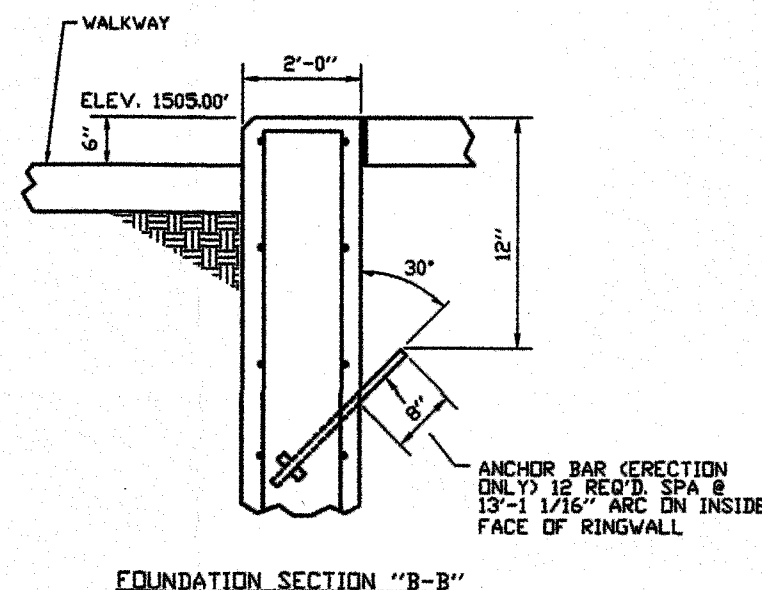
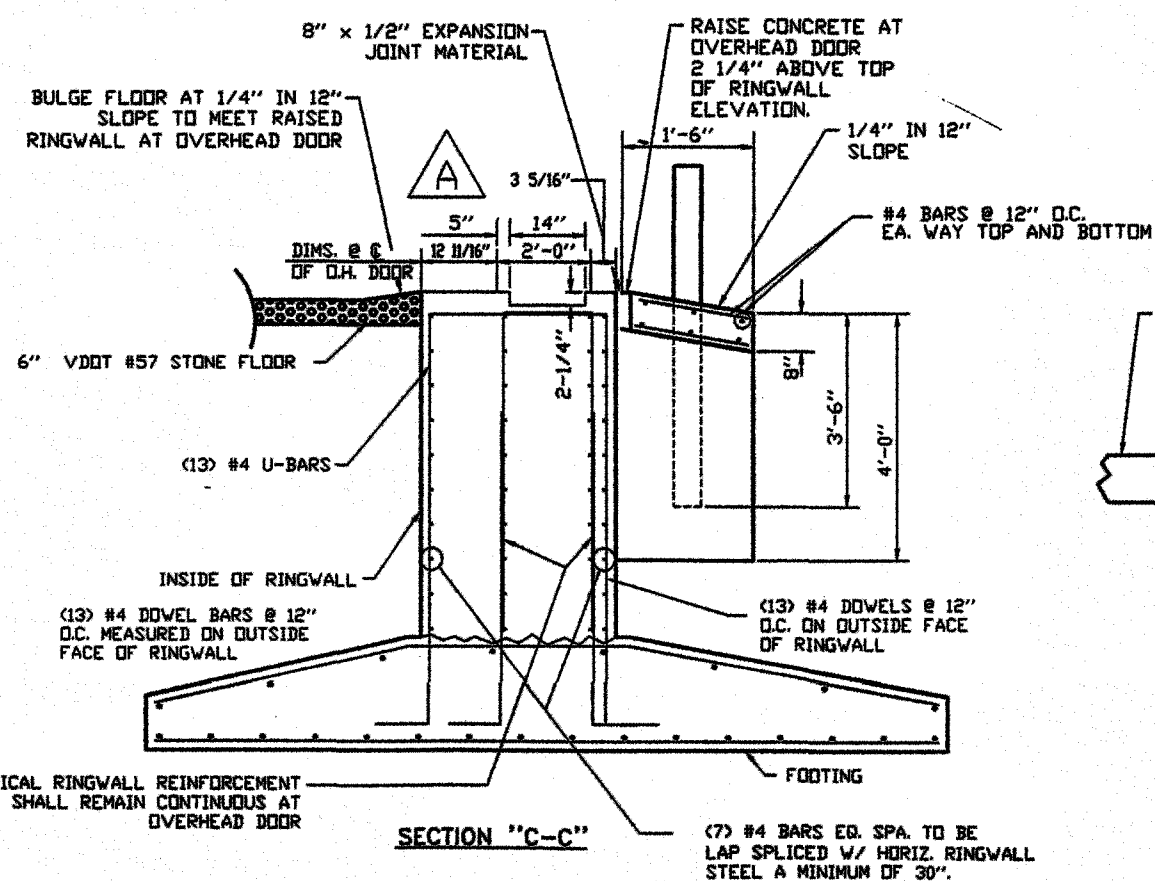
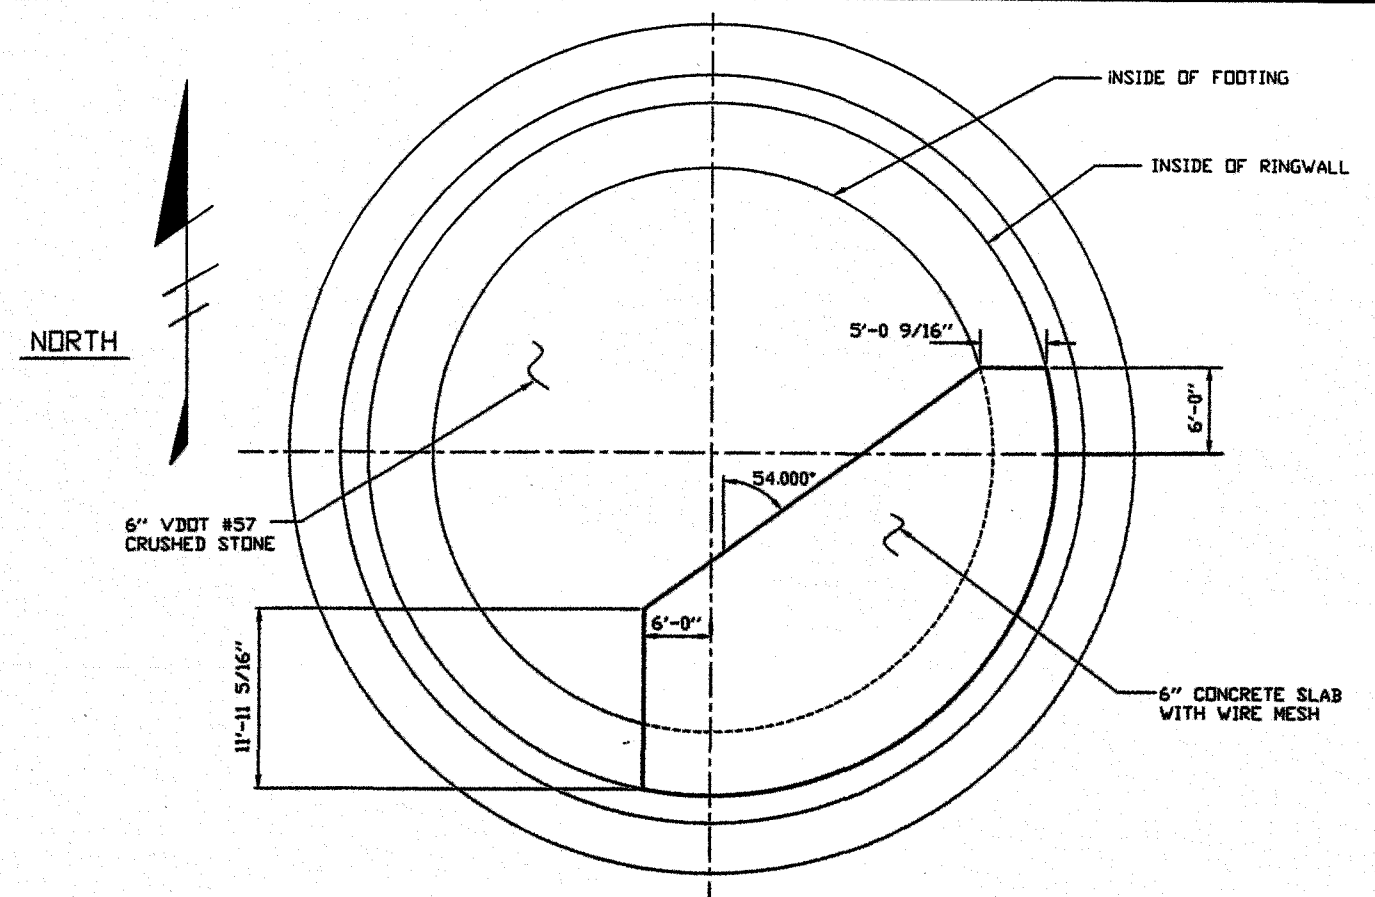


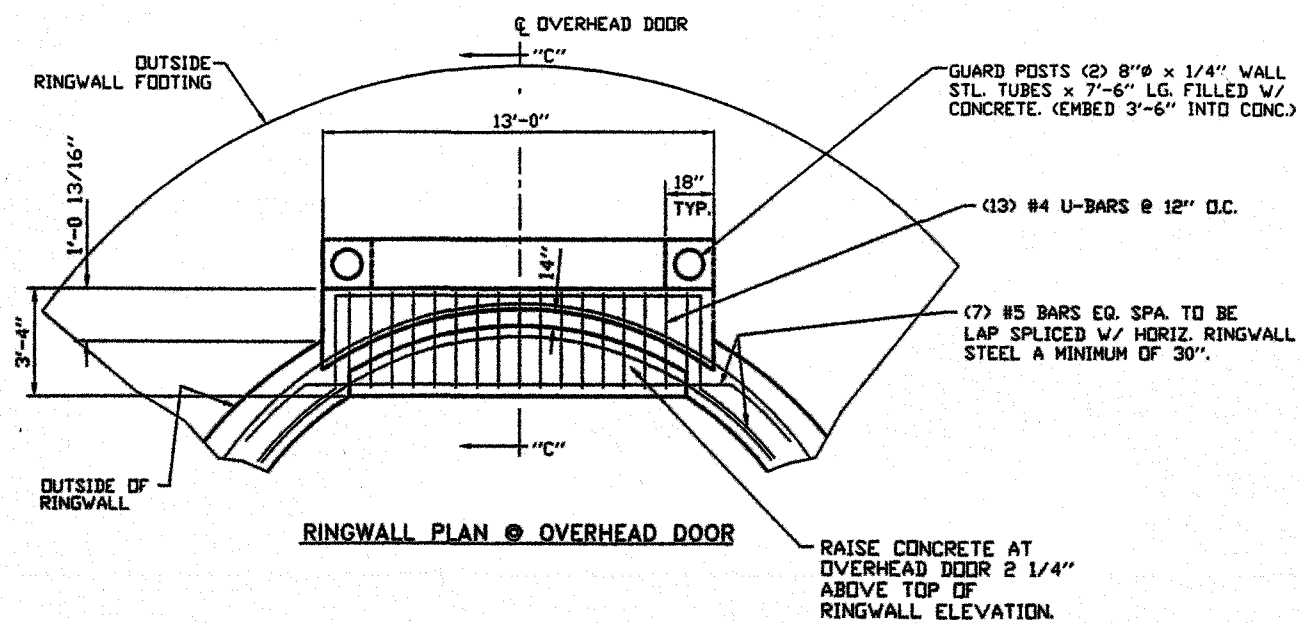

A	GAB	7-6	AS NOTED
REV.	BY:	DATE	REMARKS
CALDWELL TANKS, INC. LOUISVILLE, KY. 40219			
1,000,000 GALLON FLUTED COLUMN BOTETOURT COUNTY, VIRGINIA			
BY:	BAW		TITLE: MISCELLANEOUS DETAILS
DATE:	4-98		DRAWING NO. E-4291 F2 OF 4