




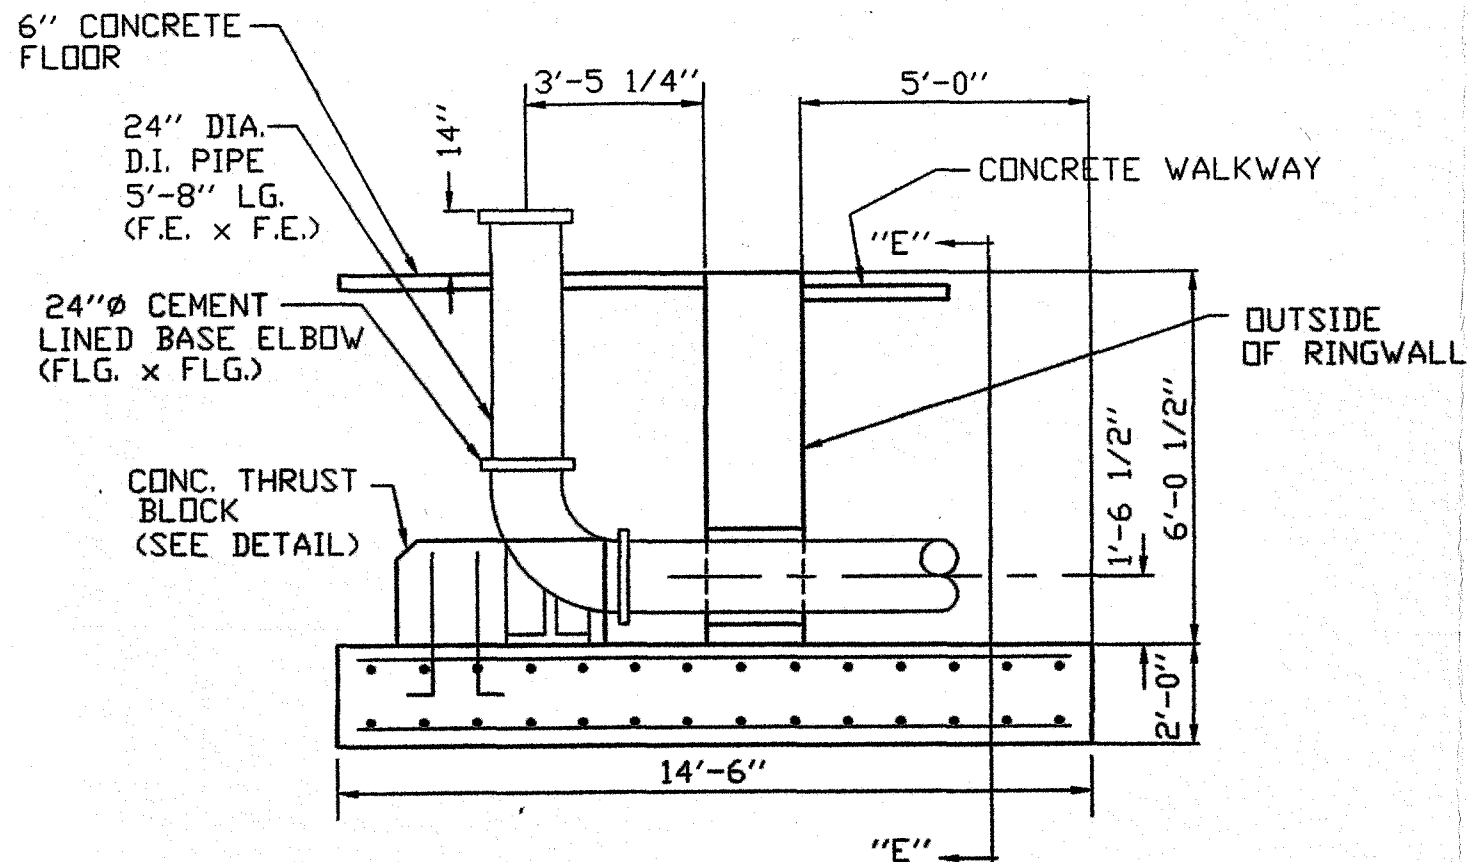


SECTION "D-D"
FOOTING NOT SHOWN FOR CLARITY

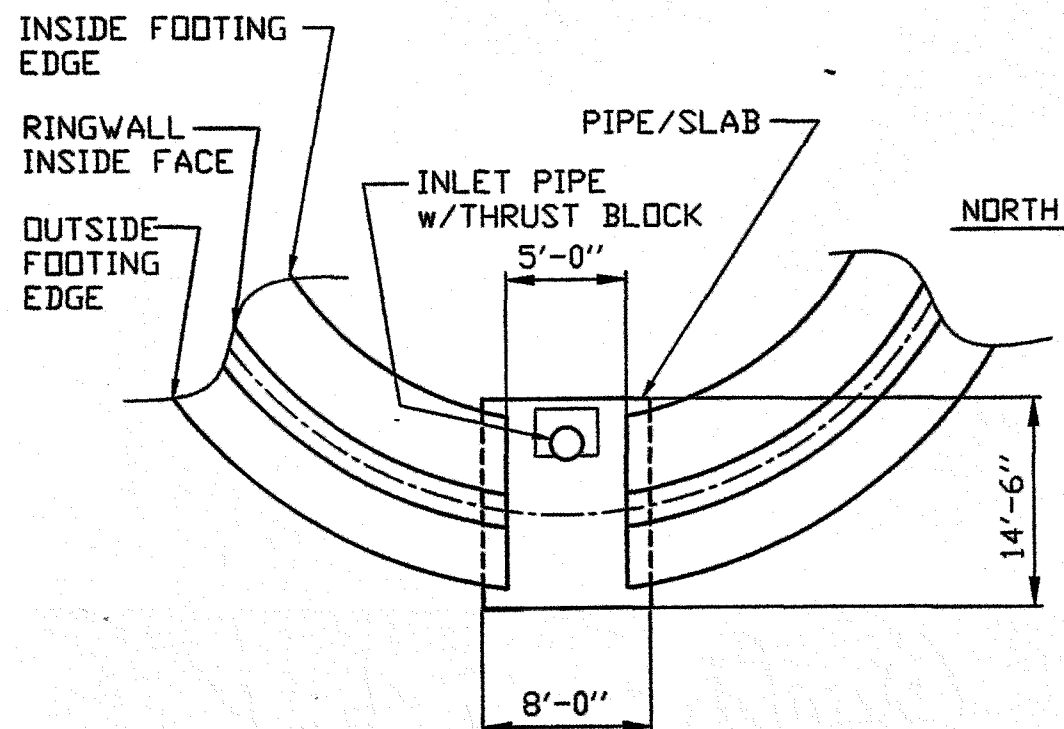


PIPE/SLAB PLAN VIEW

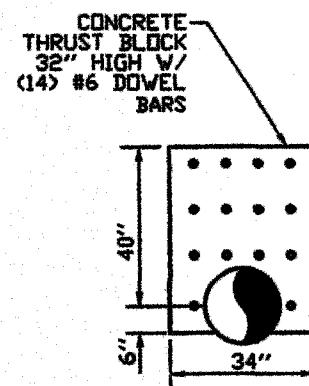

THRUST BLOCK DETAIL
24" DIA. BASE ELL

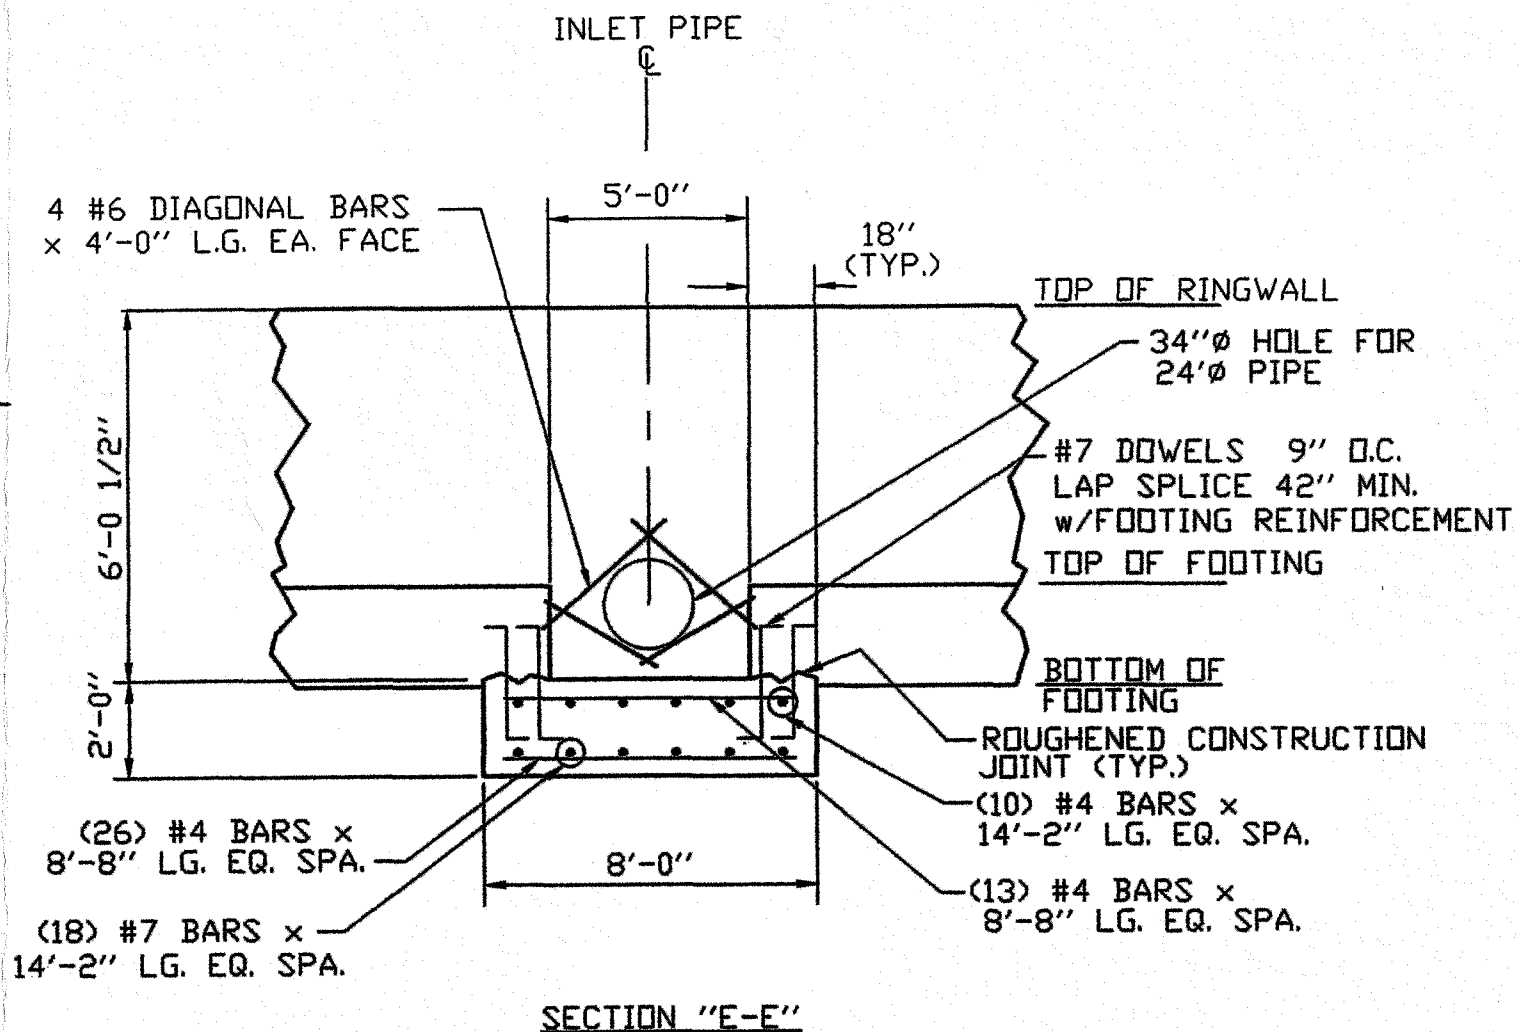

SECTION "E-E"

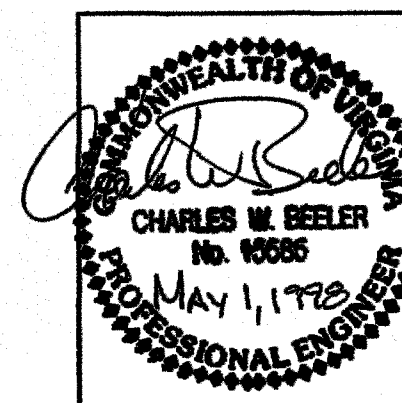

REV.	BY:	DATE	REMARKS
CALDWELL TANKS, INC LOUISVILLE, KY 40219			
1,000,000 GALLON FLUTED COLUMN BOTETOURT COUNTY, VIRGINIA			
BY:	BAW	TITLE:	MISCELLANEOUS DETAILS
DATE:	4-98	DRAWING NO.:	E-4291 F4 OF 4