


Notes:

1. DESIGN BASED ON GEOTECHNICAL REPORT, BY GEOTECHNICS, INC. COMMISSION NO. 5213, 24 JANUARY 2020.
2. REINFORCEMENT BARS SHALL BE DEFORMED, CARBON STEEL BARS IN ACCORDANCE WITH ASTM A615 GRADE 60.
3. CONCRETE SHALL MEET THE REQUIREMENTS OF THE PROJECT SPECIFICATIONS, INCLUDING MIN. COMP. STRENGTH OF 4,000 PSI AT 28 DAYS FOR NON-STRUCTURAL ELEMENTS AND 3,000 PSI AT 28 DAYS FOR NON-STRUCTURAL ELEMENTS.
4. ANCHOR RODS TO BE ASTM F1554 OR B7, MINIMUM 36 KSI.

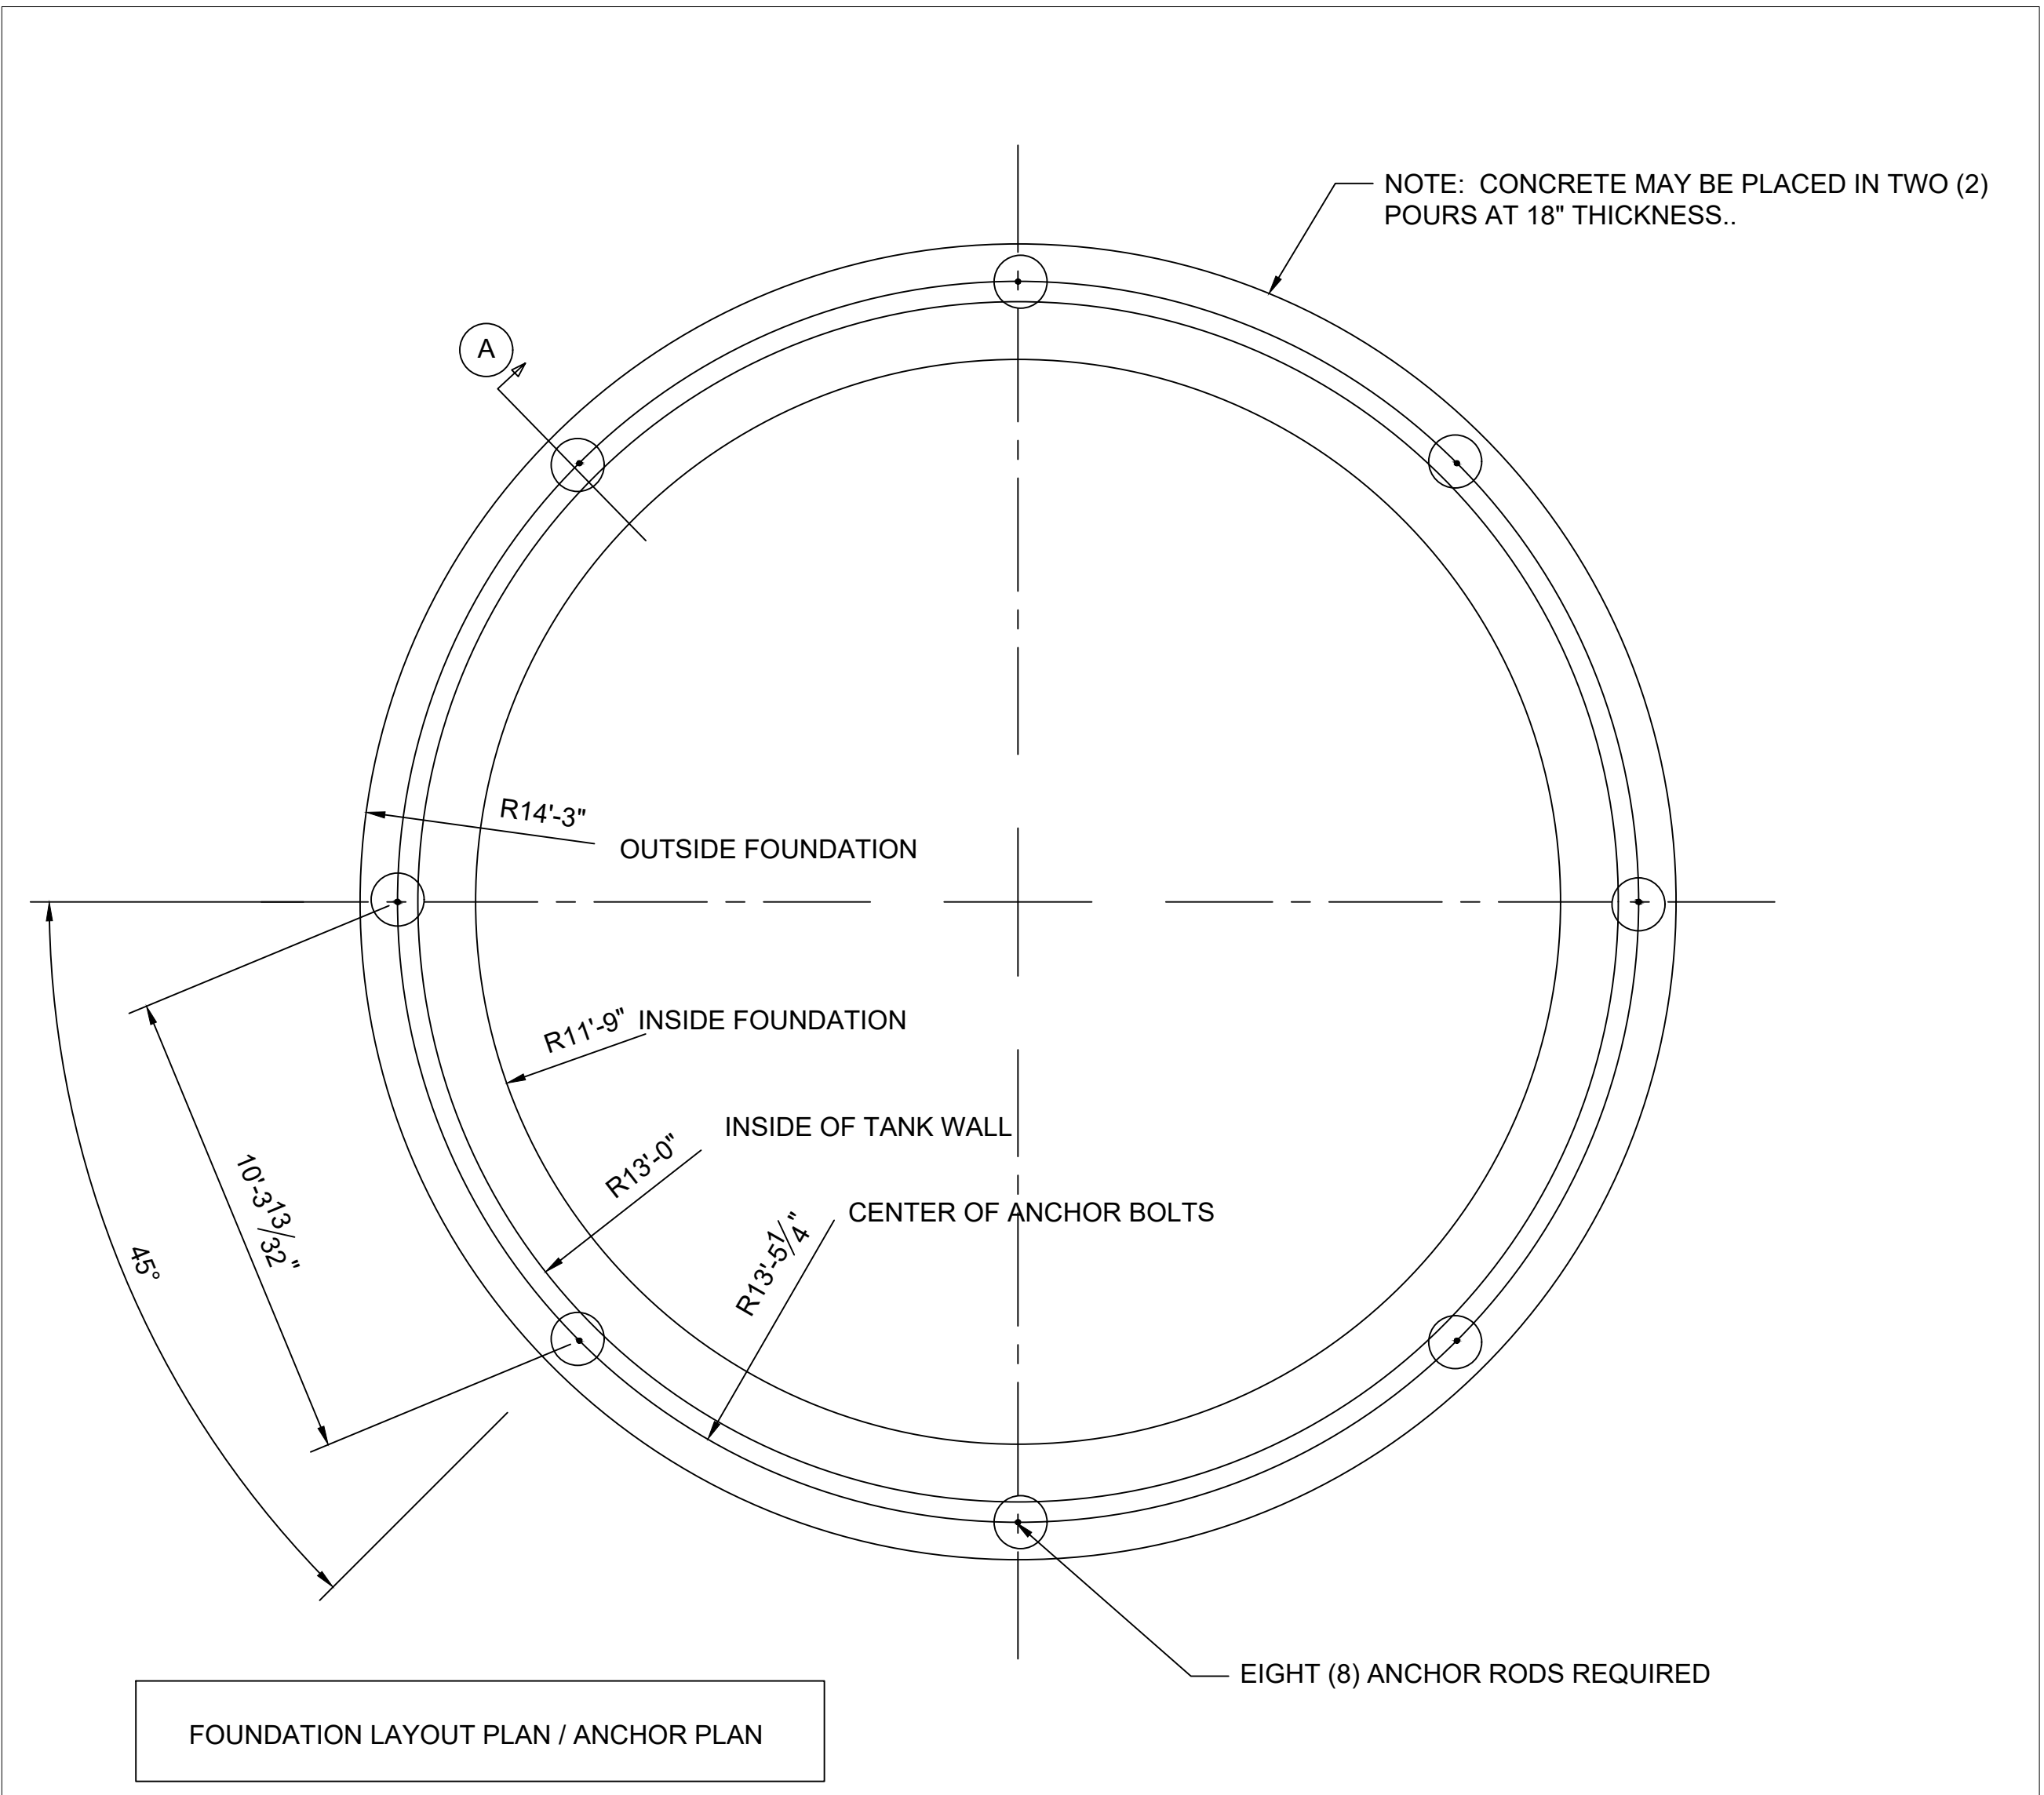

1	2 POUR DESIGNATION / FORMS	BA	11/16/20
REV:	DESCRIPTION:	BY:	DATE:
STATUS: RECORD DRAWINGS			

AYERS
Engineering, LLC
P.O. Box 923, Bluefield, VA 24605
www.AyersEngineering.com

TANK SUPPLIER:	EASTERN TANK 145 KRIT ROAD PRINCETON, WV 24739
CONTRACTOR:	

SITE: MASONS CREST TANK ROANOKE COUNTY, VA			
TITLE: FOUNDATION			
SCALE: AT 1: NTS	DATE: 04/30/21	DRAWN: BA	CHECKED: BA
PROJECT NO: 20059	DRAWING NO: F1	REVISION: 2	