



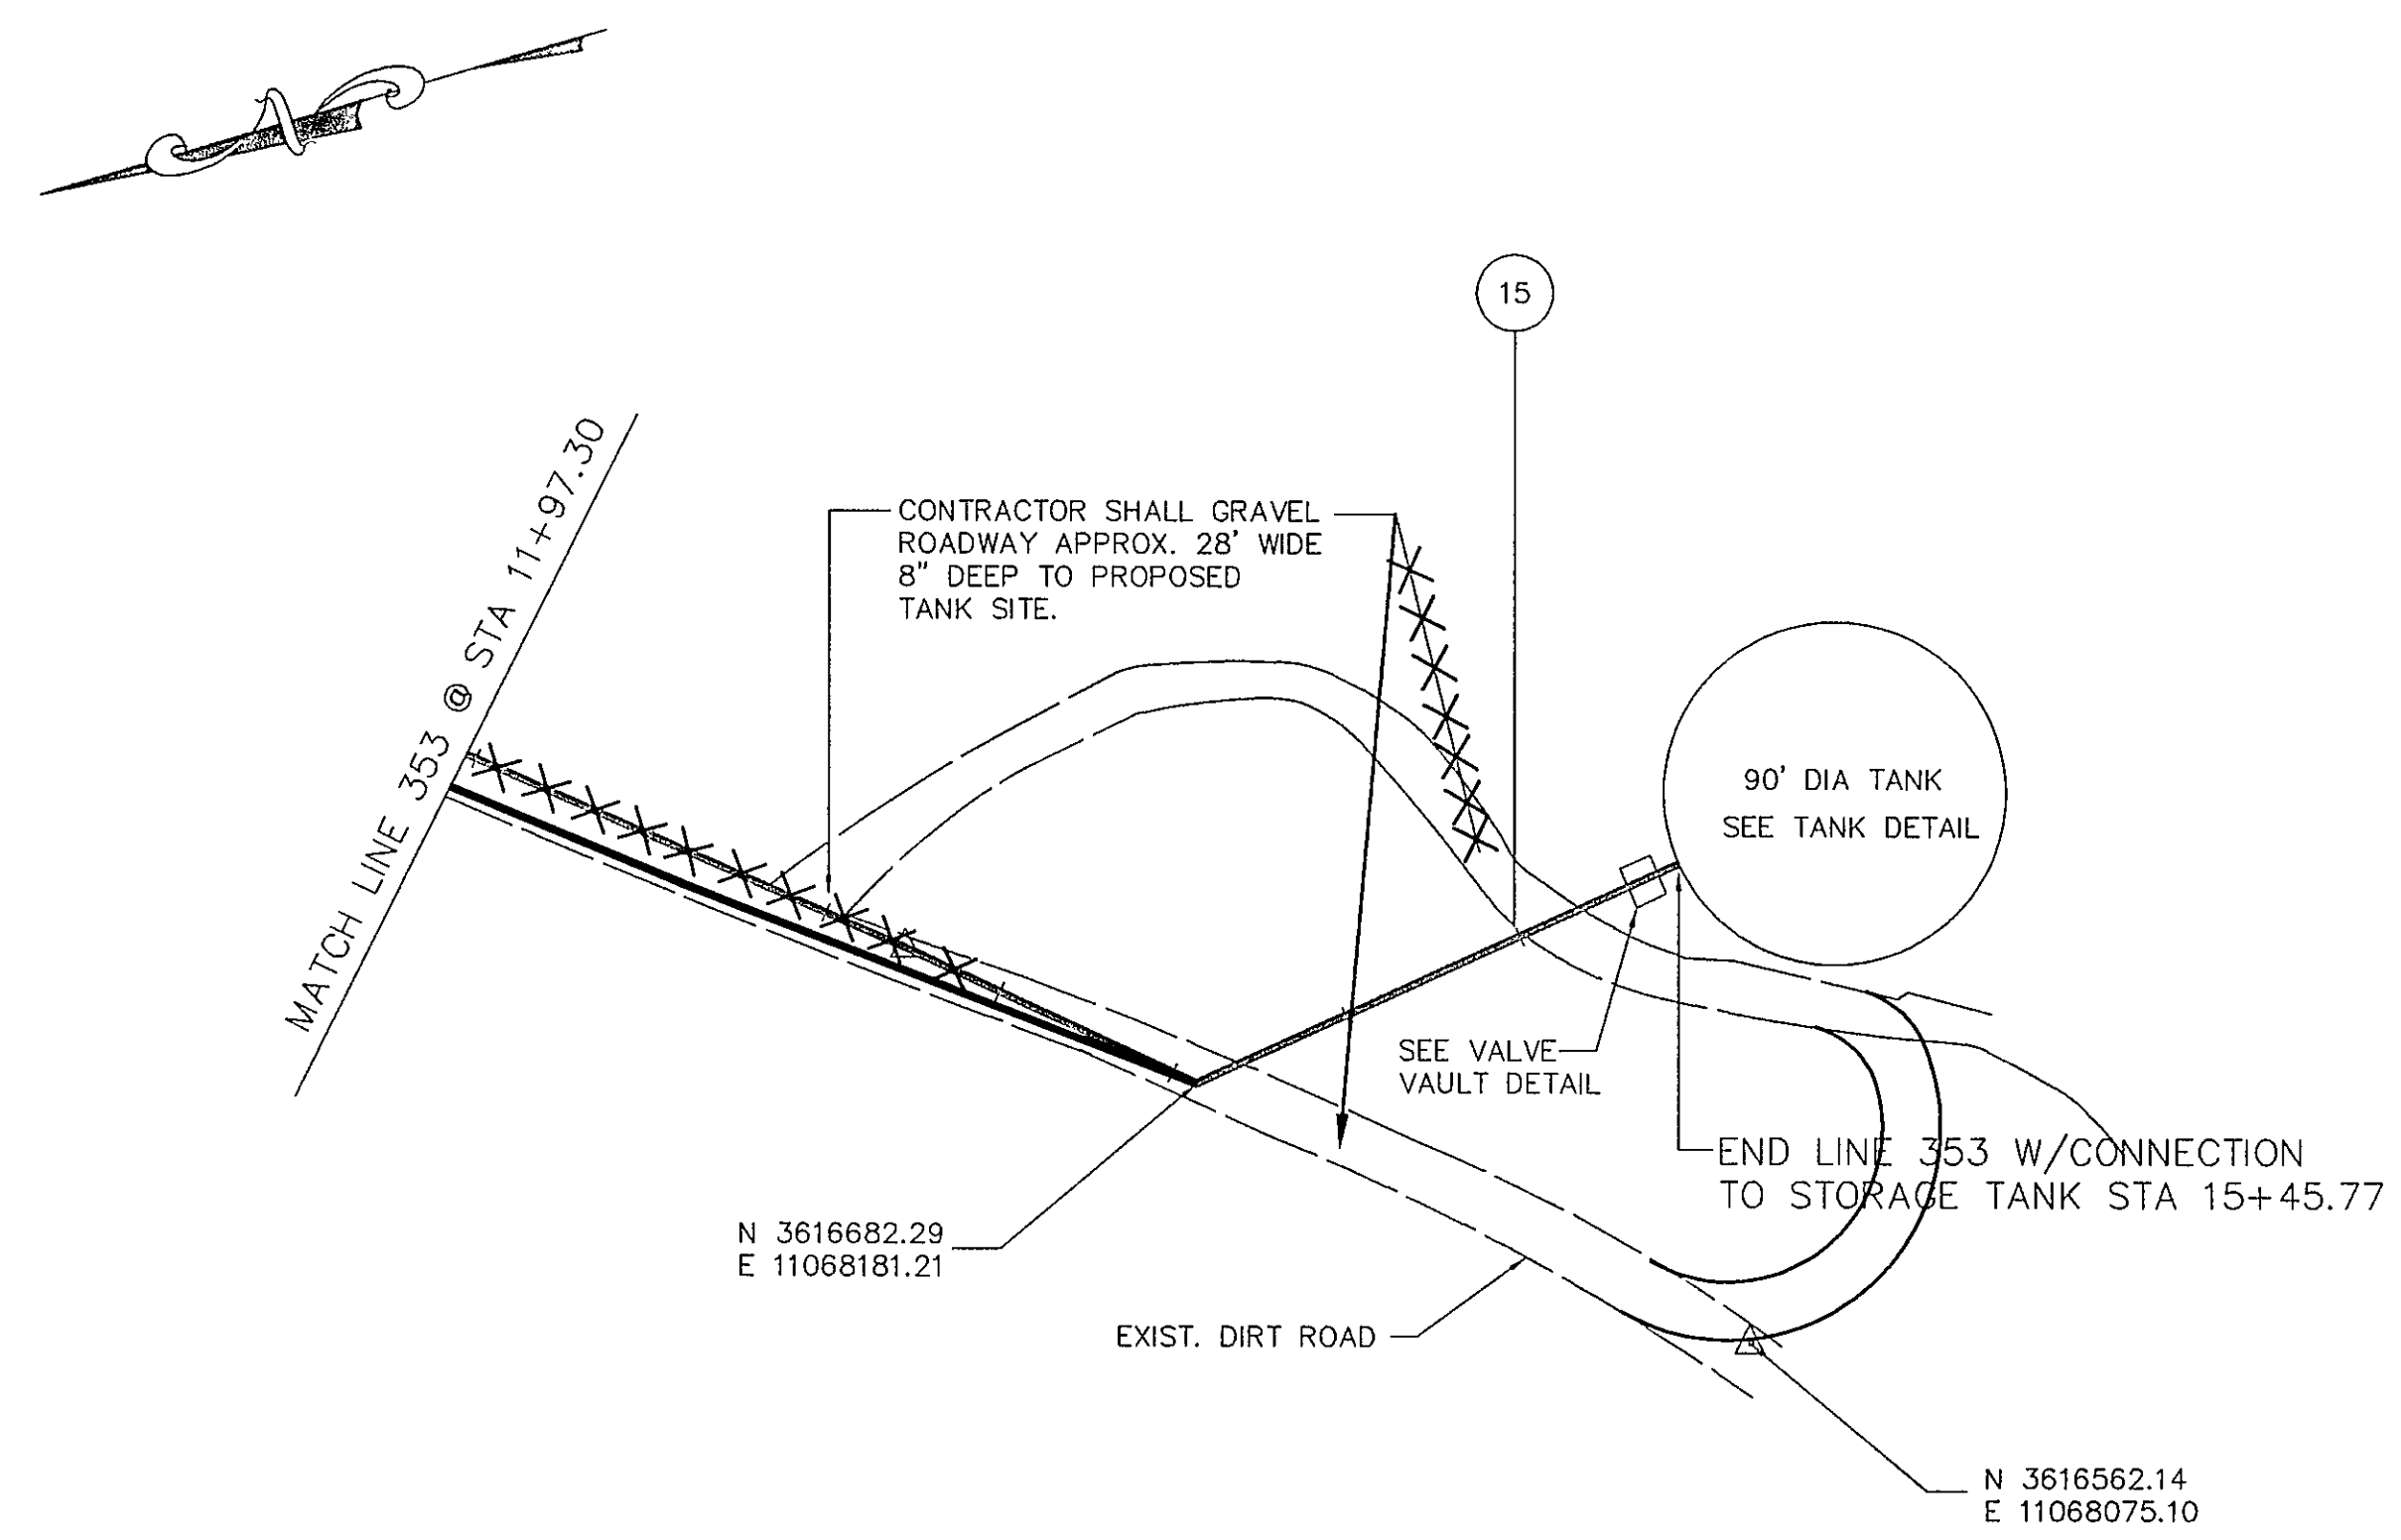

PLAN VIEW LINE 353

- THIS SHEET
- 328 LF 24" WATERMAIN
 - 2 EA. 16" BUTTERFLY VALVE
 - 1 EA. 16" ALTITUDE VALVE
 - 3 EA. 12" GATE VALVE
 - 2 EA. 8" GATE VALVE
 - 1 EA. 8" CHECK VALVE

ENGINEER'S SEAL	ENGINEER'S SEAL

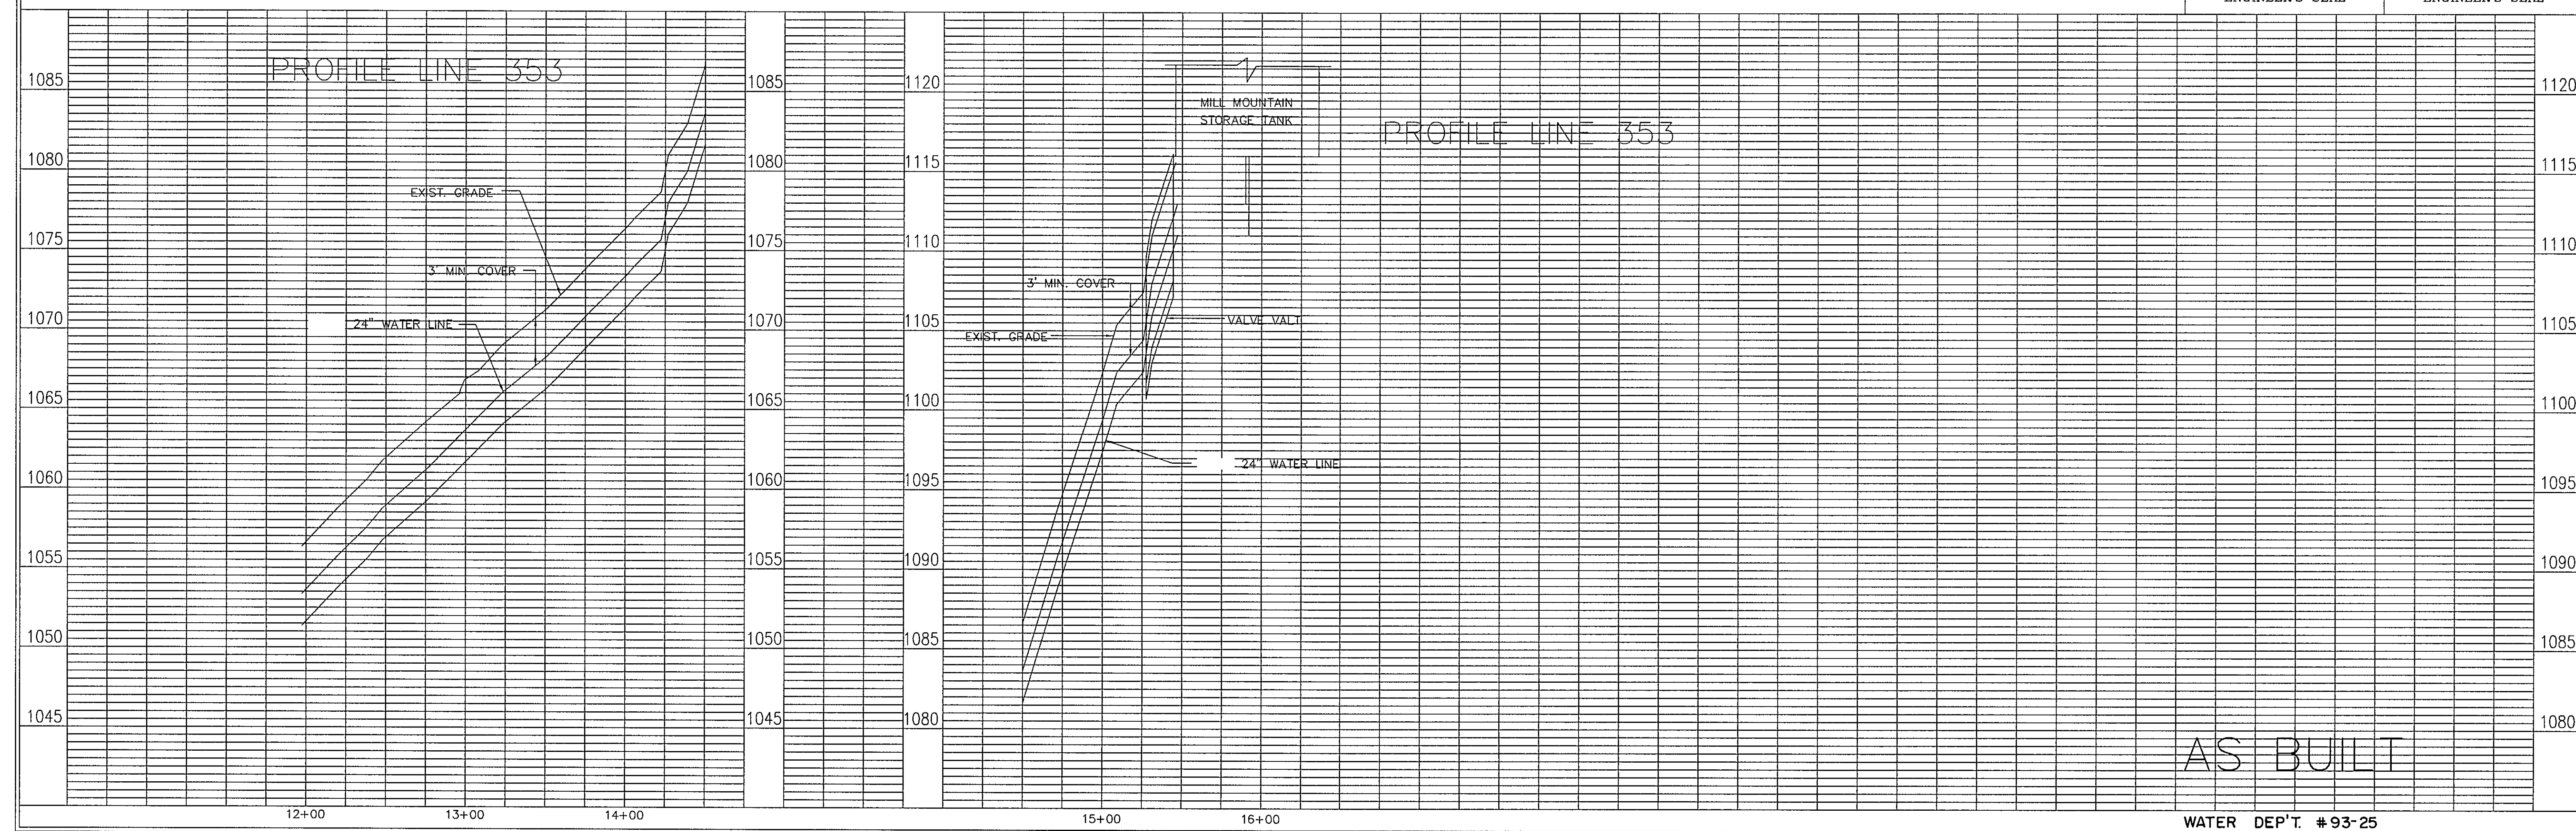

AS BUILT

 Architects Engineers Planners Surveyors 5238 Valleypointe Parkway, Suite One-B Roanoke, Virginia 24019 703 362-7725	Carvins Cove, Phase II City of Roanoke Roanoke, Virginia	END CONTRACT "C2" LINE 353 MILL MOUNTAIN TANK STA 11+97.30 - 15+45.77	Drawn By REH/ACF Designed By RBS Checked By SEH Date MARCH 93 Scale V: 1" = 5' H: 1" = 50' Plan Number MMTS2 Zoned NONE Sheet 18 of 25 File Number C1160