


PROJECT LOCATION MAP

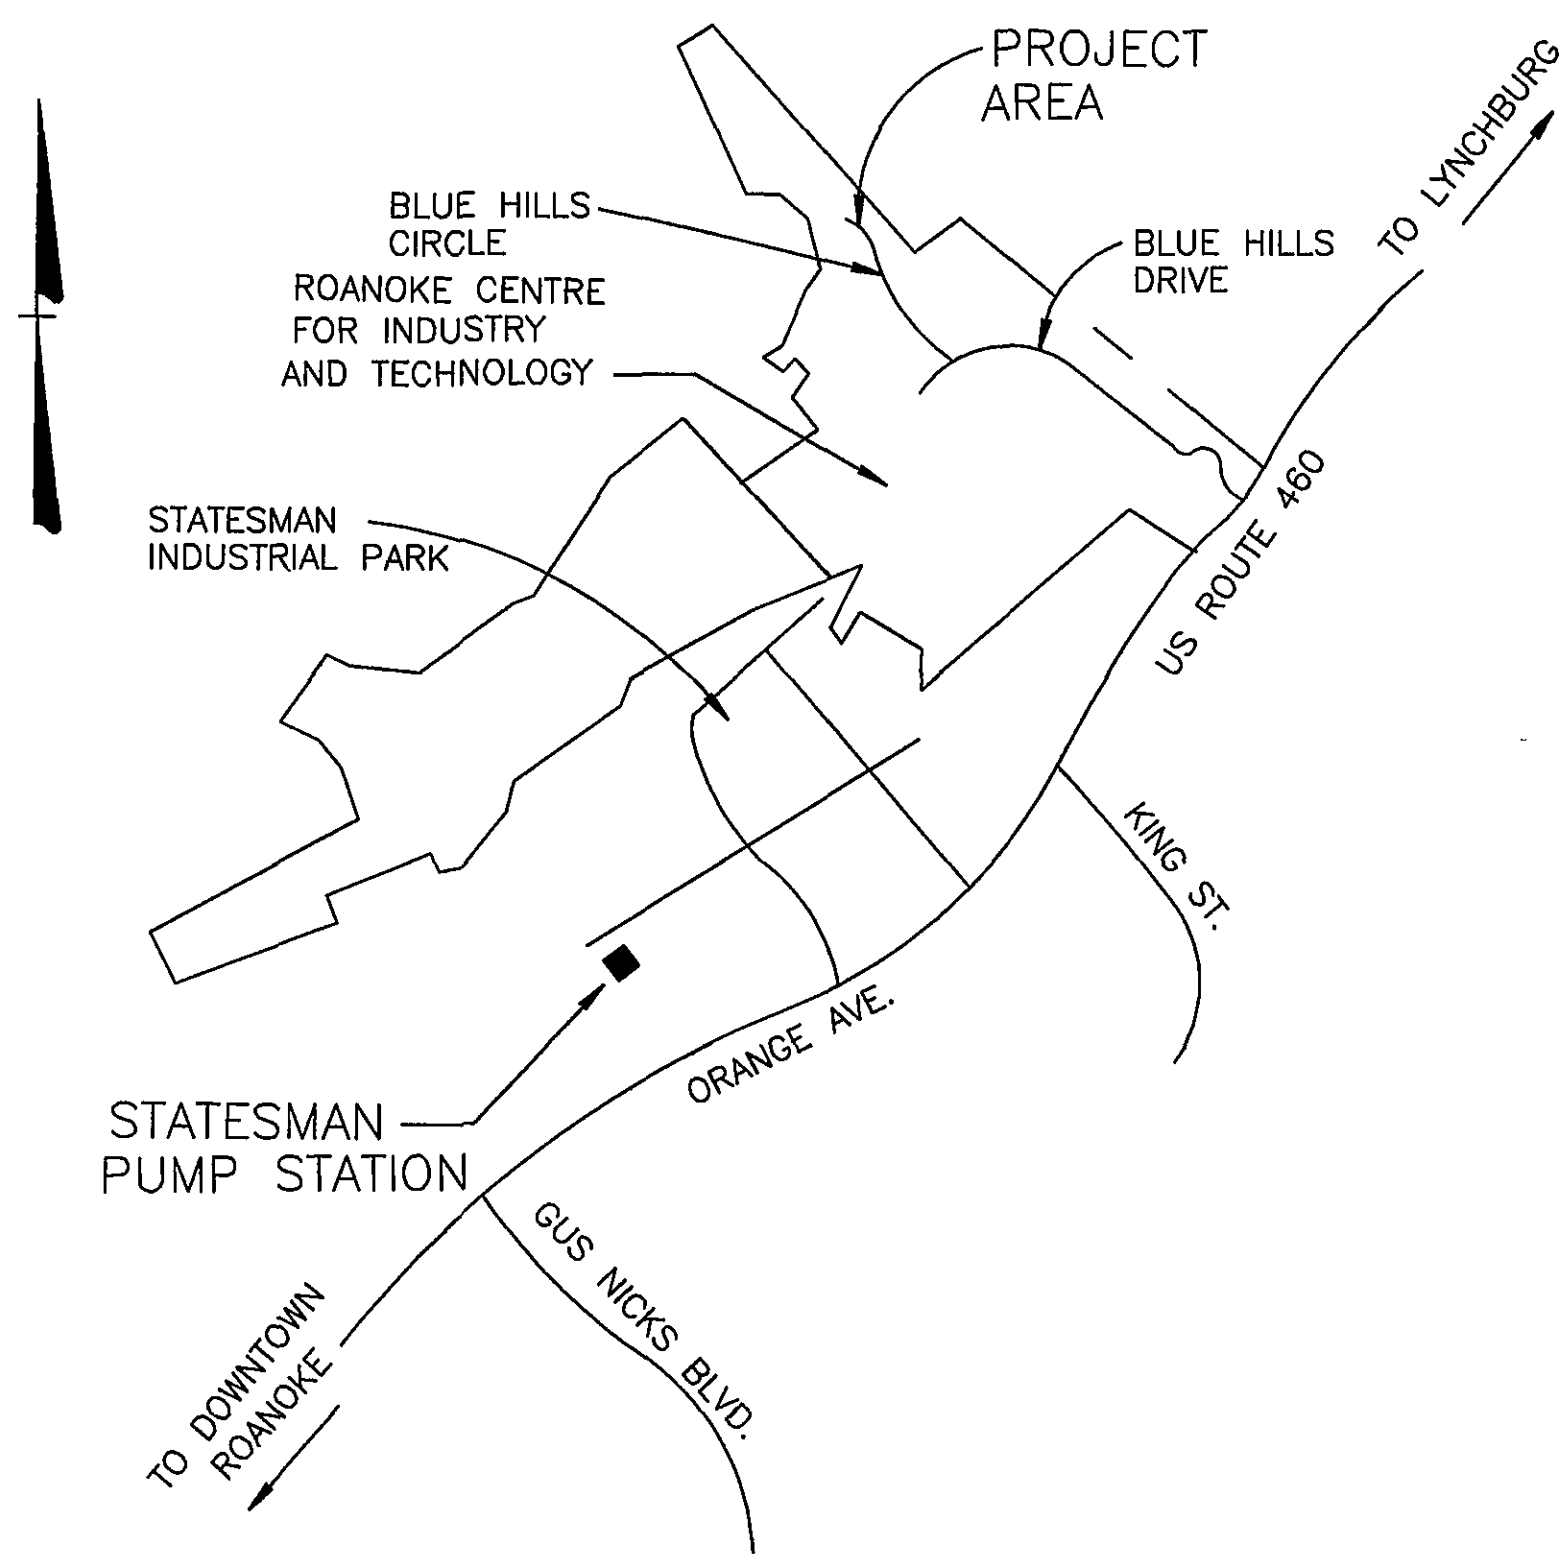

OFFICE OF CITY ENGINEER
ROOM 350
MUNICIPAL BUILDING
215 CHURCH AVENUE, S.W.
ROANOKE, VIRGINIA 24011

INDEX OF SHEETS

- 1 TITLE
- 2 SUMMARY OF QUANTITIES
- 3 GENERAL ABBREVIATIONS & LEGEND
- 4 TANK SITE
- 5 TANK DETAILS - MULTI-COLUMN BRACED TANK
- 6 TANK DETAILS - SPHEROID TANK (NOT USED)
- 7 ELECTRICAL & MISC. DETAILS

CONSULTING ENGINEERS



Mattern & Craig


CONSULTING ENGINEERS

SURVEYORS

701 FIRST STREET

ROANOKE, VIRGINIA

COMMISSION NUMBER: 1165G

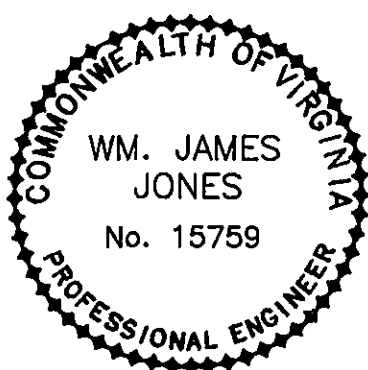

PROJECT NAME

ROANOKE CENTRE FOR INDUSTRY
AND TECHNOLOGY
WATER STORAGE TANK - CONTRACT I
CITY OF ROANOKE, VIRGINIA

PROJECT NUMBER: 6260

REVISION BY	DESCRIPTION:	DATE
REVISION BY	DESCRIPTION:	DATE
REVISION BY	DESCRIPTION:	DATE
REVISION BY	DESCRIPTION:	DATE

APPROVED FOR CONSTRUCTION

ROANOKE CITY ENGINEER

DATE

DIRECTOR OF PUBLIC WORKS

DATE

DIRECTOR OF PUBLIC UTILITIES AND OPERATIONS

DATE

DATE

DATE

ADVERTISED DATE:

SET NUMBER:

SHEET NUMBER: 1 OF 7

RECORD DRAWING