


SHEET INDEX

SHEET NO.	TITLE
1.	COVER
2.	ABBREVIATIONS, LEGEND AND GENERAL NOTES
3.	INDEX MAP
4.	PLAN AND PROFILE
5.	STA 0+00 TO STA 9+00 @ A
6.	PLAN AND PROFILE
7.	STA 9+00 @ A TO STA 5+00 @ B
8.	PLAN AND PROFILE
9.	STA 14+00 TO STA 23+00 @ A
10.	PLAN AND PROFILE
11.	STA 23+00 TO STA 31+00 @ A
12.	PLAN AND PROFILE
13.	STA 0+20 TO STA 8+00 @ J
14.	PLAN AND PROFILE
15.	STA 2+50 TO STA 10+50 @ F
16.	PLAN AND PROFILE
17.	STA 10+50 TO STA 19+50 @ F
18.	PLAN AND PROFILE
19.	STA 19+50 TO STA 28+17.89 @ F
20.	PLAN AND PROFILE
21.	STA 31+00 TO STA 40+00 @ A
22.	PLAN AND PROFILE
23.	STA 40+00 TO STA 48+50 @ A
24.	PLAN AND PROFILE
25.	STA 48+50 TO STA 57+00 @ A
26.	PLAN AND PROFILE
27.	STA 57+00 TO STA 66+00 @ A
28.	PLAN AND PROFILE
29.	STA 66+00 TO STA 72+00 @ A
30.	PLAN AND PROFILE
31.	STA 72+00 @ A TO STA 5+35 @ H
32.	PLAN AND PROFILE
33.	STA 5+00 TO STA 14+00 @ B
34.	PLAN AND PROFILE
35.	STA 1+00 TO STA 13+50 @ C
36.	PLAN AND PROFILE
37.	STA 1+00 TO STA 7+00 @ D
38.	PLAN AND PROFILE
39.	STA 14+00 TO STA 21+06 @ B
40.	PLAN AND PROFILE
41.	STA 1+00 TO STA 10+90 @ G
42.	PLAN AND PROFILE
43.	STA 9+75 TO STA 10+75 @ D
44.	PLAN AND PROFILE
45.	STA 10+75 TO STA 27+00 @ D
46.	PLAN AND PROFILE
47.	STA 27+00 TO STA 34+50 @ D
48.	PLAN AND PROFILE
49.	STA 1+50 TO STA 9+00 @ E
50.	PLAN AND PROFILE
51.	STA 8+00 TO STA 13+74 @ E
52.	PLAN AND PROFILE
53.	STA 1+00 TO STA 3+00 @ K
54.	PLAN AND PROFILE
55.	STA 0+30 TO STA 4+55 @ I
56.	PLAN AND PROFILE
57.	STA 1+50 TO STA 3+00 @ L
58.	PLAN AND PROFILE
59.	(CONNECTION TO EXIST WATER SYSTEM)
60.	WATER TANK - SITE PLAN
61.	PLAN AND PROFILE
62.	STA 2+00 TO STA 11+38 @ M
63.	PLAN AND PROFILE
64.	STA 1+00 TO 6+00 @ P
65.	PLAN AND PROFILE
66.	STA 1+00 TO 1+95 @ N
67.	WATER TANK DETAILS
68.	WATER PUMPING STATION
69.	PLAN AND PROFILE
70.	STA 10+80 TO STA 14+28 @ Z
71.	PLAN AND PROFILE
72.	WATER LINE TO TANK
73.	PLAN AND PROFILE
74.	STA 11+50 TO 17+19 @ A-A

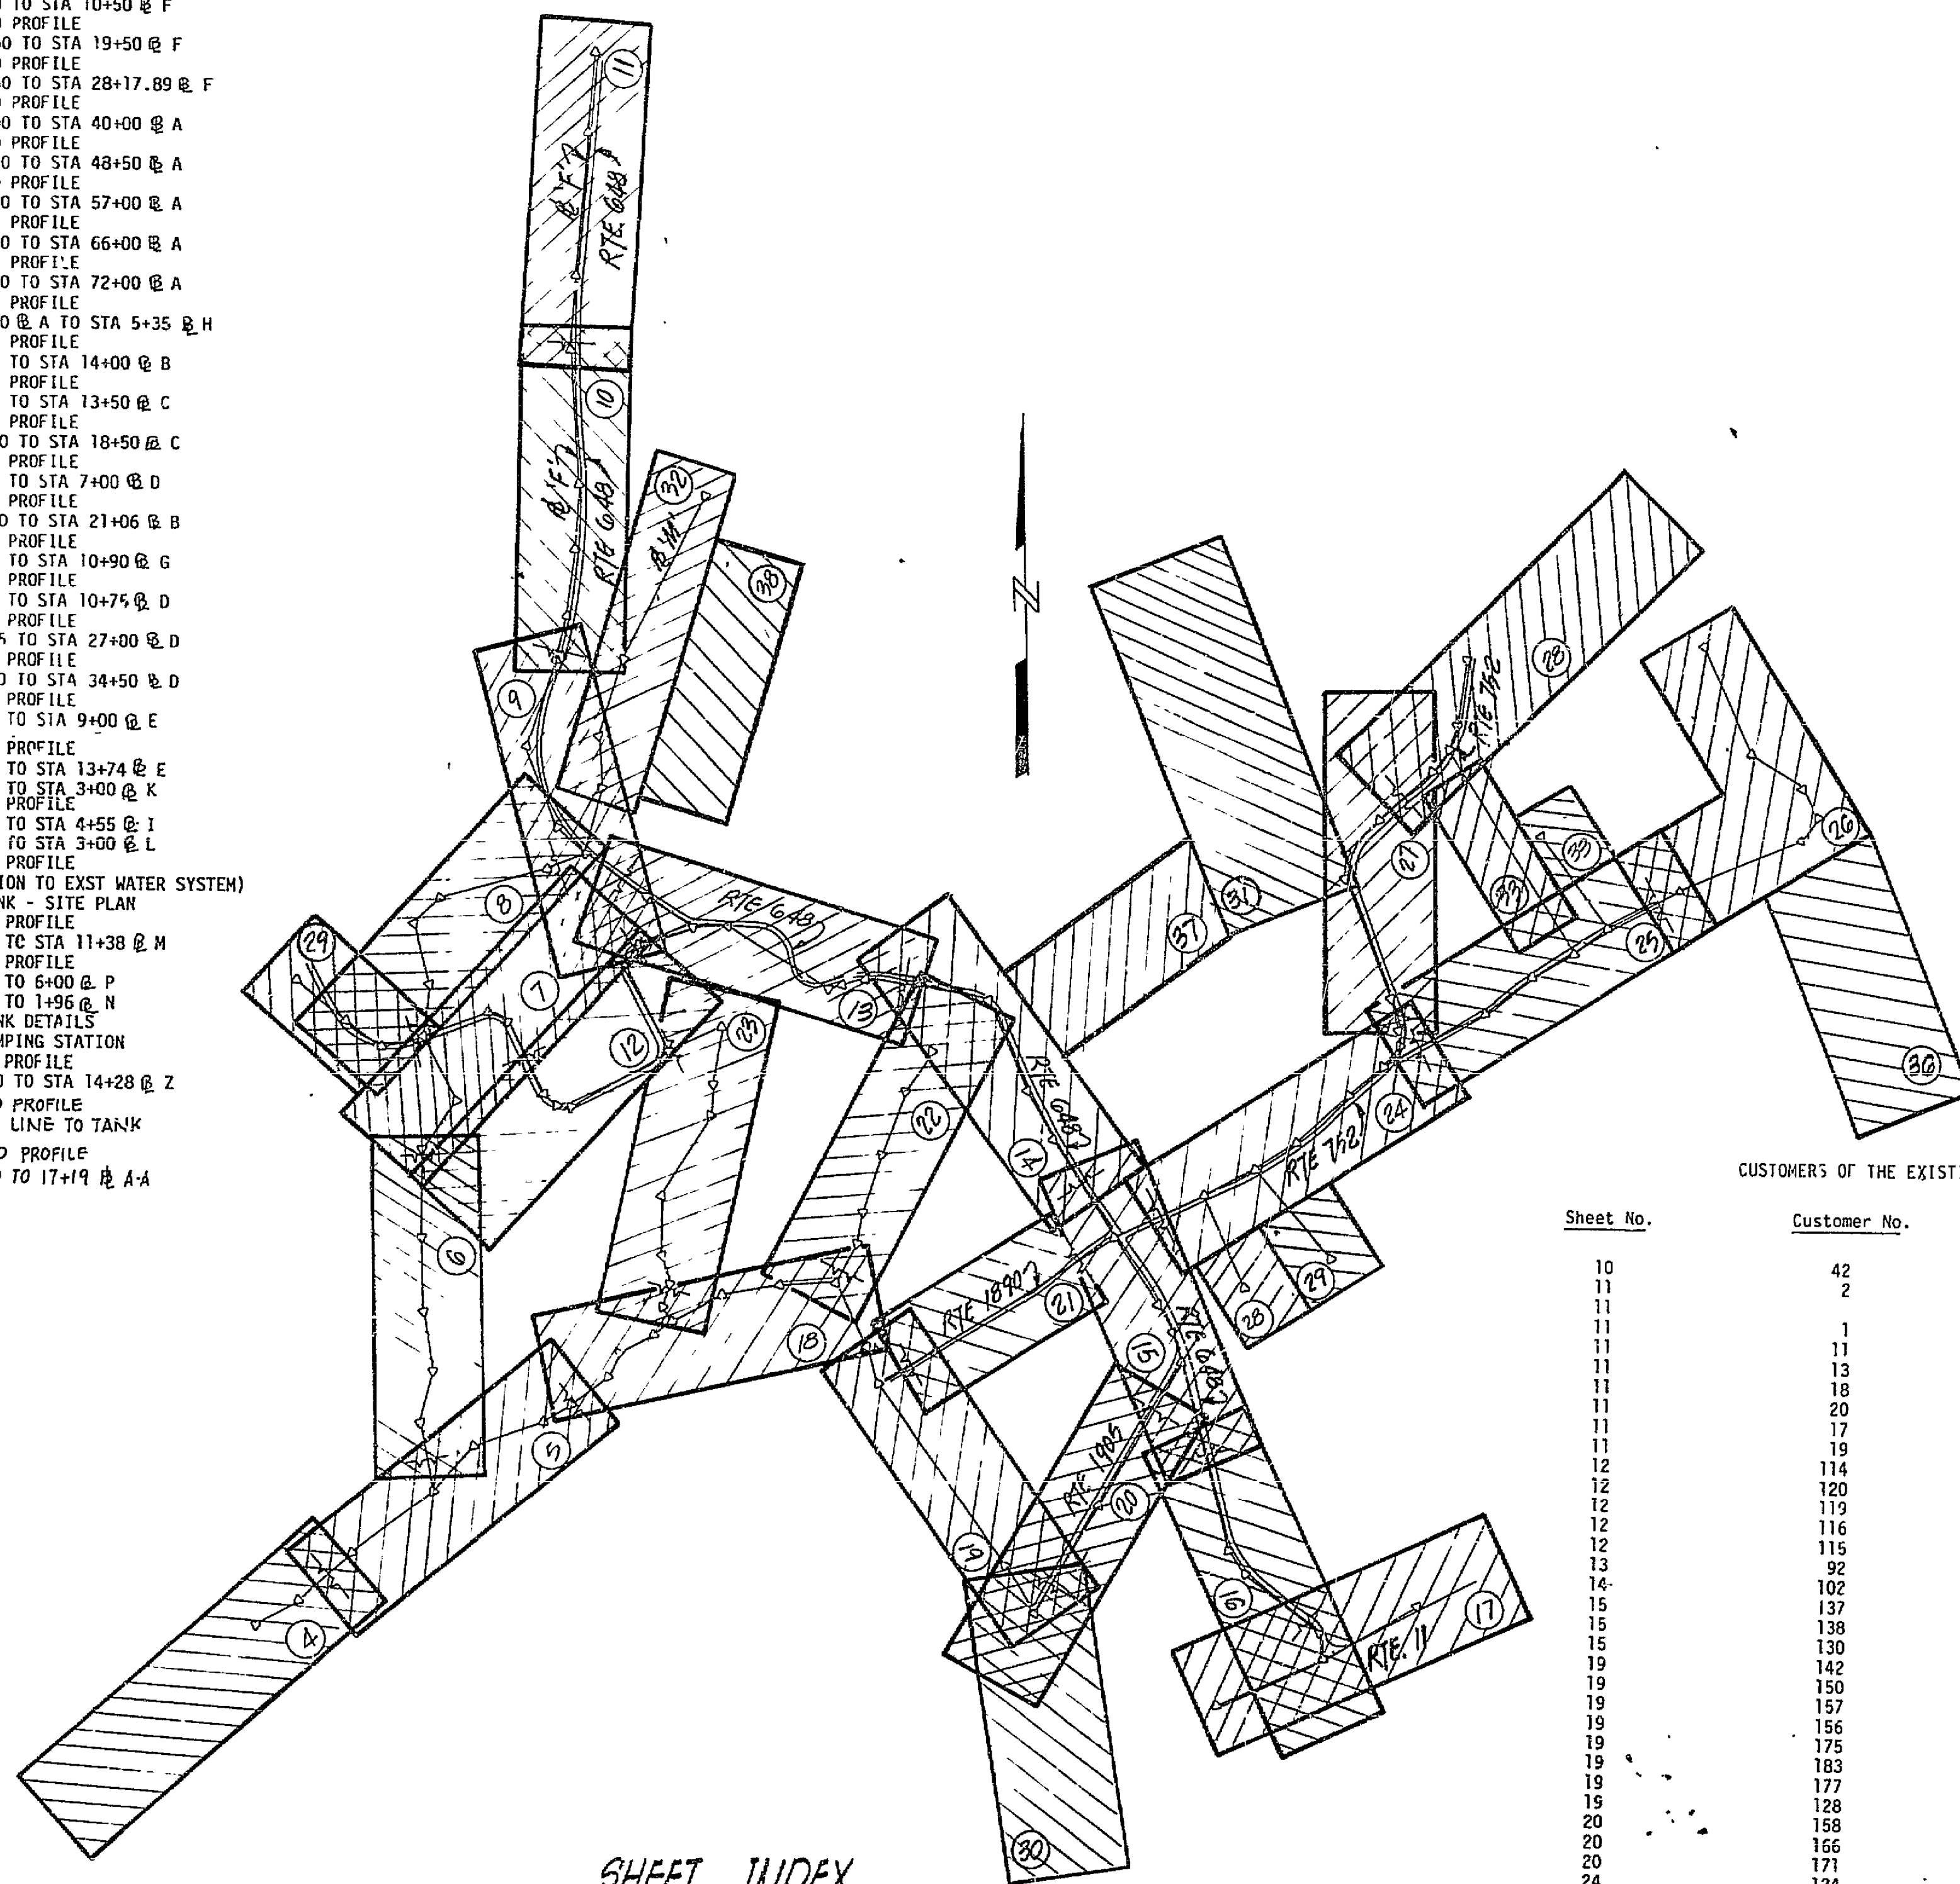

SHEET INDEX NO SCALE

NOTES: 1. WATER SERVICE TO THE EXISTING WATER CUSTOMERS SHALL NOT BE INTERRUPTED. THIS LIST REPRESENTS THE BEST INFORMATION AVAILABLE REGARDING THE CUSTOMERS SERVED BY THE EXST. WATER SYSTEM. HOWEVER, THIS SHALL NOT BE CONSIDERED TO BE A COMPLETE LIST OF ALL CUSTOMERS. ALL CUSTOMERS OF THE EXST. WATER SYSTEM SHALL BE CONNECTED TO THE NEW WATER SYSTEM.

CUSTOMERS OF THE EXISTING WATER SYSTEM (SEE NOTE 1)

Sheet No.	Customer No.	Name of Customer
10	42	James E. & Stella M. Carpenter
11	2	Mason Haynesworth et als
11	1	James Robinson
11	11	Richard Chubb
11	13	Edward Stafford
11	18	William & Sybil Johnson
11	20	Isiah & Virginia Sweetenberg
11	17	Lenora Morton
11	19	James Robertson, Jr.
12	114	Doris Crowder (FHA)
12	120	Edward & Francis Mitchell
12	119	James H. Johnson
12	116	James & Core Lewis
12	115	Harry & Mary Smith
13	92	First Baptist Church of Hollins
14	102	Larry Stuart
15	137	Wendell Bruce
15	138	Willie Hunt
15	130	Monroe & Shirley Johnson
19	142	George & Celestine Bruce
19	150	Lorine Harris
19	157	Charles & Viola Johnson
19	156	George & Mattie Johnson
19	175	Edward & Francis Mitchell
19	183	Alice Garrison
19	177	Paul Garrison heirs
19	128	William & Carrie Gaither Heirs
20	158	George Garrison
20	156	Fred & Maggie Anderson
20	171	William & Maggie Hunt Heirs
24	124	Emma Bruce
24	125	Archie Bruce
24	111	Brion & Rene Croan
24	95	Elizabeth Jones
24	85	(Pearl) Jackson
25	71	Theodore Harriston
25	64	Harry Smith
25, 27	69-A, B, D	Margaret Crowder
27	69C	Frank & Gertrude Johnson
27	61	Frank & Janie Johnson
27	69	Anita Hines
27	54	Leon Smith
28	131	Julia McDowell
28	132	Constance Crowder
29	118	Gertie Crowder
32	51	Melissa Meade
33	49	Nettie Johnson
33	51	Solomon Hunt
33	70	Florence Edwards
33	46	William & Susanna Hunt
33	55	Fred Anderson Estate (Betty)
33	59	Andrew & Beatrice Lawson

NEW CUSTOMERS INDEX

No.	Name
1	Richard L. Chubb
2	Mason Haynesworth, Richard Chubb, John Powell
3	U. S. Finance, Ida Mae Banks
6	U. S. Finance, David Hunt & Mary Ellen Hunt
9	Mason Haynesworth
11	Edward L. Starford
12	Joseph & Mary Keaton
13	William & Sybil Johnson
17	Wilfred Norton
18	Isiah & Virginia Sweetenberg
19	James Robertson, Jr.
20	Leona Morton
32	Milburn R. Smith
33	Pettie Johnson (Terry Coleman)
36	Rutrough-Mack-Carnest Bolden
39	Sandra Callenger
44	Thomas & Elizabeth Noell
45	Robert & Amy Burger
46	William & Susanna Hunt
49	Nettie Johnson
51	Solomon Hunt
53	Moses & Mary Anderson
54	Julia McDowell
55	Fred Anderson Estate
58	Frank & Marie Johnson
59	Andrew & Beatrice Lawson
64	Margaret Crowder
69	Leona Hunt
70	Florence Edwards
71	Harry Smith
77	William, Sr. & Francis Bolden
79	Monroe & Rosalie Johnson
80	Pearl Jackson, Theodore Jackson
85	Thomas Noell
87	Lottie Bolden
88	First Baptist Church
92	Ruth S. King, Mary K. Knowles
96	William & Helen Megginson
100	Wade H. Minnis
104	Wade H. Minnis
105	Brion & Rene Croan
111	Doris Crowder
114	Harry & Mary Smith
115	James E. Lewis
116	Melissa Meade
118	James H. Johnson
119	Edward & Francis Mitchell
120	Leona Hunt (Oriss Hunt HRS)
123	Emma Bruce
124	Archie Bruce
125	Olivia Jean Smith
127	Shirley & Monroe Johnson
130	Constance Crowder
131	Gertie Crowder
132	Esther B. Sadler
135	Esther B. Sadler
136	Wendell & Betty Bruce
137	Mattie Craighead
139	Dollie Smith
140	George & Celeste Bruce
142	Rosalie Hunt (HRS) Zacariah Hunt
149	Lorine Harris
153	Mary Elizabeth Wright
154	Webb's Oil
157	Charles & Viola Johnson
158	George Garrison
162	Dave Bruce
166	Fred & Maggie Anderson
167	Louise J. Harris
171	William & Mary Hunt HRS - Maggie S. Hunt
173	Susanna (Mrs. Julian) Morton
175	Ed Mitchell
176	Ruth Wilson Hunt, Jamie Loflar, (occupant)
177	Paul Garrison HRS
178	Cecil Garrison
183	Alice Garrison
184	Louis McRalls
185	Robert & Annie Milton
186	George & Mattie Johnson
42A	James E. & Stella M. Carpenter
61	J.L. Francis
165	Anita Hines
17	Willie Hunt
17	Ira Womack
128	William M. & Carrie Gaither Hrs. - Ethel Bonds
96	ELIZABETH JONES
57	ANDREW & BEATRICE LAWSON
37	LEONARD BUTLER
34	George Mead

◻ DENOTES CUSTOMERS INDEX NO. FOR IDENTIFICATION OF SERVICE CONNECTIONS

RECORD DRAWING

DESIGNED	CAT	DATE		DESCRIPTION	BY	APP.
DRAWN	CAT					
CHECKED	JWC					
APPROVED						
SUBMITTED						

INDEX MAP

86-09-W/S

Mattern & Craig
CONSULTING ENGINEERS

SCALE AS NOTED

DATE AUG 36

491

3

