



PLAN	SURVEYED	DATE
	PLOTTED	BY
NOTE BOOK	NO.	

PROFILE	SURVEYED	DATE
	PLOTTED	BY
NOTE BOOK	NO.	

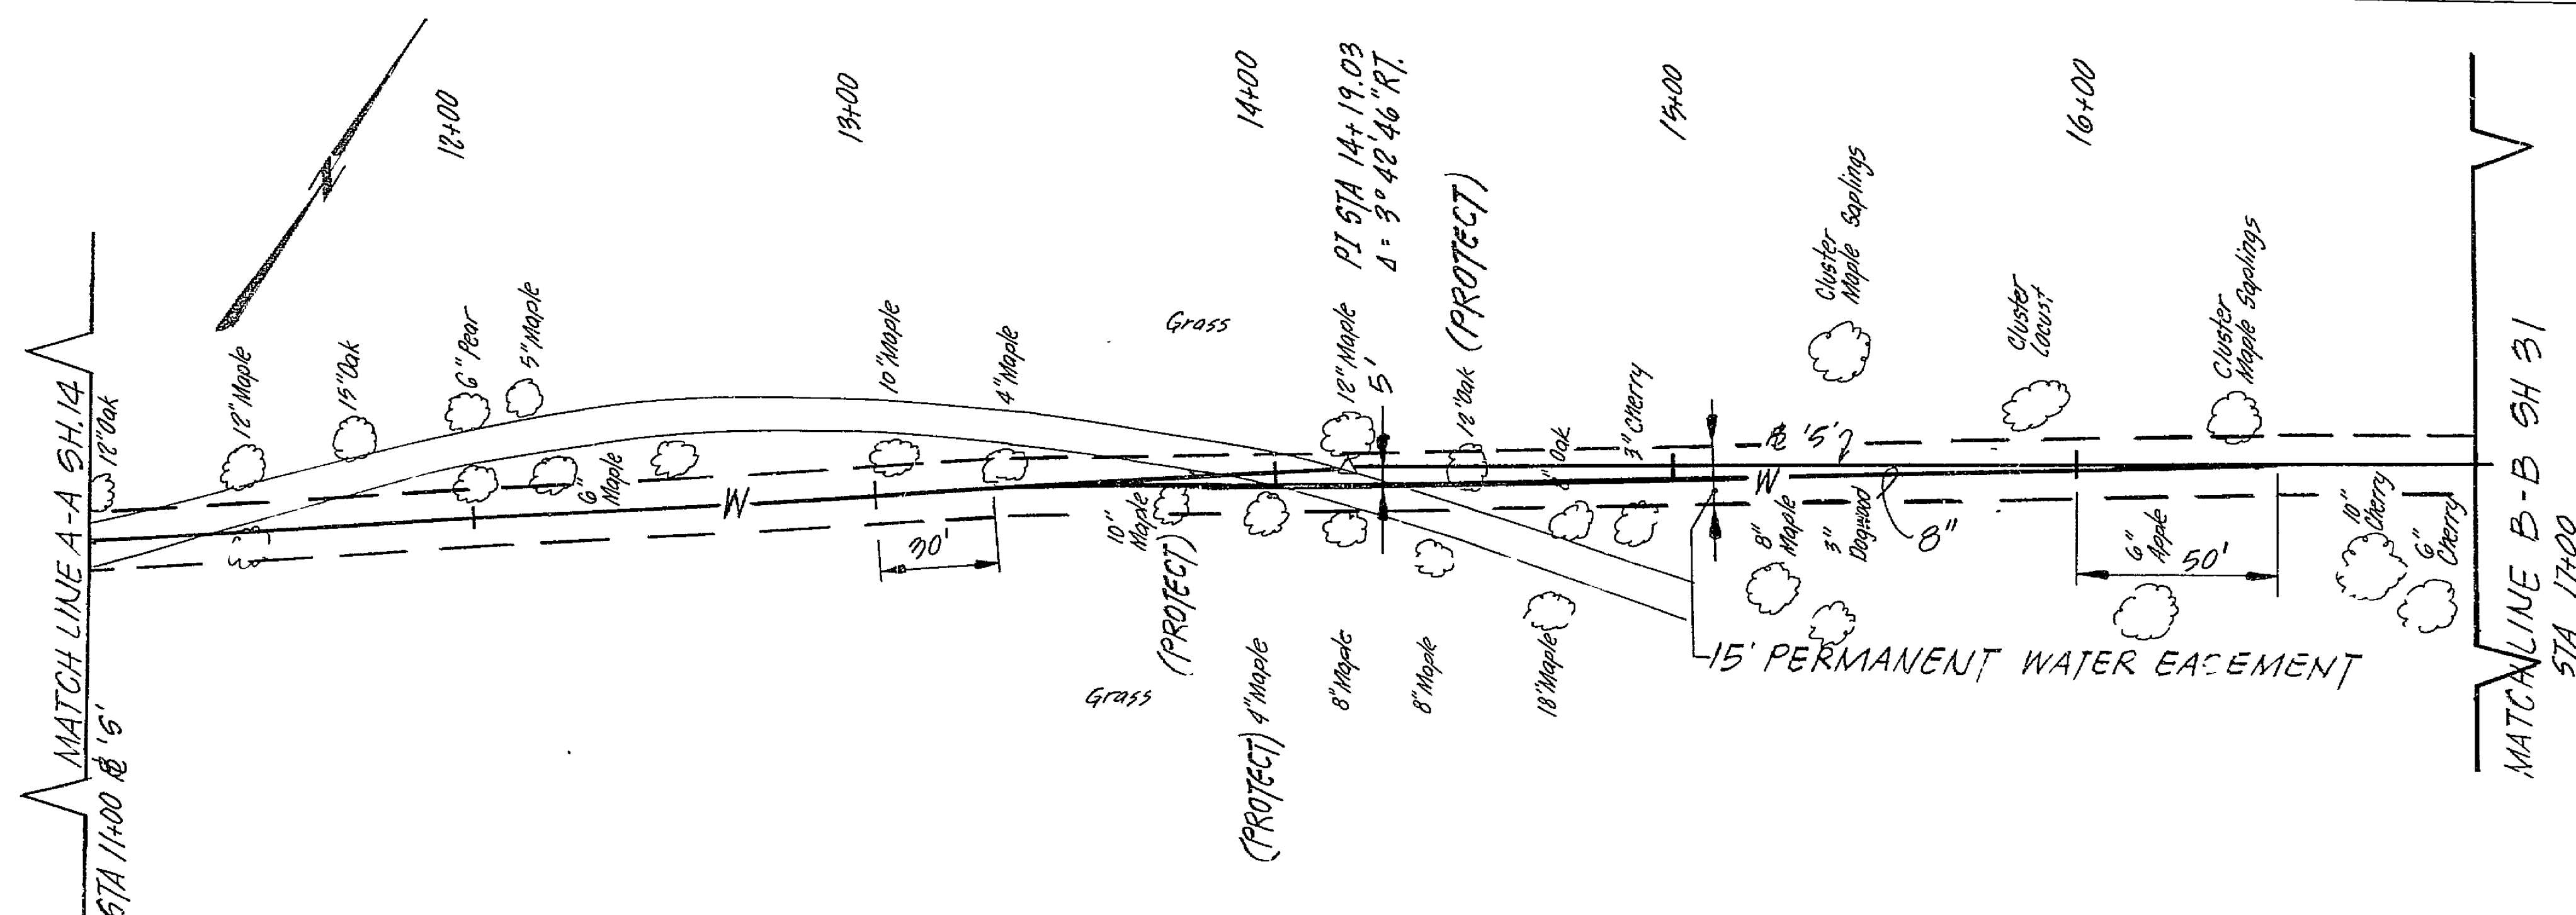


SCALE: HORZ. 1" = 30'
VERT. 1" = 10'

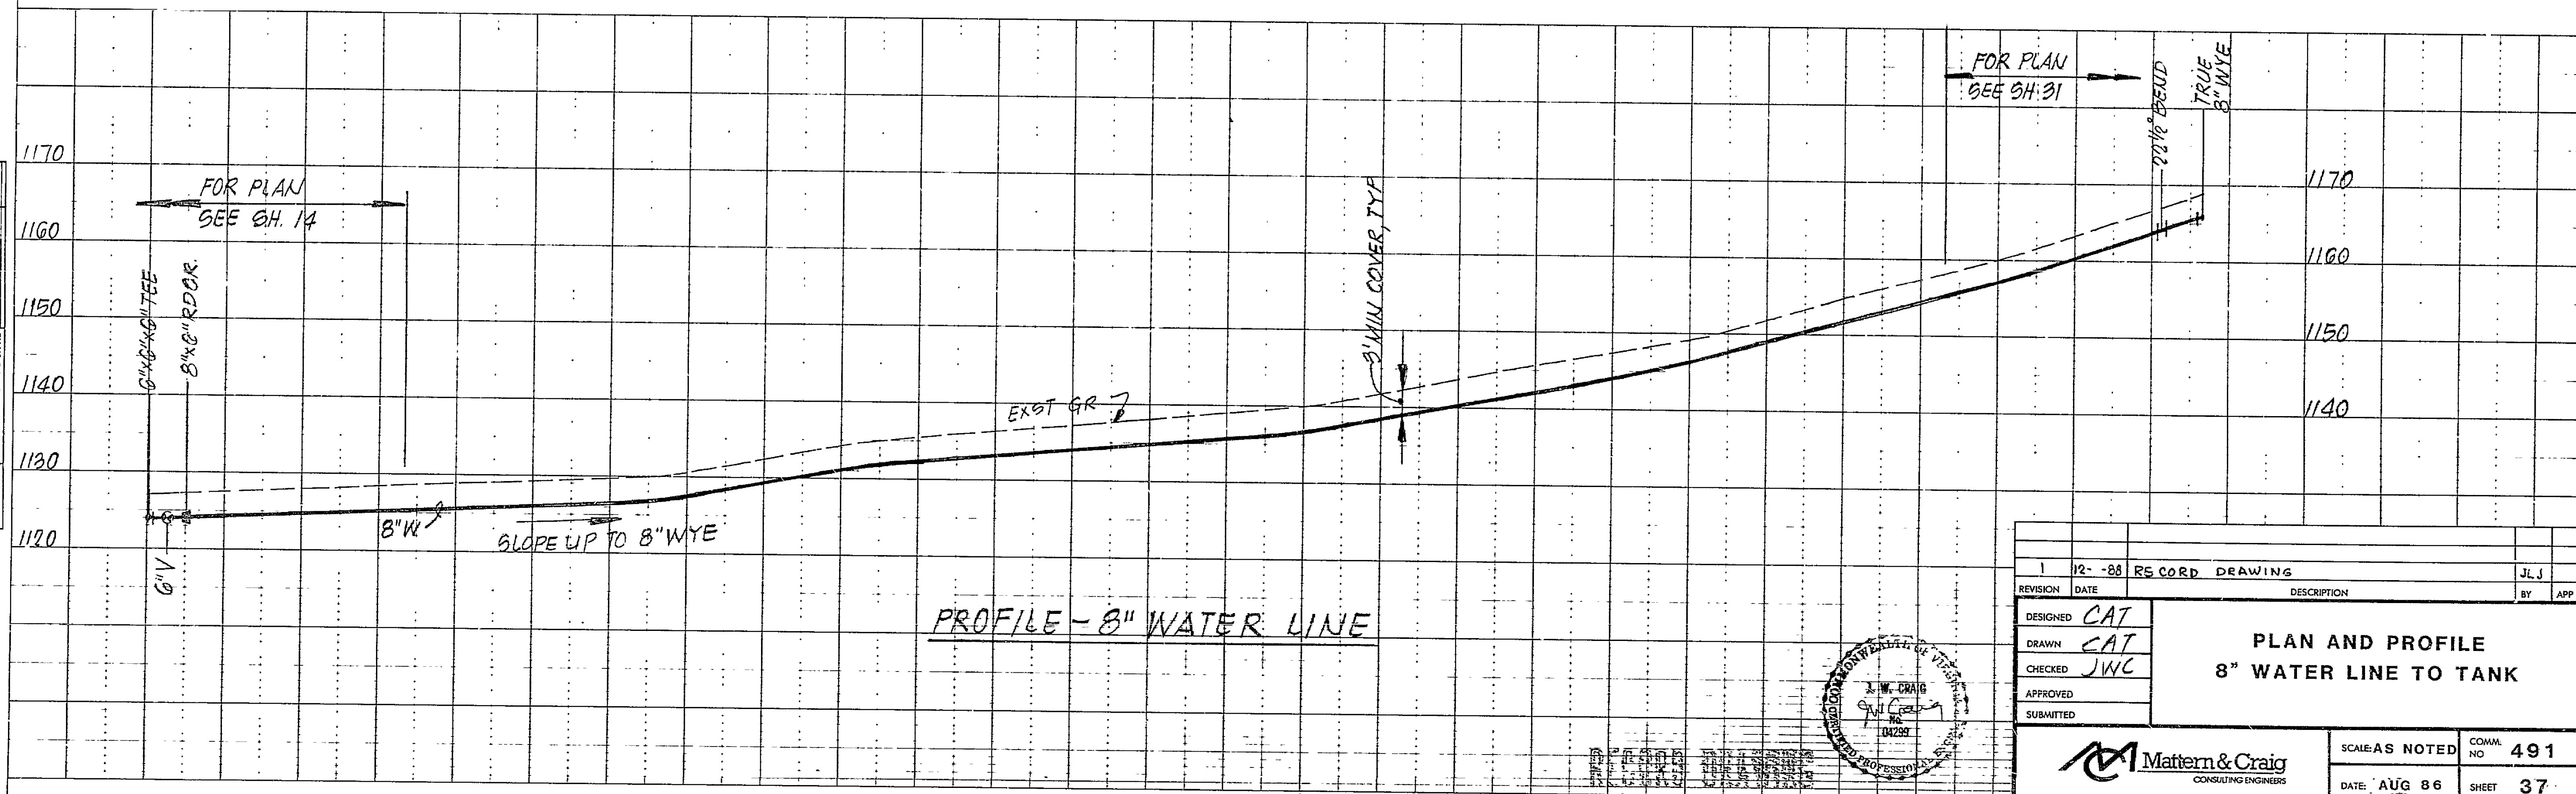

1		12-88	RECORD DRAWING	JLJ	APP
DESIGNED	CAT	DESCRIPTION		BY	APP
DRAWN	CAT	PLAN AND PROFILE 8" WATER LINE TO TANK			
CHECKED	JWC				
APPROVED					
SUBMITTED					

SCALE: AS NOTED COMM. NO. 491
DATE: AUG 86 SHEET 37

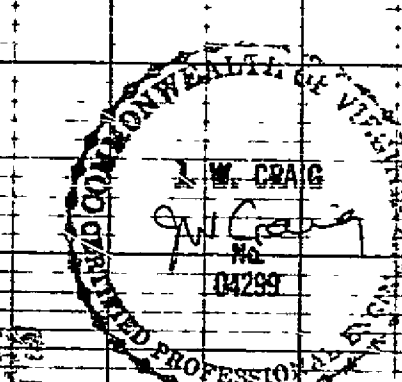

86-09-W/S

