


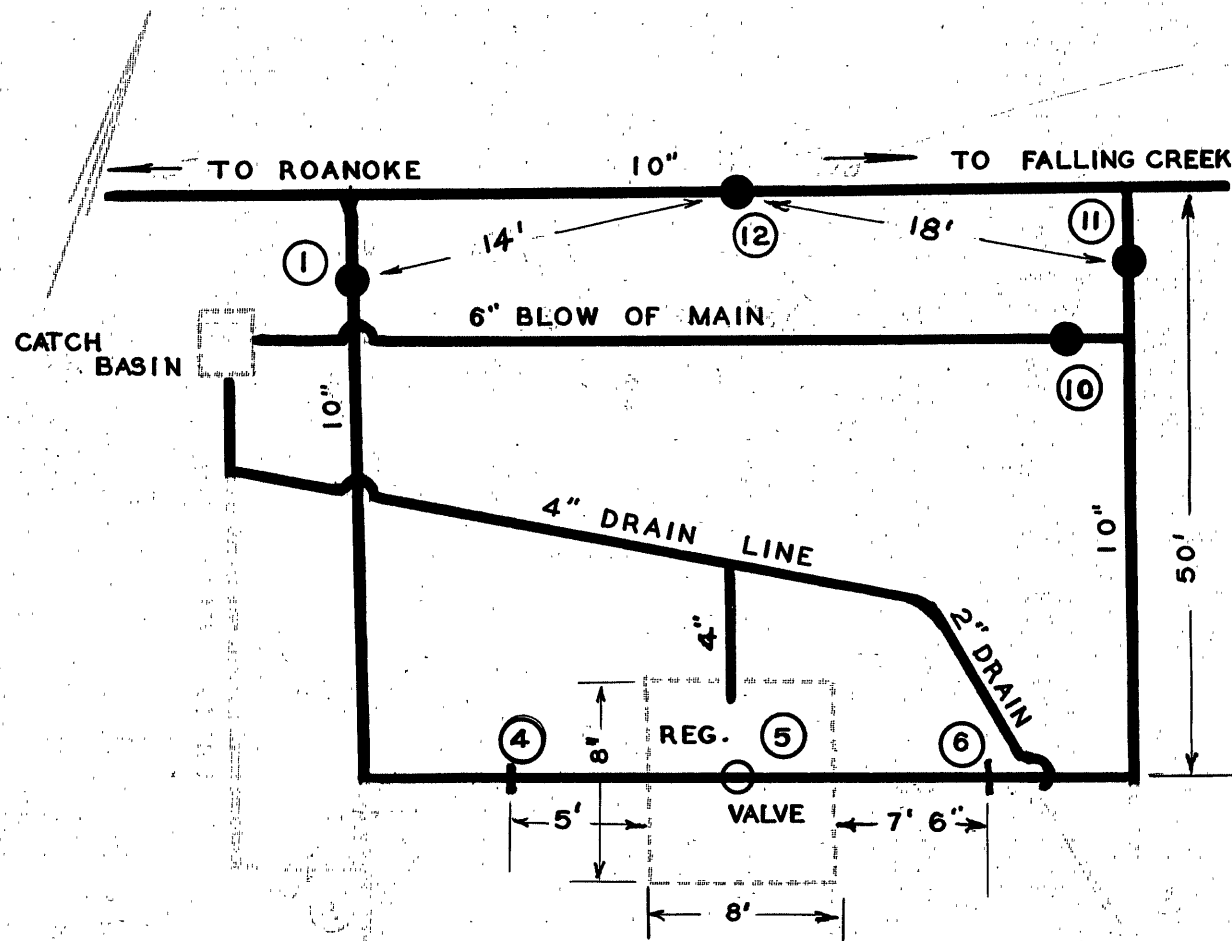

DATE	NO.	SIZE	MAKE	OPEN	TURNS
1939	1	10"	DARLING	R	32
1939	4	10"		R	16
1939	5	10"	REGULATOR		
1939	6	10"		R	32
1939	10	6"	KEEP CLOSED		
1939	11	10"	DARLING	R	32
1939	12	10"	DARLING	R	32

CITY OF ROANOKE—WATER DEPT
 VALVE DIAGRAM
 VA. AVE. VINTON AT
 REGULATING STATION
 NO. 1

SEC. MAP S-13

DATE

PAGE NO. S.E.246

5/18/43 JHW