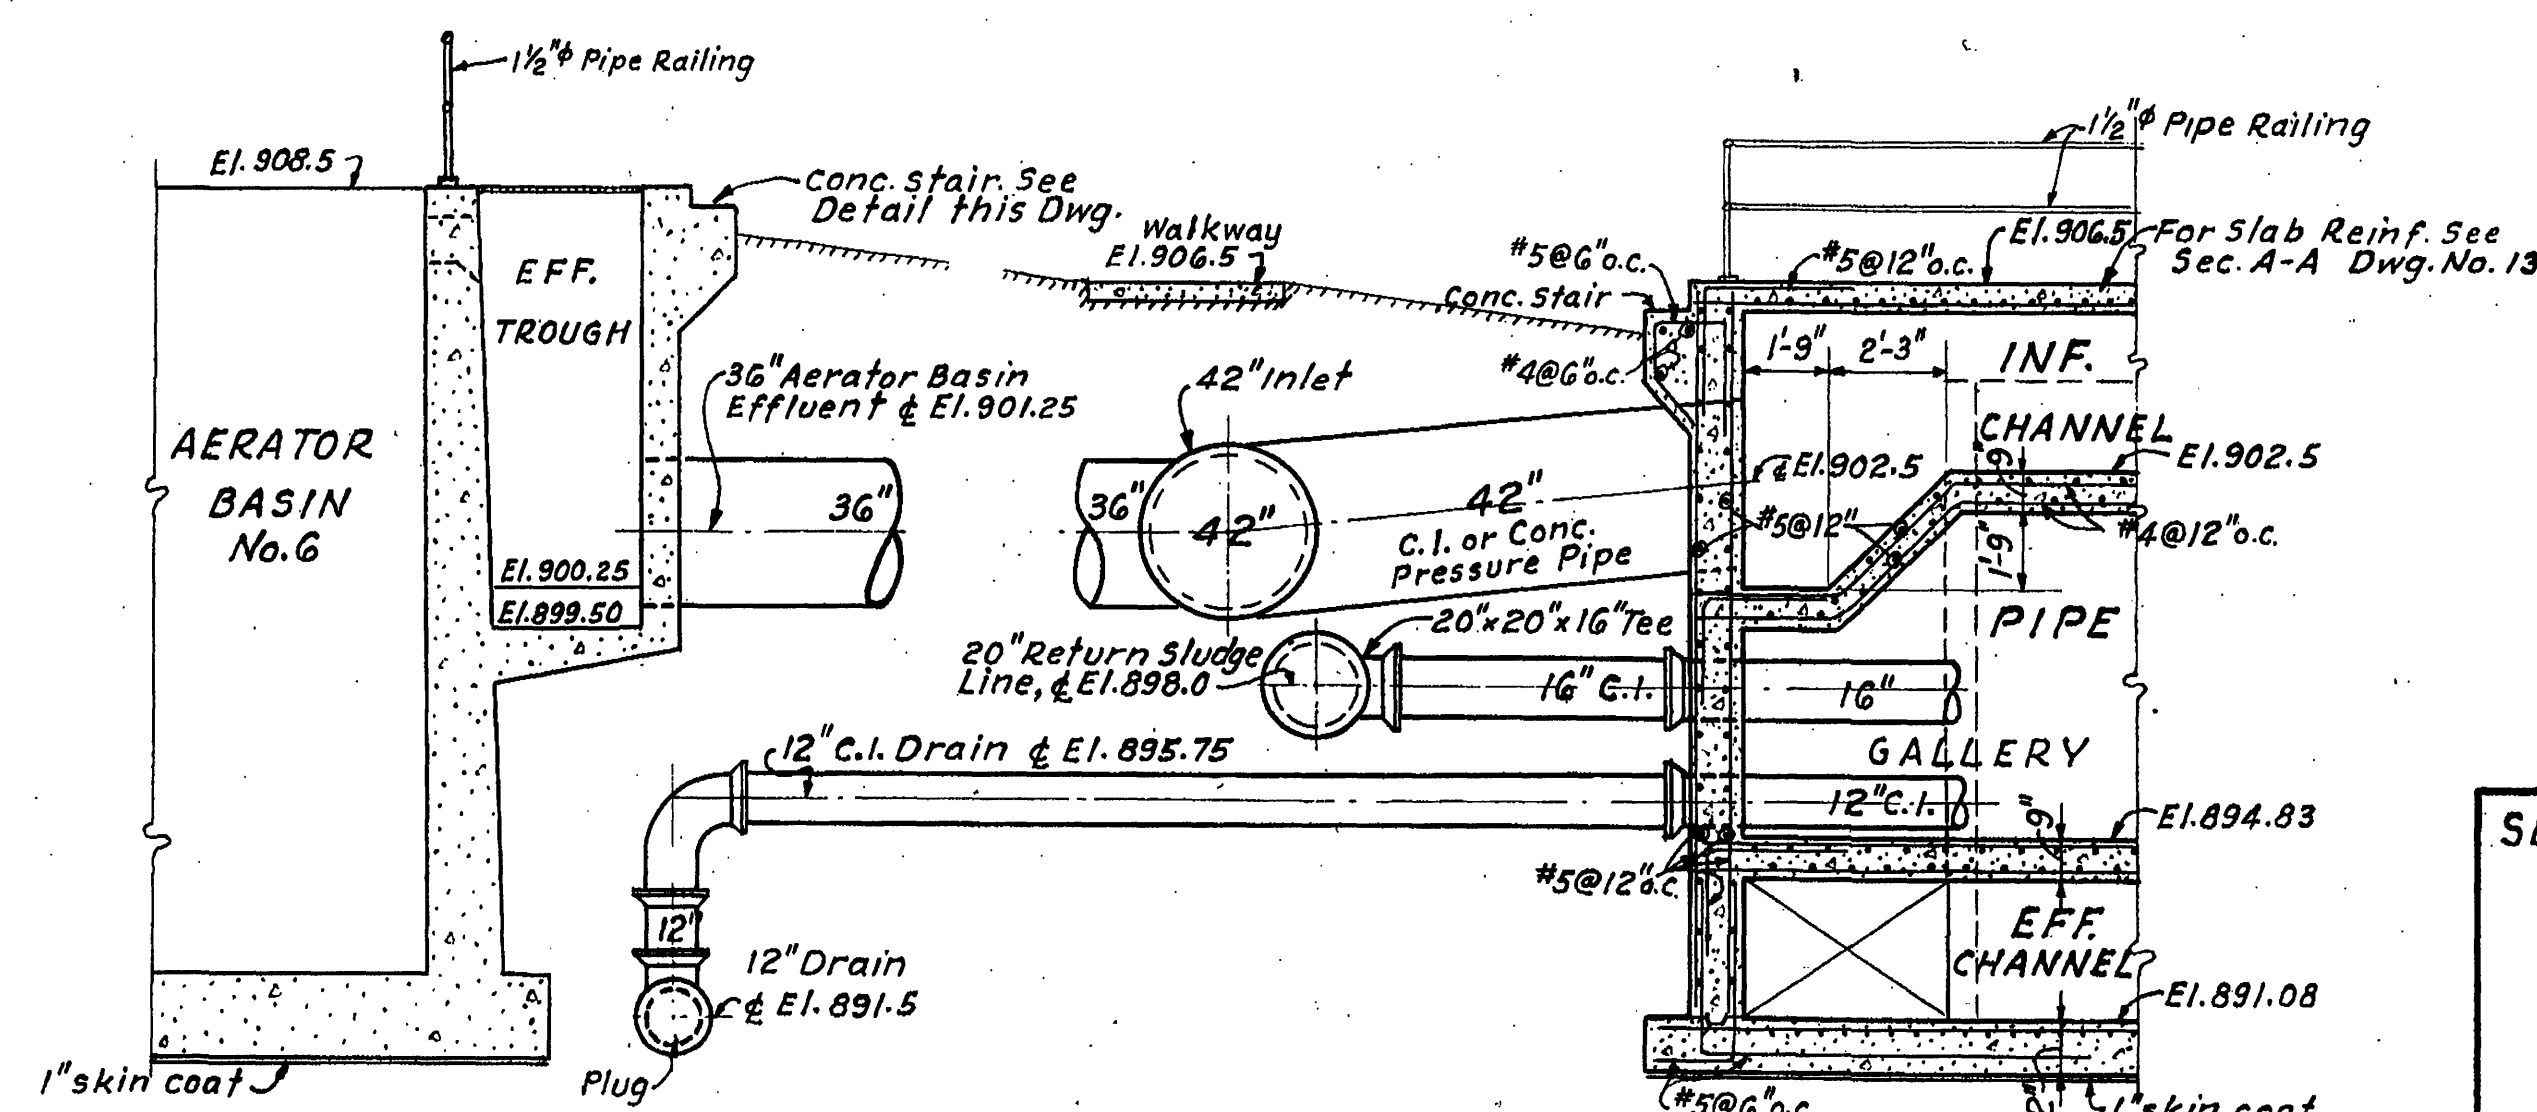
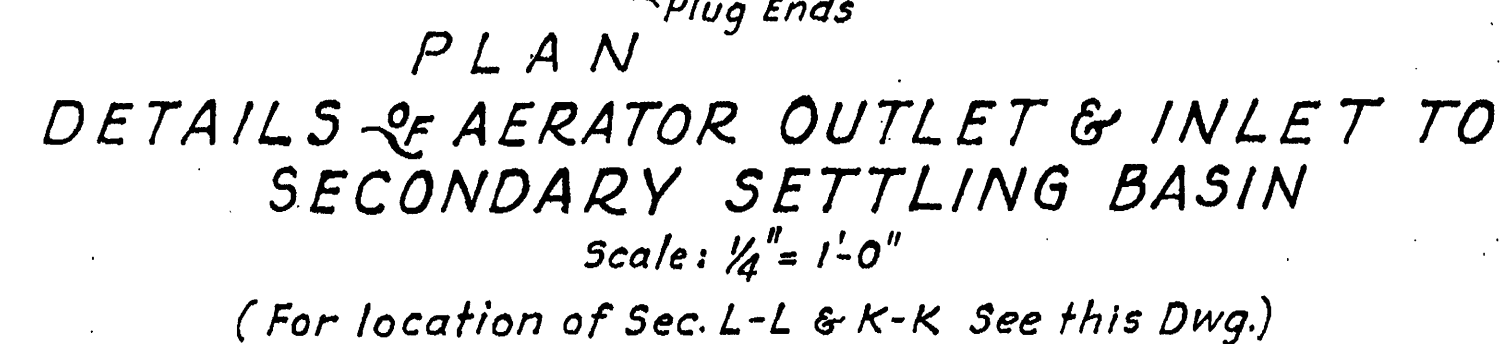
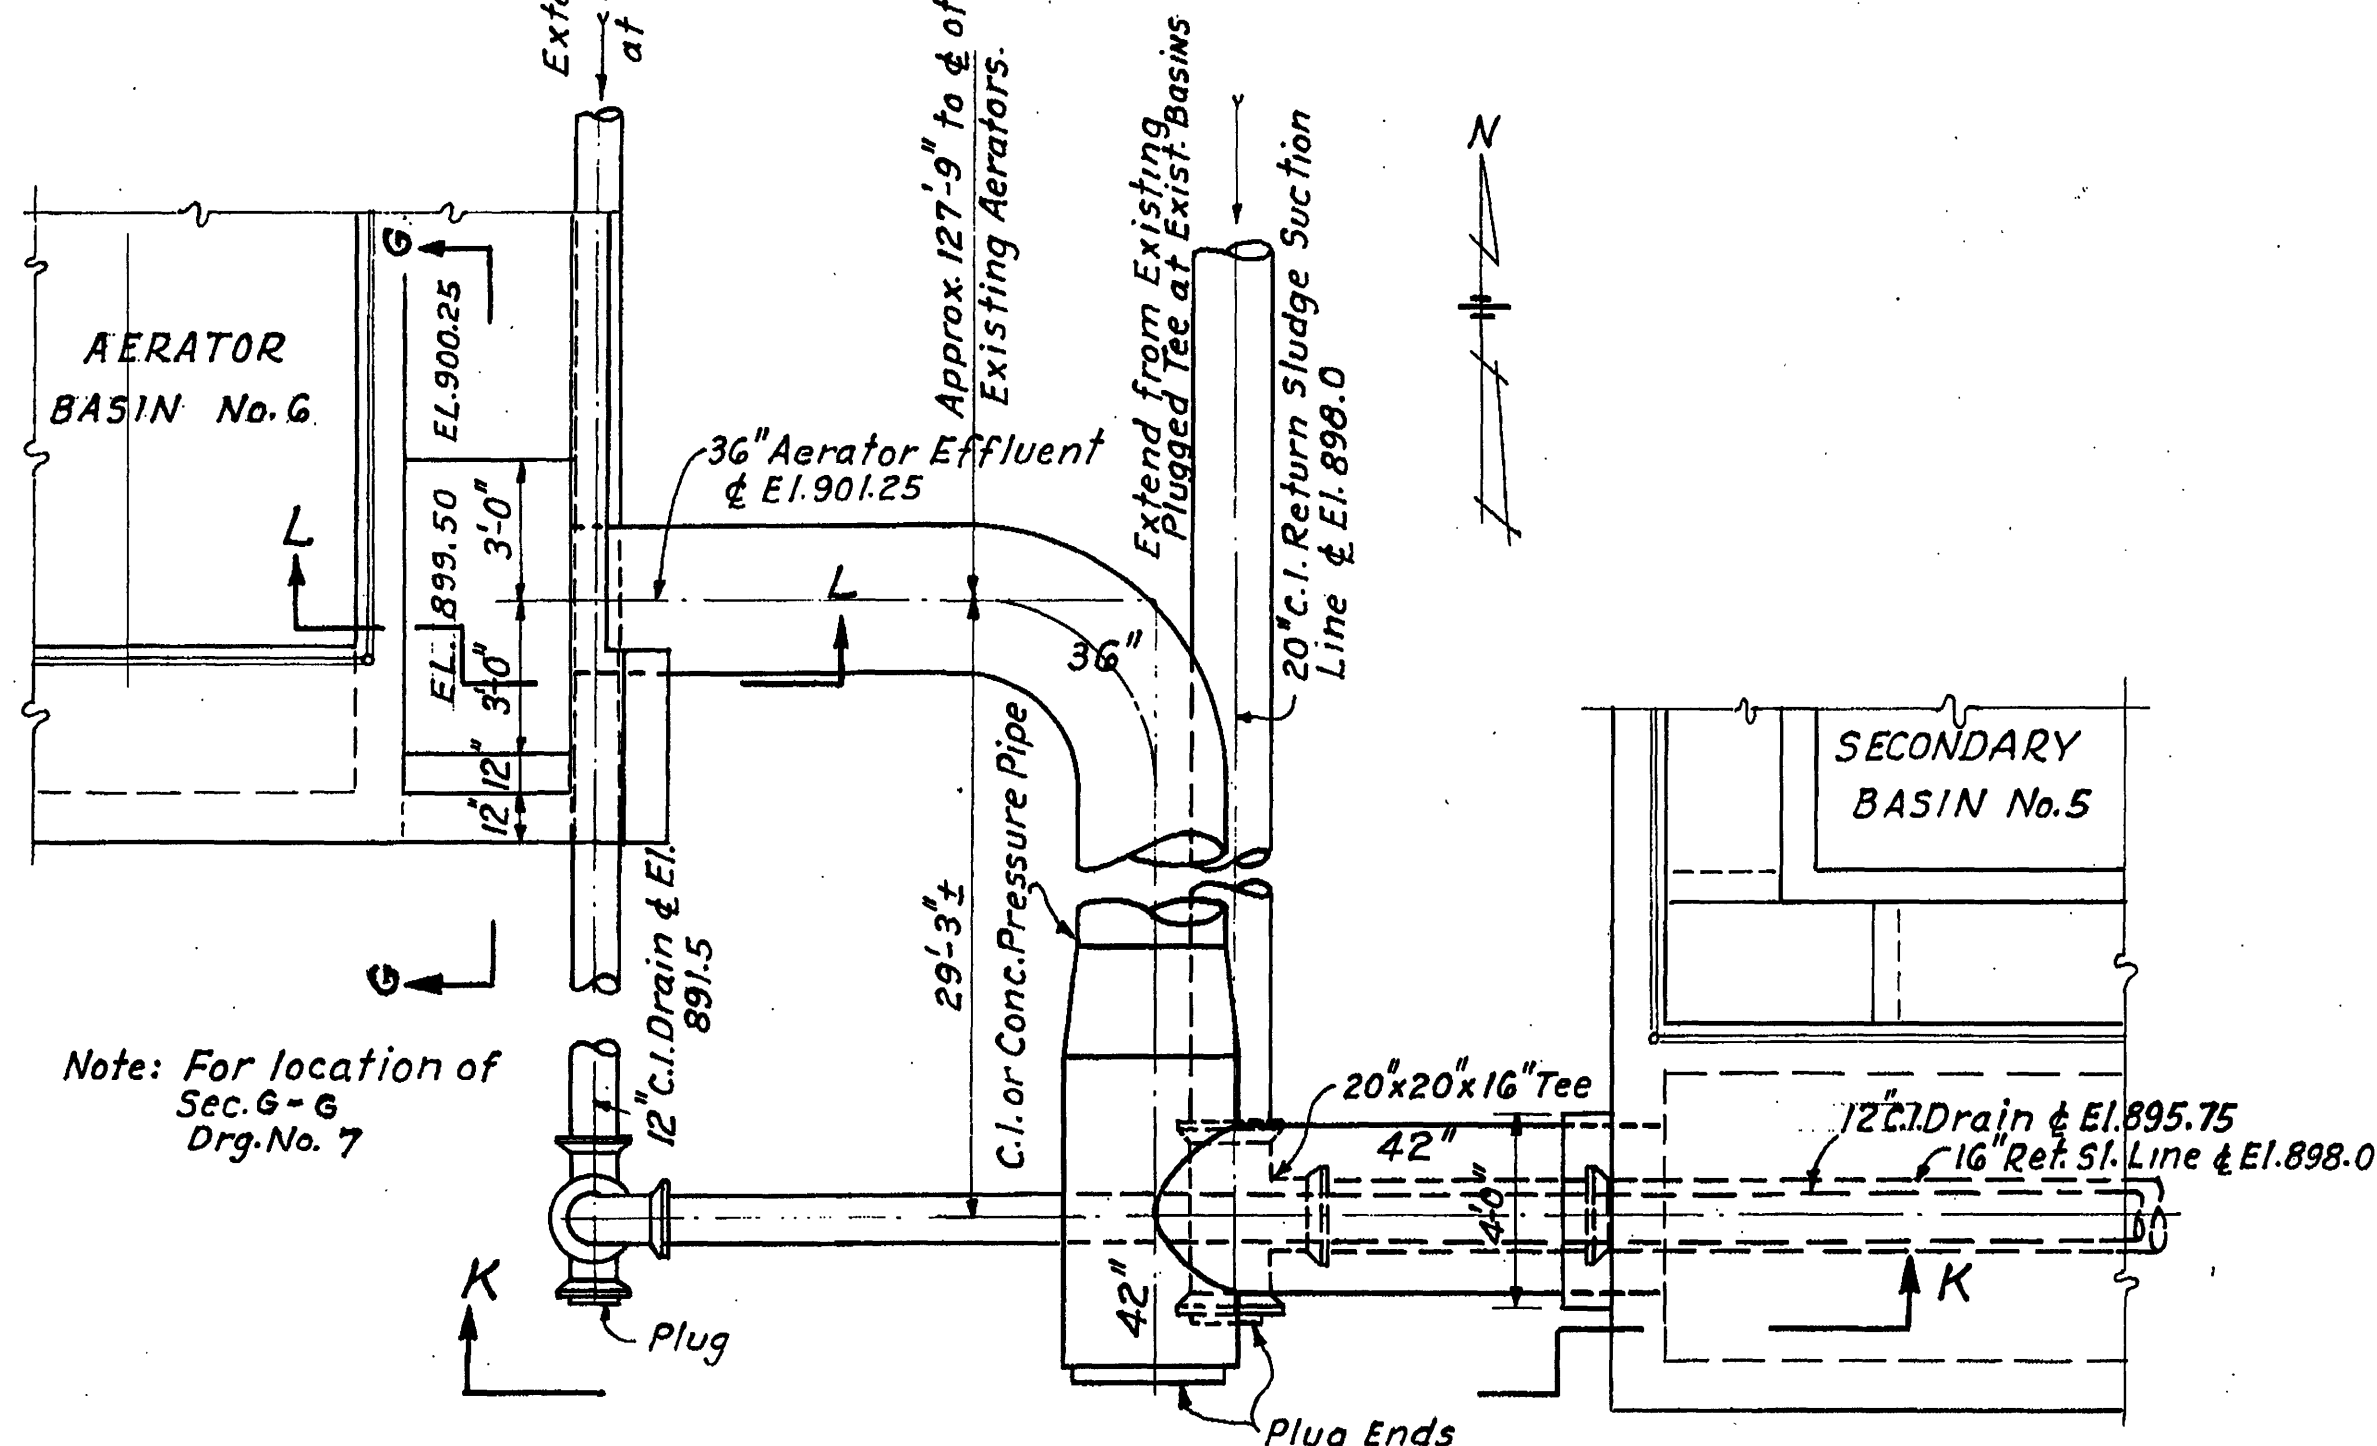
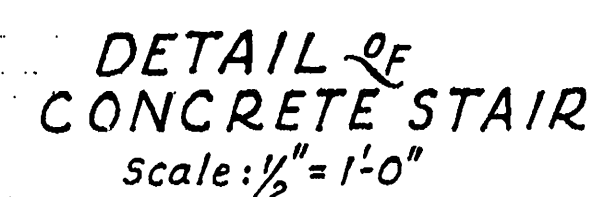
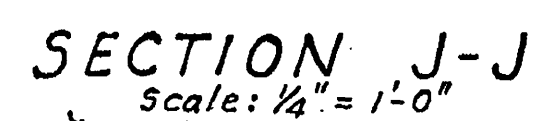
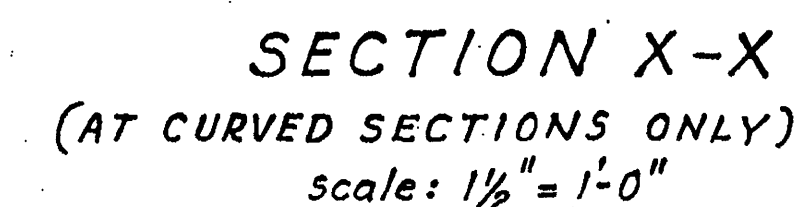
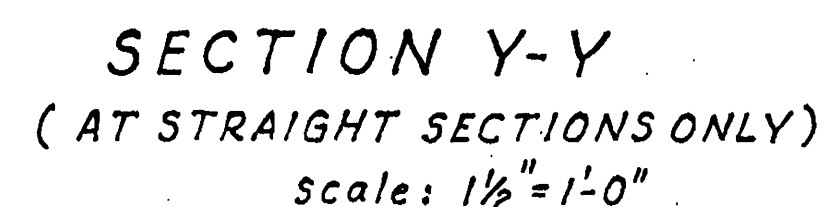
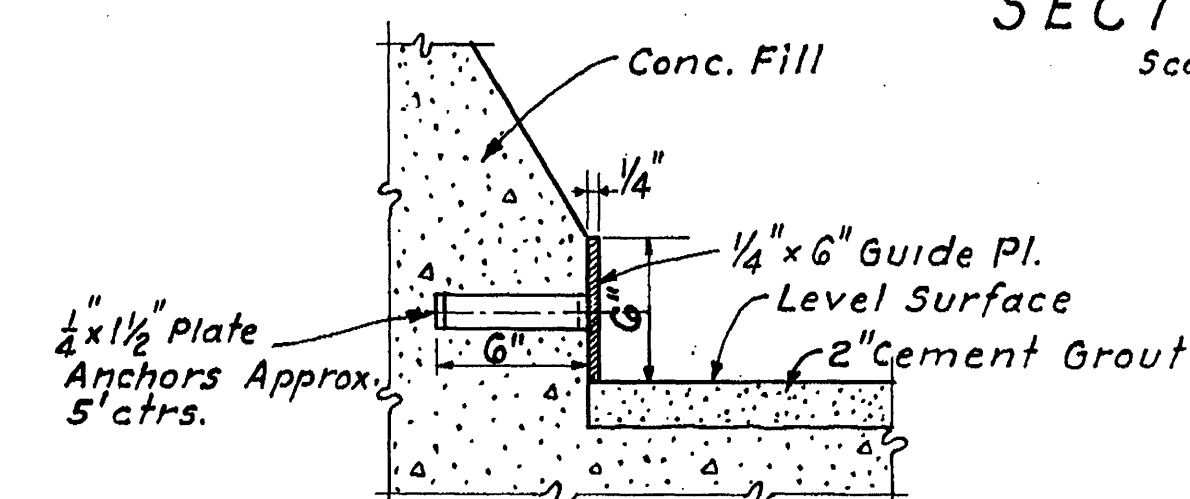
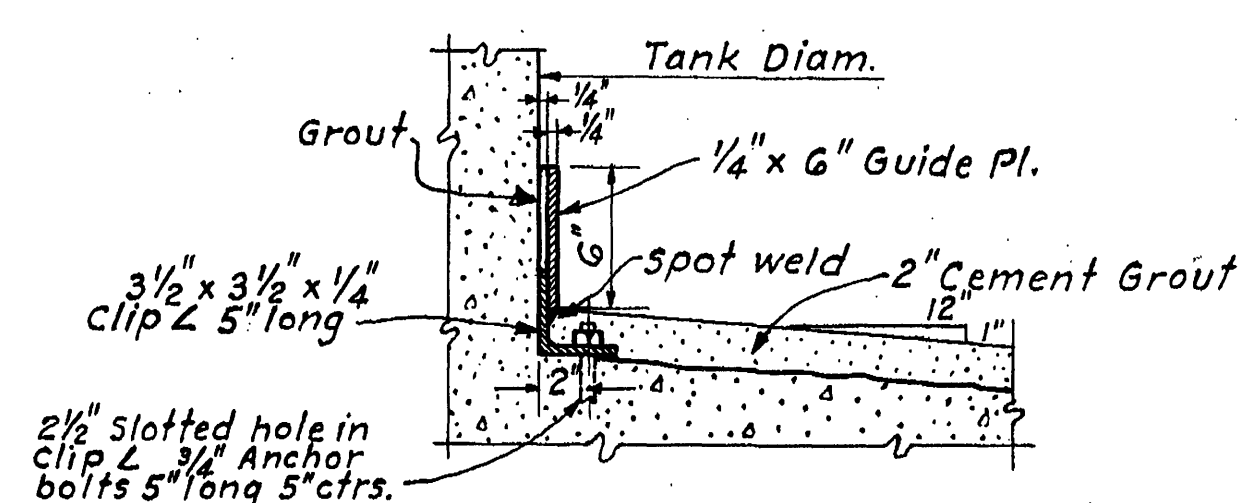
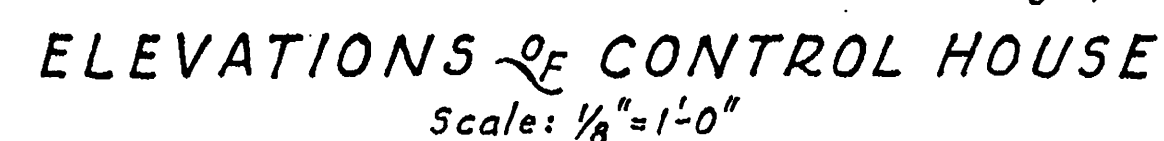
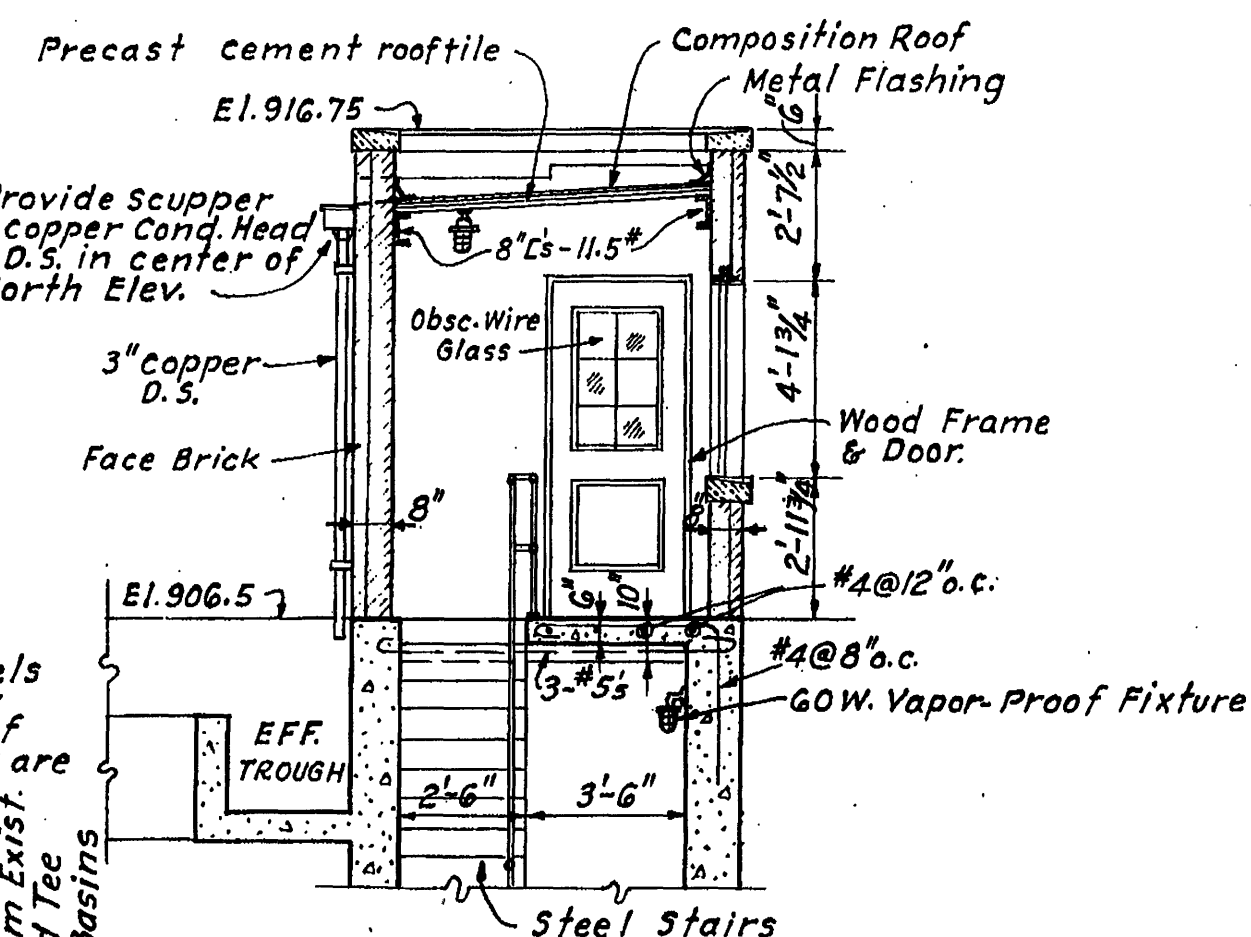
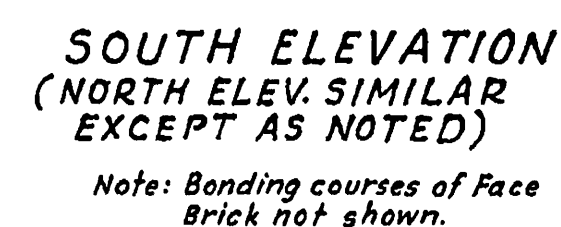
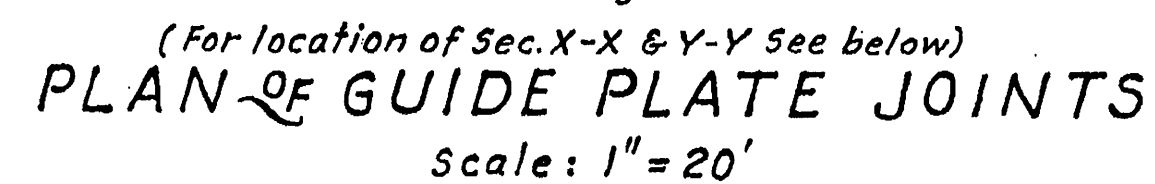
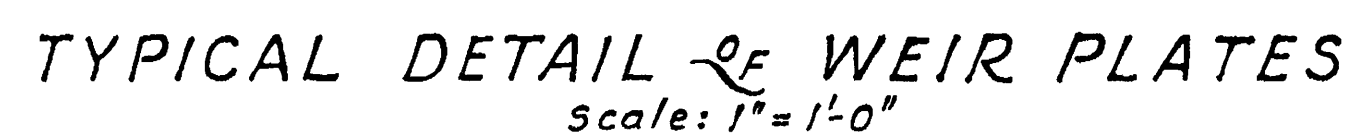


Superseded
11/27/59

15

SEWAGE TREATMENT PLANT ADDITIONS
SECONDARY SETTLING
BASIN DETAILS
CITY OF ROANOKE,
VIRGINIA

ALVORD, BURDICK & HOWSON
ENGINEERS 1959 CHICAGO