




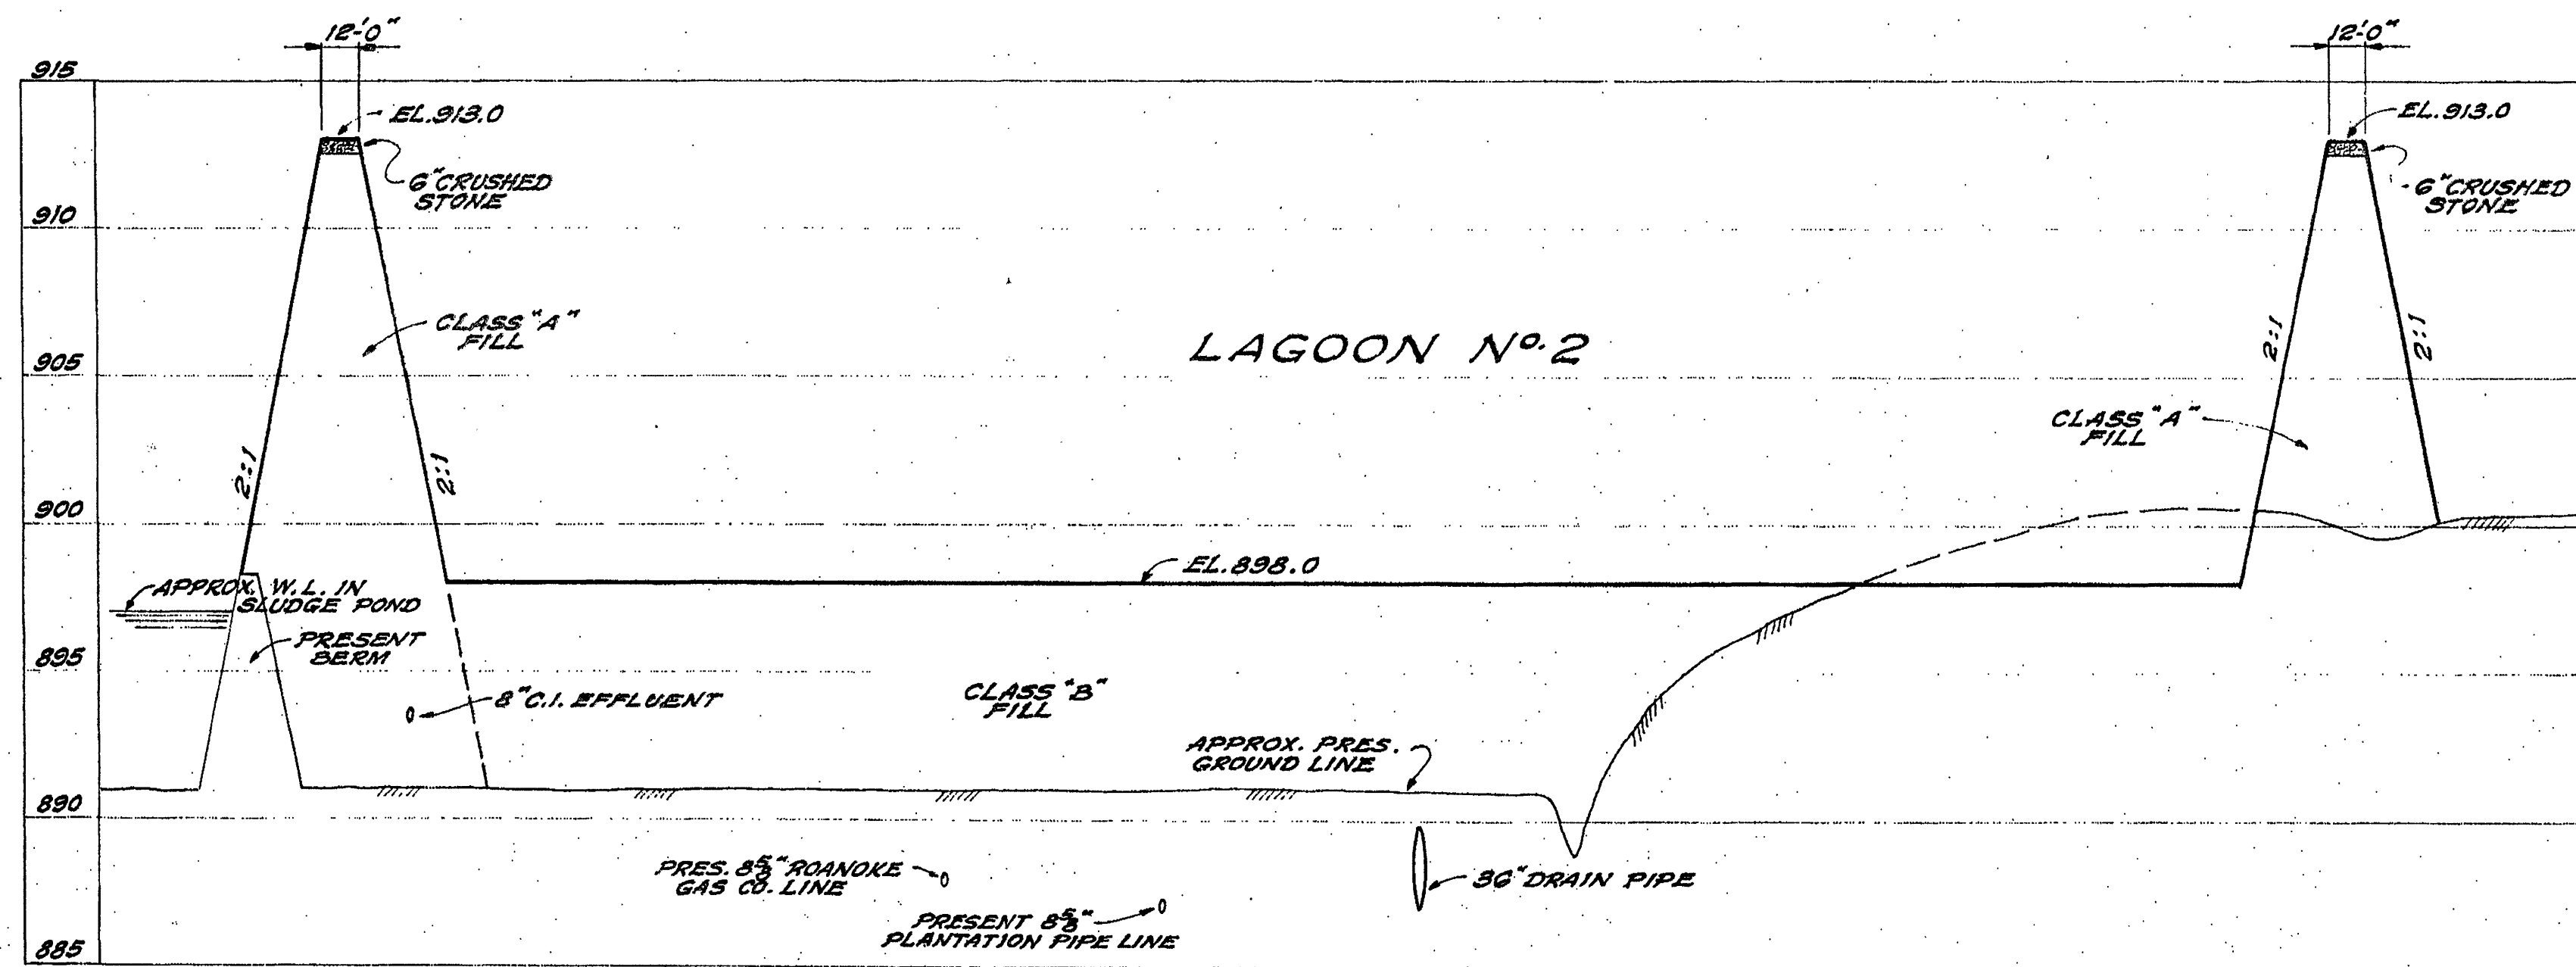


SECTION A-A
 SCALES: HORIZ. 1" = 50'
 VERT. 1" = 5'

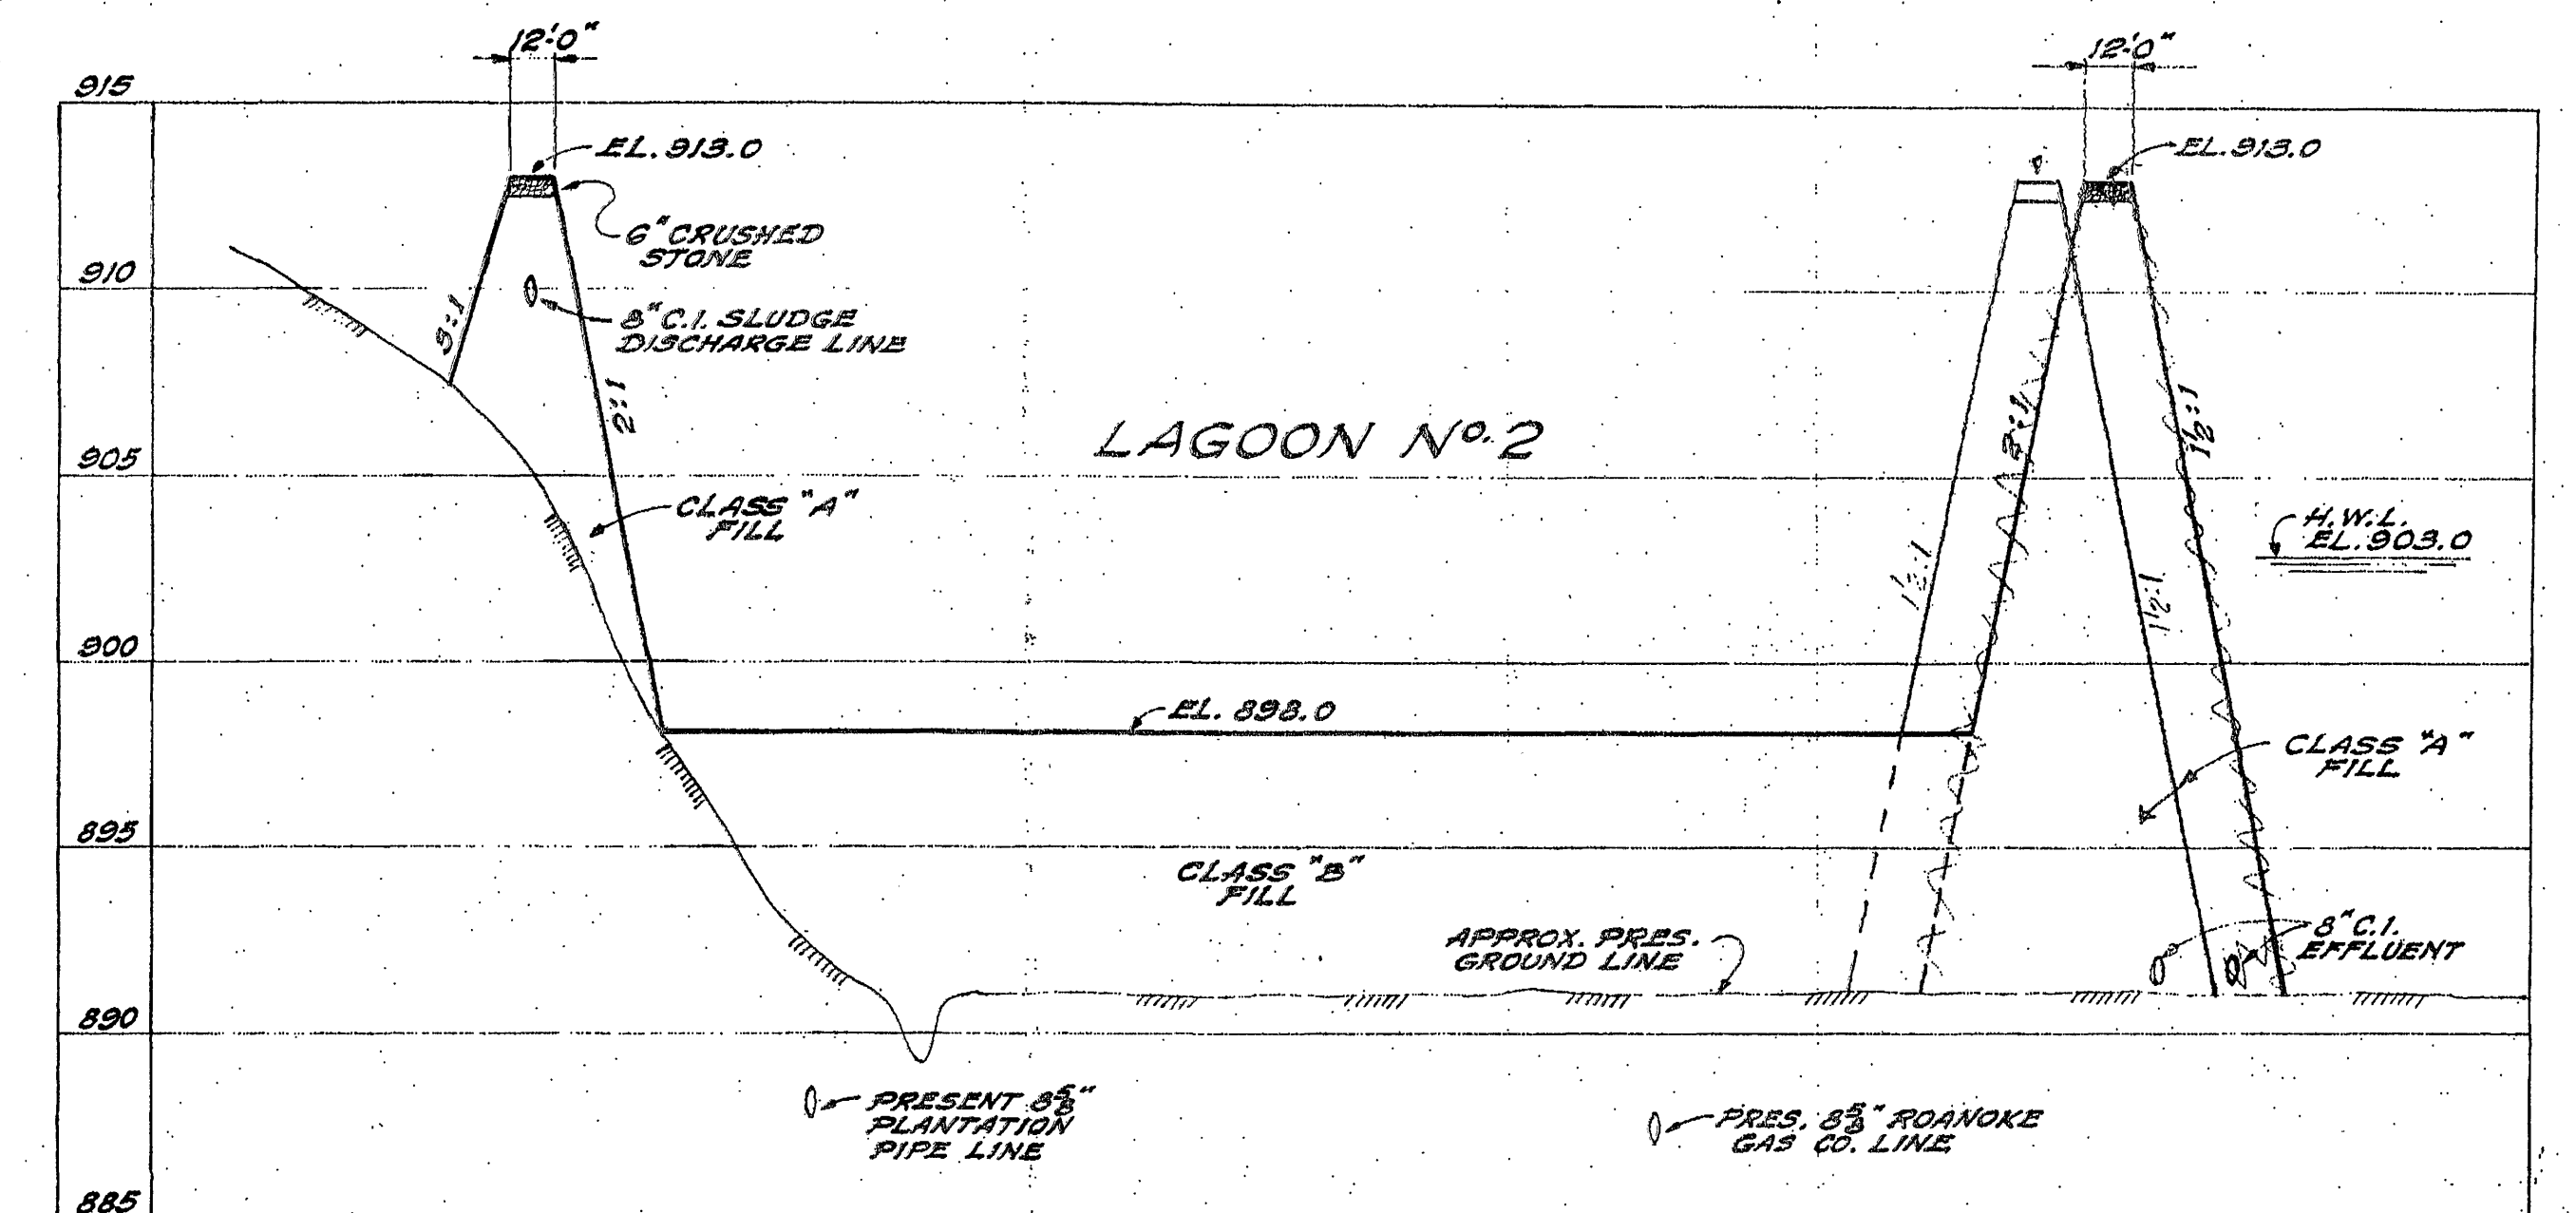

SECTION B-B
 SCALES: HORIZ. 1" = 50'
 VERT. 1" = 5'

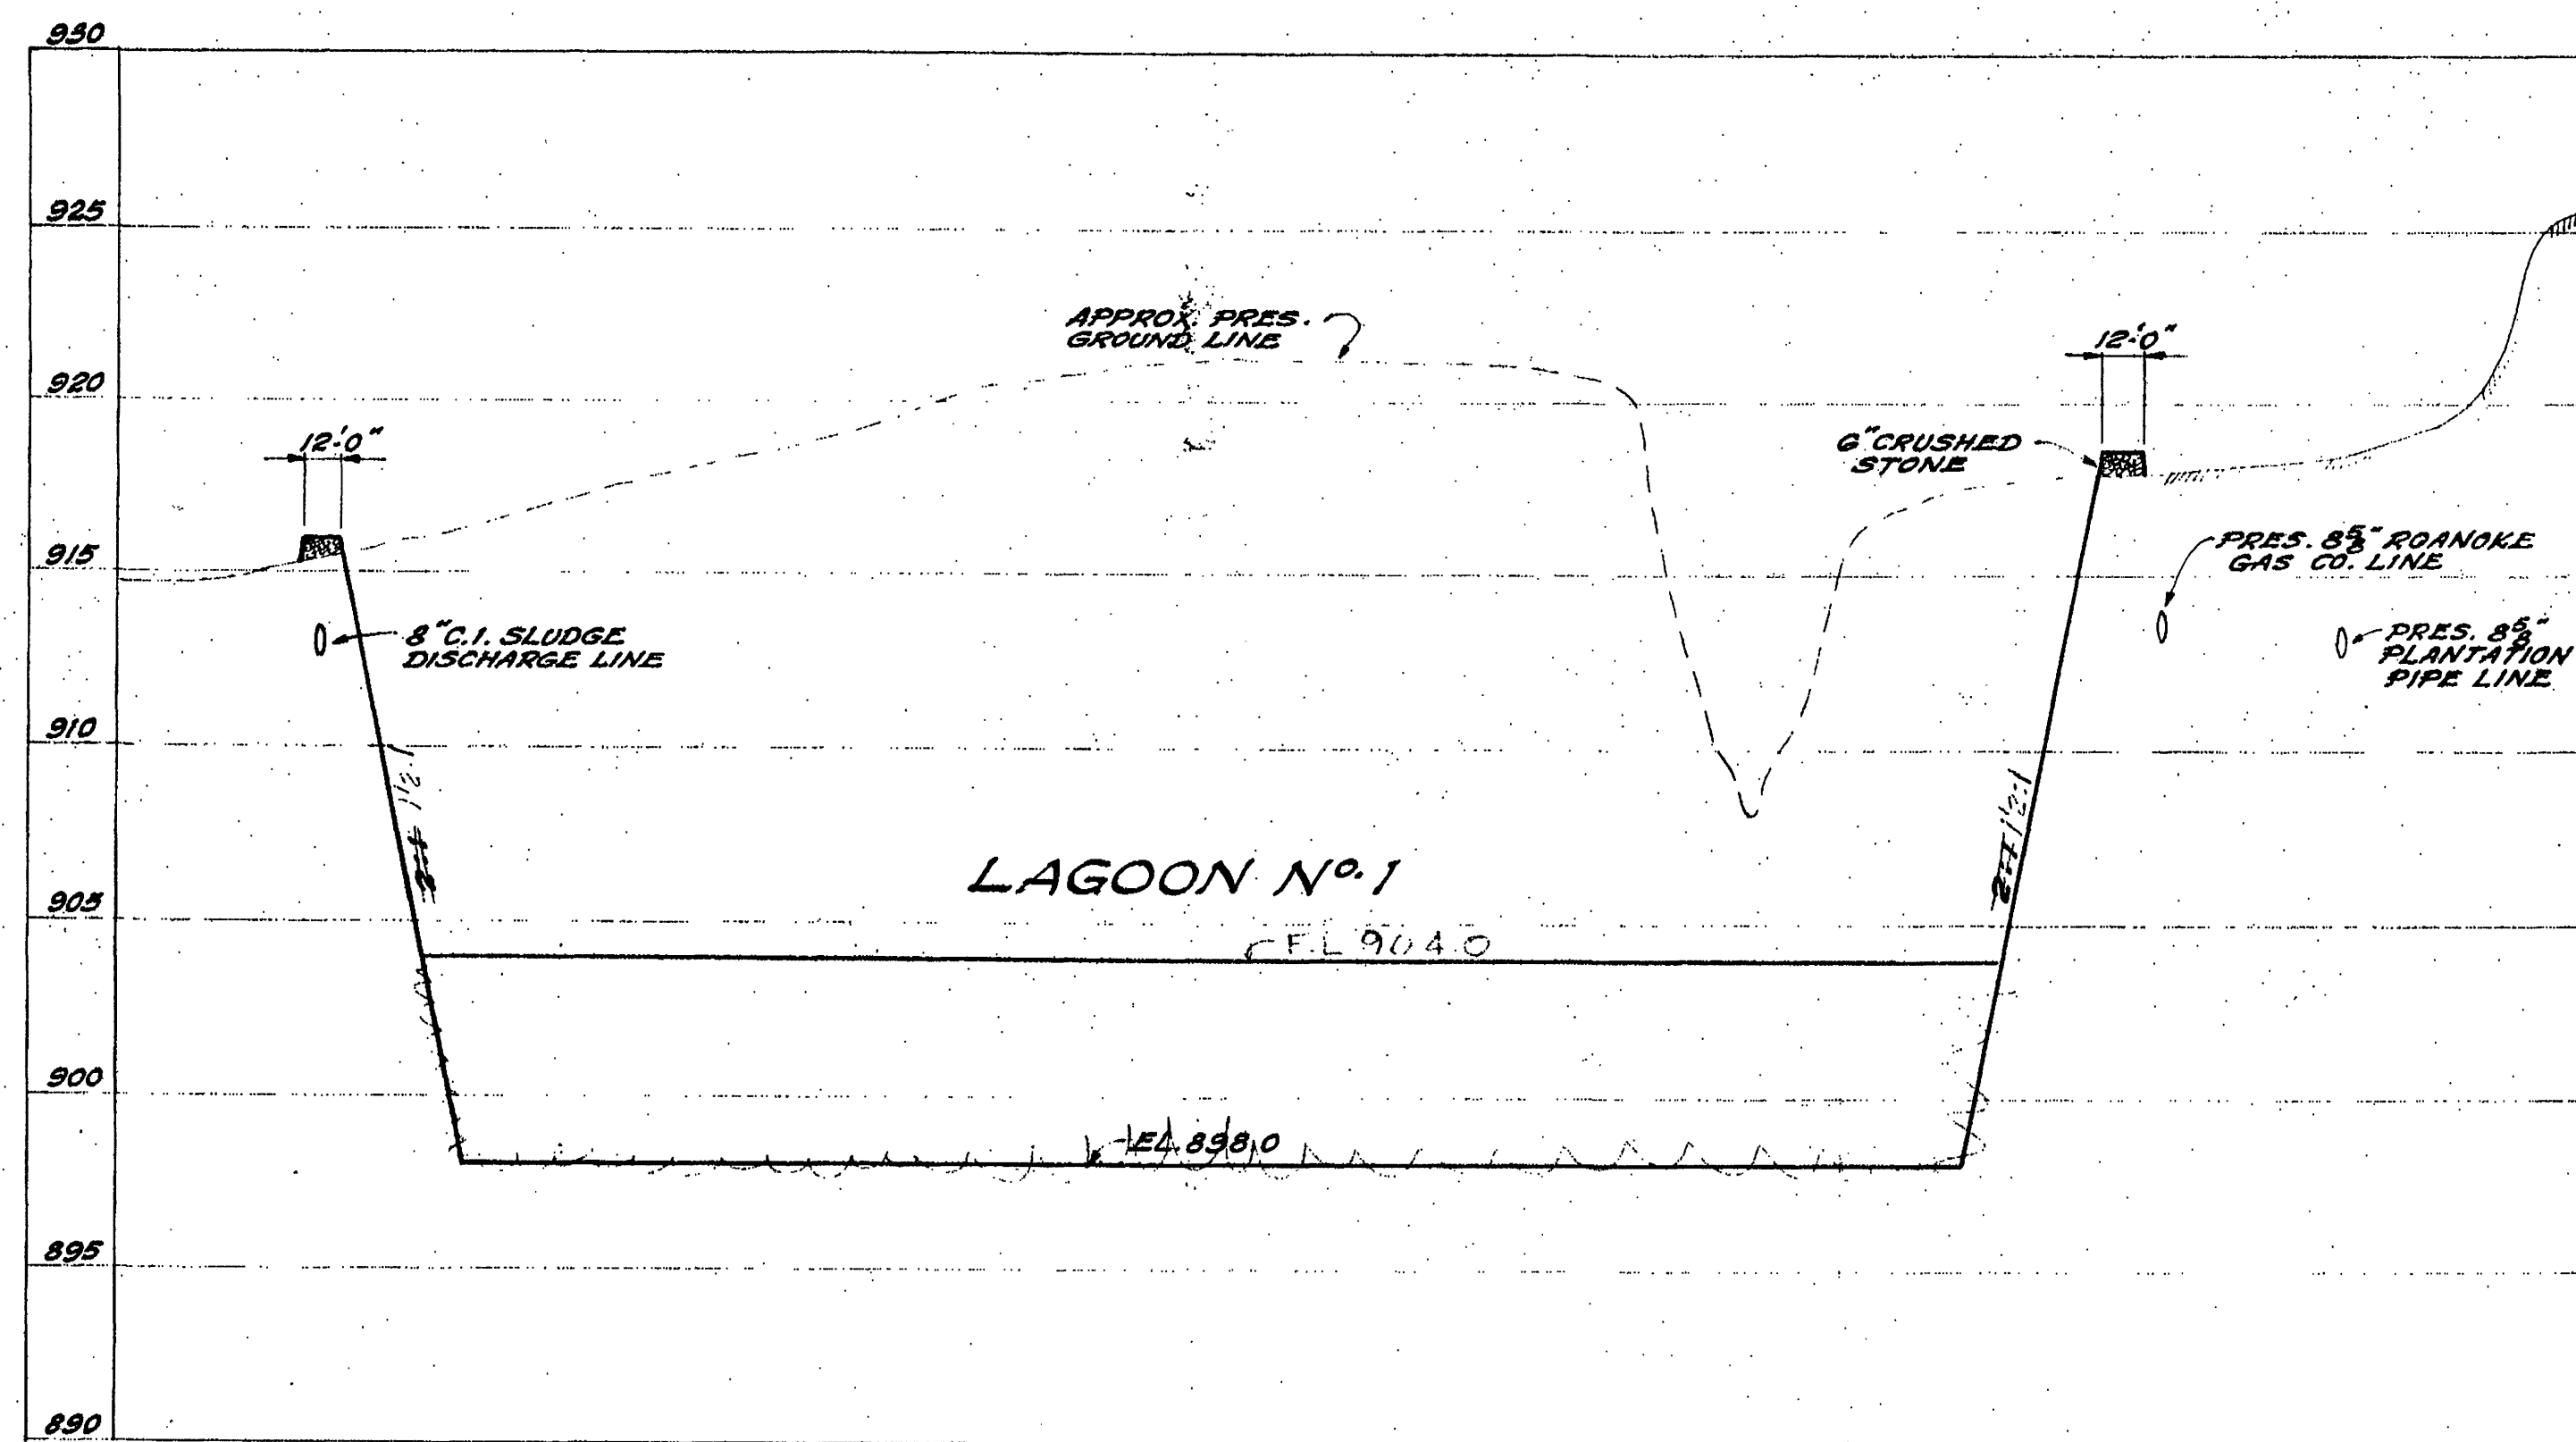

SECTION C-C
 SCALES: HORIZ. 1" = 50'
 VERT. 1" = 5'

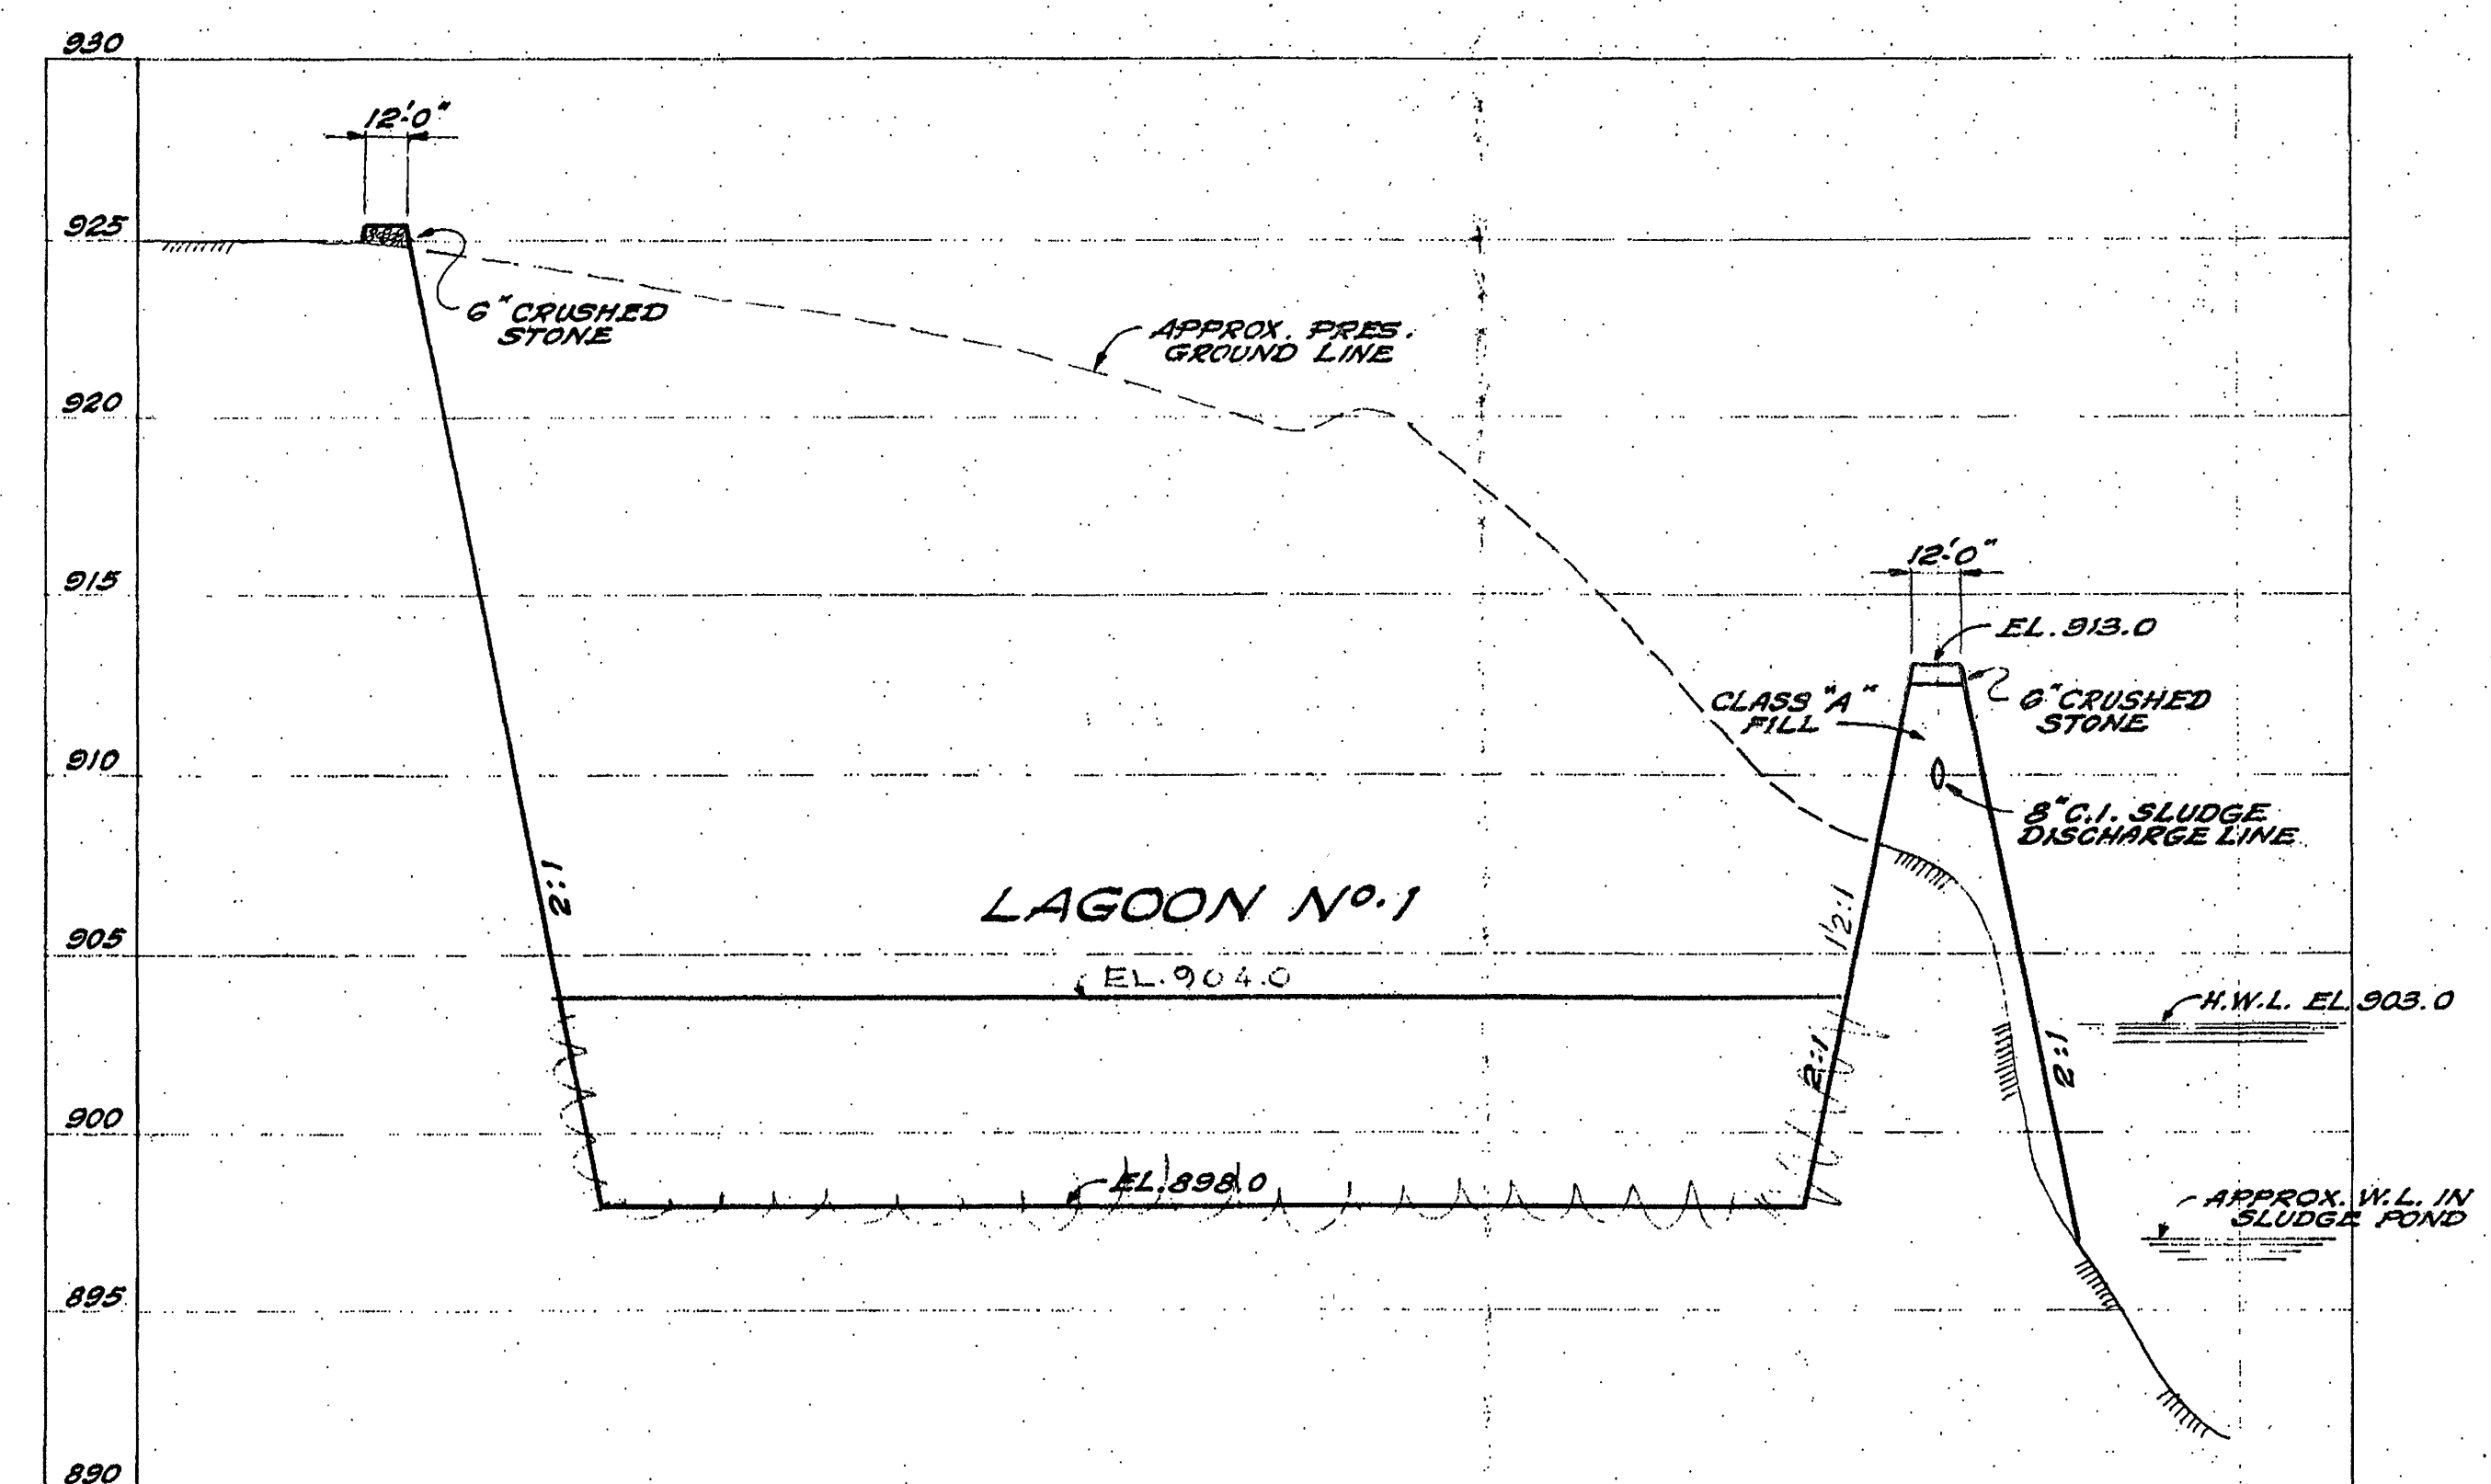

SECTION D-D
 SCALES: HORIZ. 1" = 50'
 VERT. 1" = 5'

AS BUILT

2

ADDITIONS TO SEWAGE TREATMENT PLANT
 ROANOKE, VIRGINIA

SLUDGE LAGOONS



ALFORD BURDICK & HOWSON
 ENGINEERS
 CHICAGO

1972